

DATE	
BY	
PLAN	
REVISIONS	
NO.	DESCRIPTION
1	
2	
3	
4	
5	
6	
7	
8	
9	
10	

DATE	
BY	
PROFILE	
REVISIONS	
NO.	DESCRIPTION
1	
2	
3	
4	
5	
6	
7	
8	
9	
10	

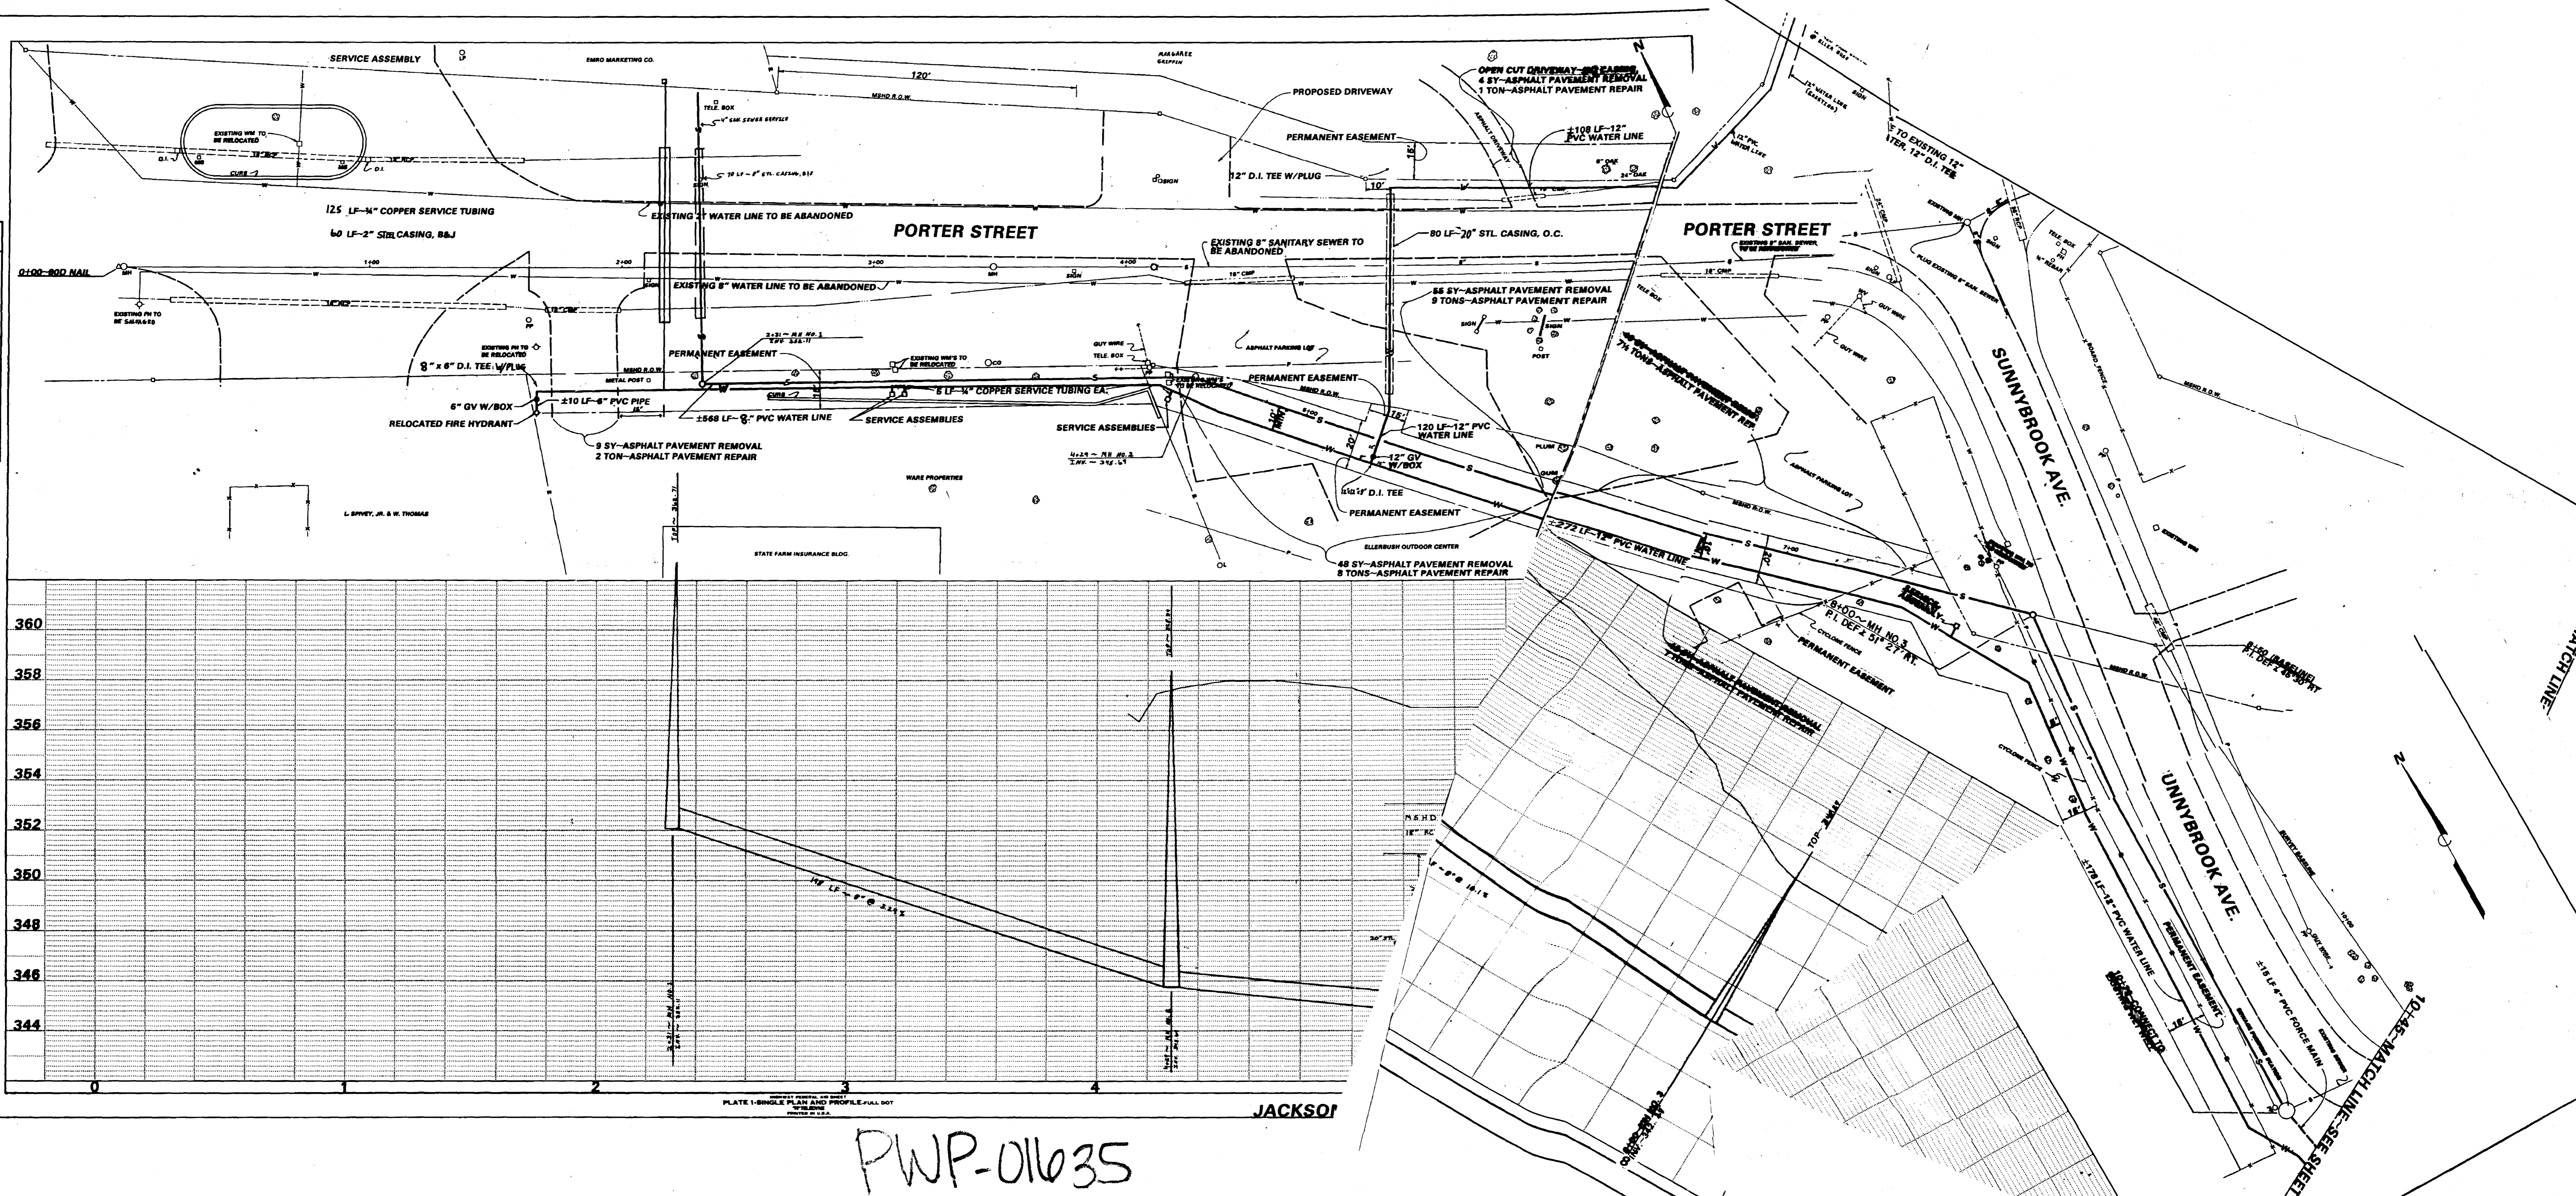


PLATE 1-SINGLE PLAN AND PROFILE-FULL DOT
 JACKSON

PWP-01635

10-45 MATCH LINE-SEE SHEET 5

MATCH LINE