


VICINITY MAP
SCALE 1" = 1000'

TOWN CENTER SQUARE
 Submission Name: TOWN CENTER SQUARE
 Owner/Developer: Great American Federal Savings & Loan
 1135 B Lela Drive
 Jackson, Mississippi 39216 1786
 Engineer & Designer of Plan: Robert B. Barnes, PE (Reg. No. 3391)
 1 Old River Place, Suite D
 Jackson, Mississippi 39216
 Date: March 29, 1989
 Location: NW 1/4 of the NW 1/4 of Section 32, T7N R2E,
 City of Ridgeland, Madison County, Mississippi
 Present Zoning: C1
 Area: 8.92 Acres

Robert B. Barnes

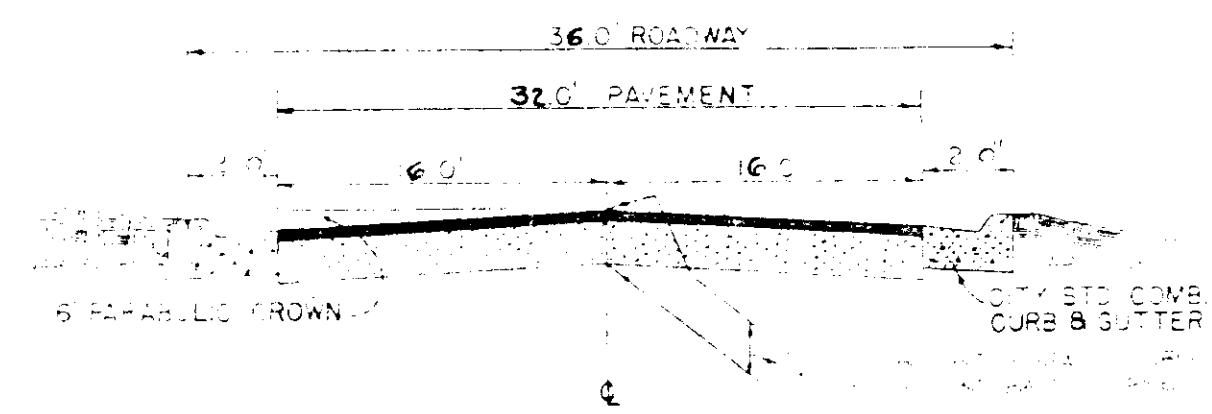

TYPICAL SECTION

EXISTING SAN MANHOLE


FILED THIS 11 DAY OF April 1989
 Knight
 CITY OF RIDGELAND

PWP-02000

ROBERT B. BARNES - CIVIL ENGINEER

SCALE: 1" = 30' DATE:

TOWNE CENTER SQUARE
 (Great American Federal S&L Project)

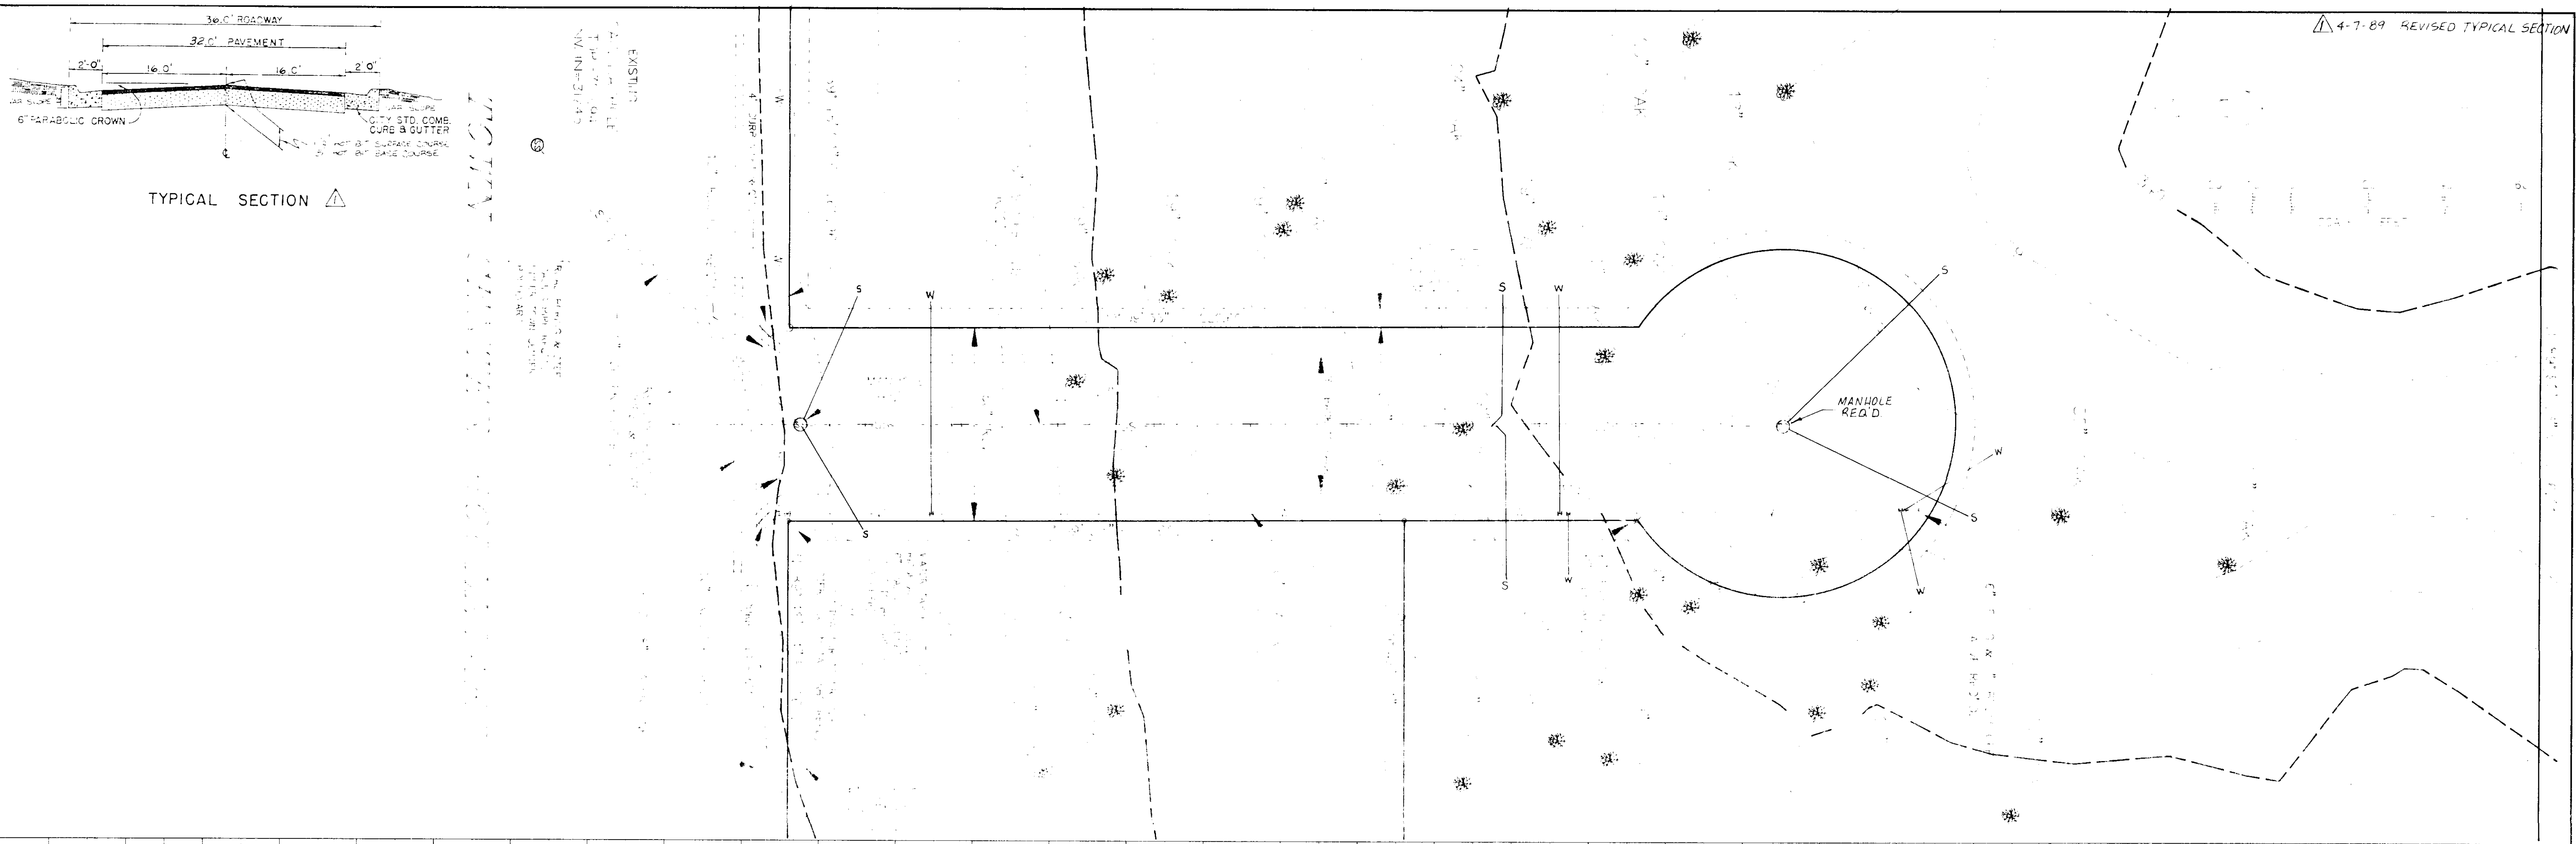

PLAN

DESIGNED	BY	
CHECKED	BY	
NOTED	BY	
NOTE BOOK	ALIGNMENT CHECKED	
	BY	
	NO. OF DAYS CHECKED	
	NO.	

PROFILE

DESIGNED	BY	
CHECKED	BY	
NOTED	BY	
NOTE BOOK	STRUCTURE NOTATIONS CHECKED	
	BY	
	NO.	

