
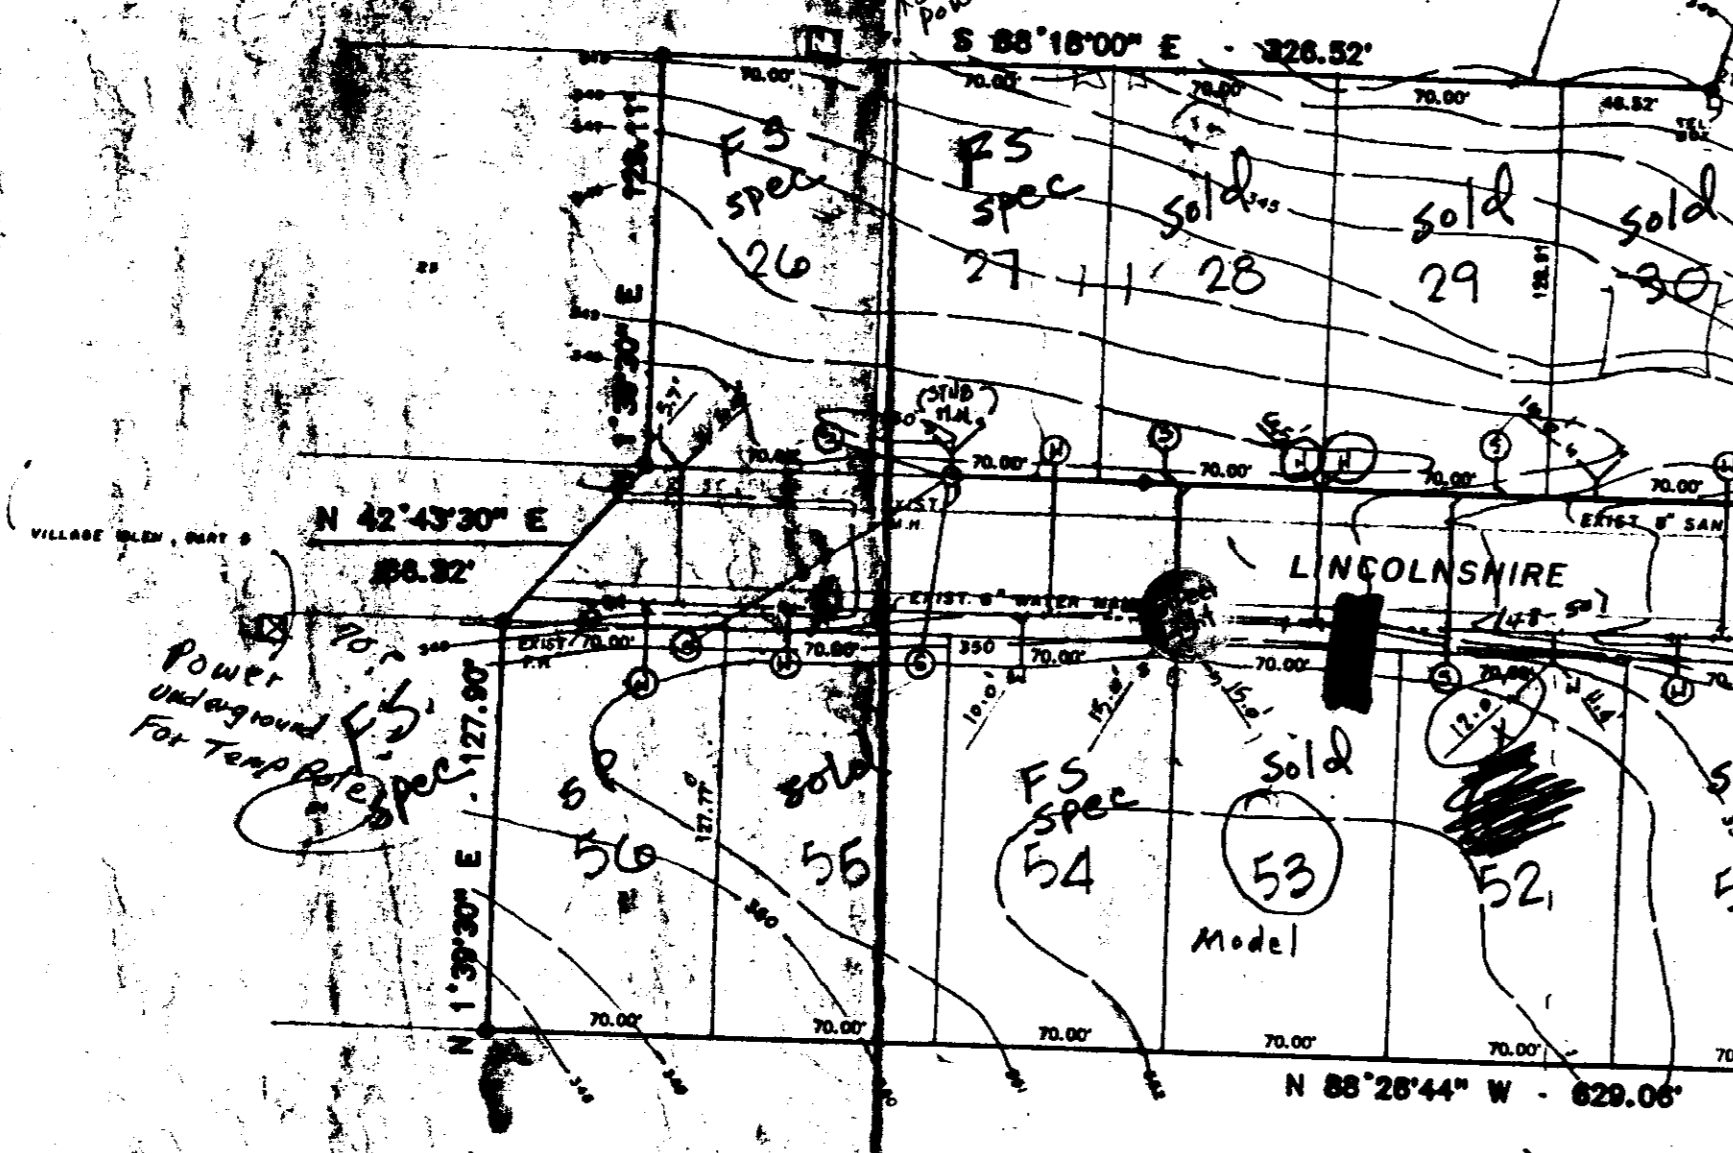


WATER AND SEWER SERVICES  
FOR VILLAGE GLEN PART IV  
RIDGELAND, MISSISSIPPI

Lot	Water Service	Sewer Service
26	Existing	Needed
27	Needed	Existing
28	Existing	Needed
29	Existing	Needed
30	Needed	Existing
31	Existing	Existing
32	Existing	Needed
33	Existing	Existing
34	Existing	Needed
35	Needed	Needed
36	Needed	Needed
37	Needed	Existing
38	Needed	Existing
39	Needed	Existing
40	Needed	Needed
41	Existing	Existing
42	Existing	Existing
43	Existing	Needed
44	Existing	Existing
45	Existing	Existing

Lot  
26  
27  
28  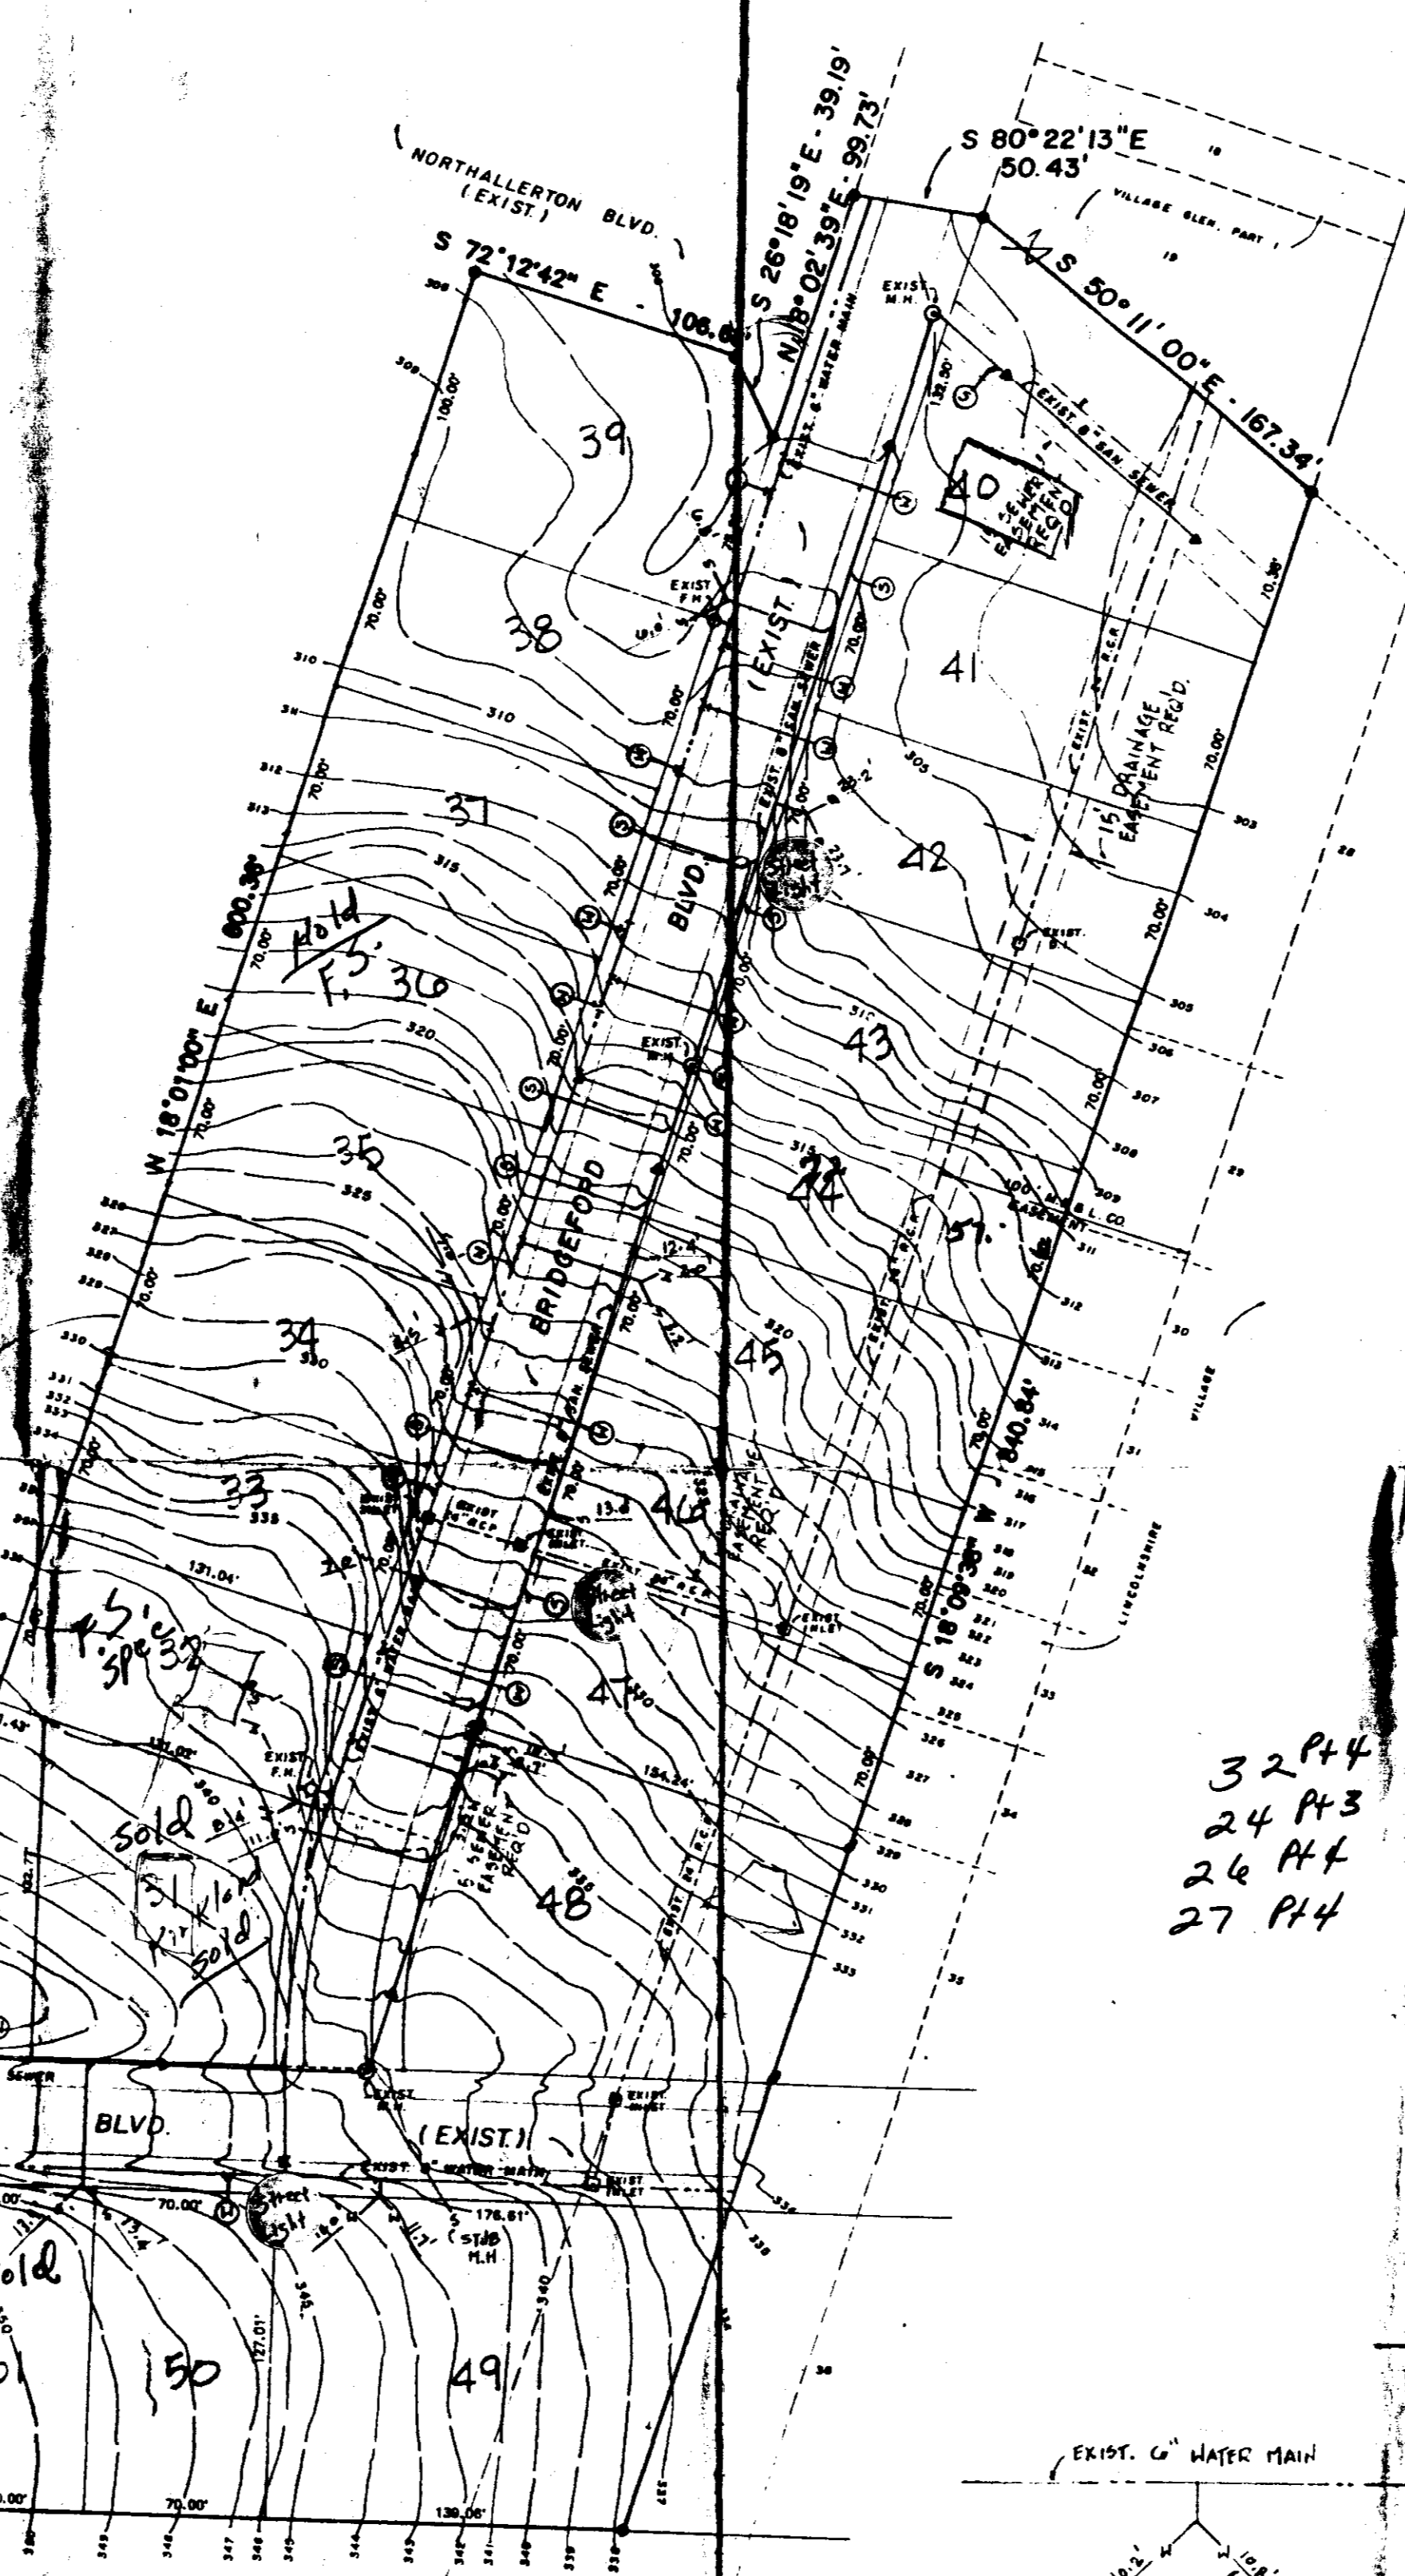
*Received \$25.00  
meter deposit 3-19-91  
Almyght*

*Stake  
for water  
on lot 52*


*M.P.E. Engineer -  
Kris Swane  
856-7047  
at Billy Pittman barnd  
910-308-1003 oob6  
Tampa*

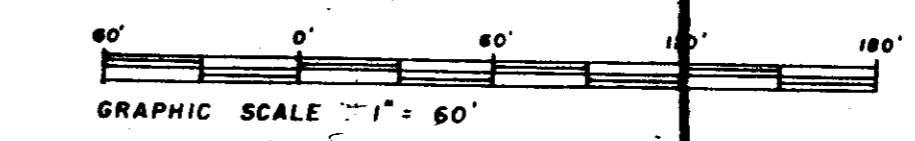

THIS PROPERTY IS SITUATED IN ZONE "C" ACCORDING  
TO F.L.R.M. MAP NO. 280228-0295, DATED 6-2-80.

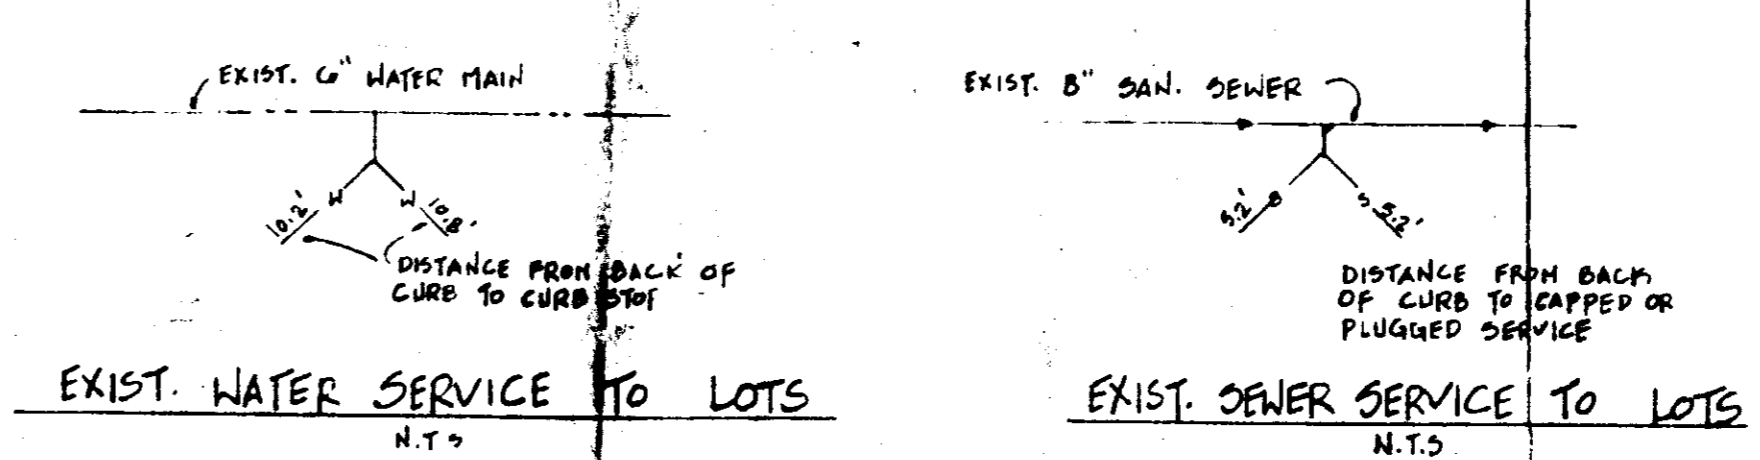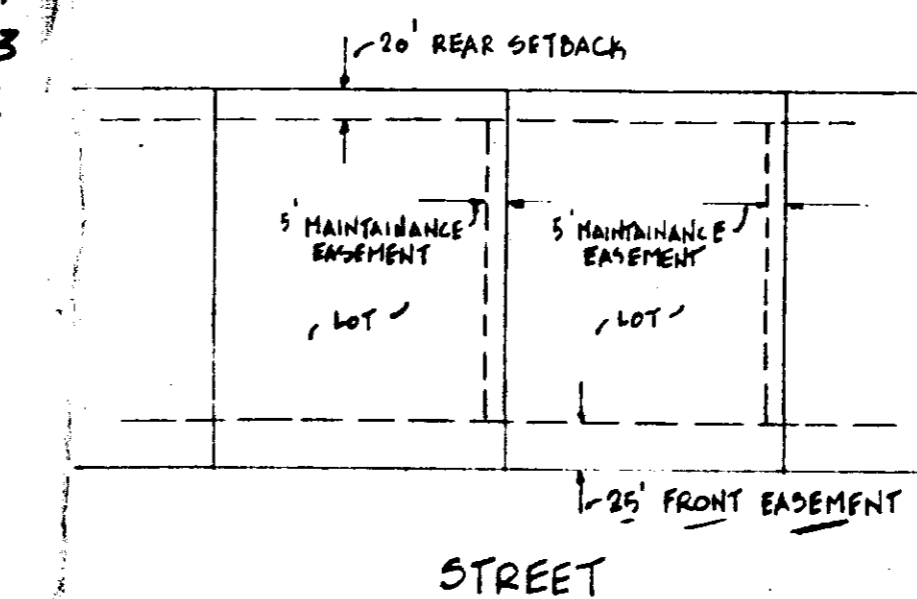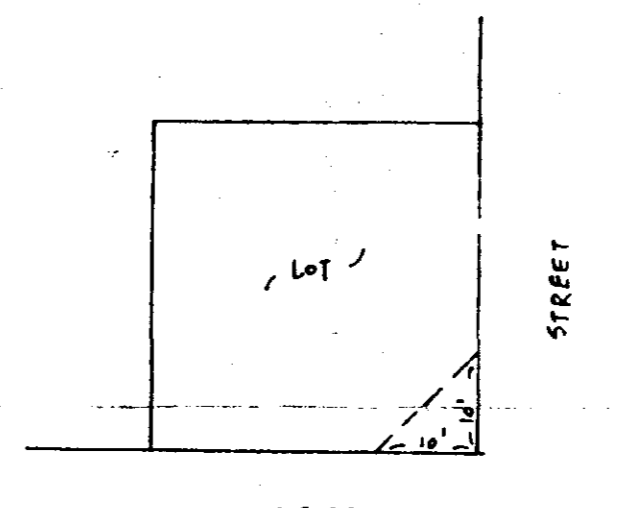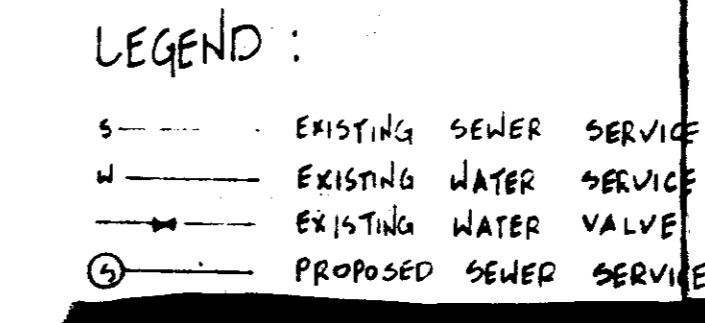

NOTE: WATER AND SEWER SERVICE LOCATIONS TAKEN FROM  
LOCATION OF EXISTING SERVICES DRAWING PREPARED BY ADVANCED  
DEVELOPMENTS INC., CONSULTING ENGINEERS, DATED: 10-12-78.

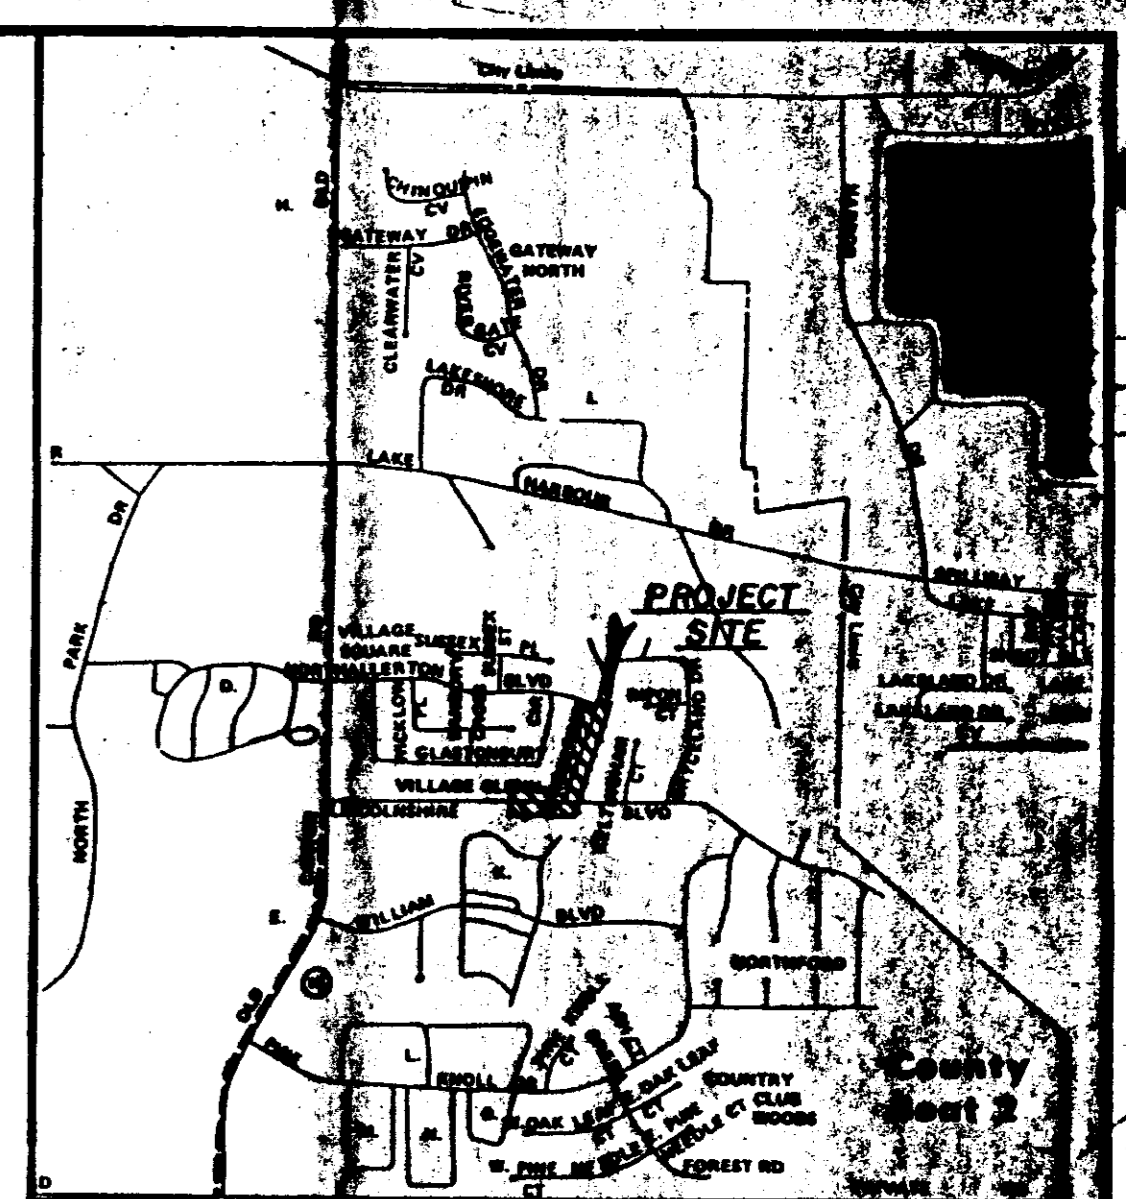

- GENERAL NOTES:
1. STREETS ARE EXISTING AND DEDICATED TO THE CITY OF RIDGELAND.
  2. SANITARY SEWER AND WATER MAINS SHOWN ARE EXISTING.
  3. CONSTRUCTION SHALL BE IN ACCORDANCE WITH CITY OF RIDGELAND CONSTRUCTION SPECIFICATIONS.
  4. LOT DIMENSIONS ARE APPROXIMATE.
  5. TOPOGRAPHIC SURVEY BY OTHERS.

DEVELOPED BY  
THE ESTATE OF BENNIE M. KIRKLAND, DECEASED  
JACK C. BOYLES EXECUTOR  
1907 DUNHARTON  
JACKSON, MISSISSIPPI.

PRELIMINARY  
PRELIMINARY PLAT  
VILLAGE GLEN, PART IV  
SITUATED IN NW 1/4 OF SECTION 33, T7N-R2E,  
CITY OF RIDGELAND, MADISON COUNTY, MS