


B.O.P. STA. 10+00

MATCHLINE STA. 23+50


MATCHLINE STA. 23+50

MATCHLINE STA. 37+50

- NOTE:
- IT SHALL BE THE RESPONSIBILITY OF THE CONTRACTOR TO COORDINATE ALL UTILITY RELOCATIONS WITH THE APPROPRIATE UTILITY COMPANY. UTILITY RELOCATIONS WILL BE CONSIDERED AN ABSORBED ITEM.
 - WATER MAINS WILL NOT BE CONSIDERED ELIGIBLE FOR PAYMENT UNTIL THE TRENCH HAS BEEN BACKFILLED AND THE ORIGINAL SURFACE HAS BEEN RESTORED TO THE FULL SATISFACTION OF THE ENGINEER.
 - ANCHOR COUPLINGS AND MEGA-LUGS ARE REQUIRED AT ALL DUCTILE IRON FITTING CONNECTION POINTS (ABSORBED ITEM).
 - FIRE HYDRANT ASSEMBLIES SHALL BE LOCATED ON THE ROAD SIDE OF ANY EXISTING FENCES, AND SHALL BE ORIENTED SO THAT THE MAIN NOZZLE IS FACING THE ROAD.

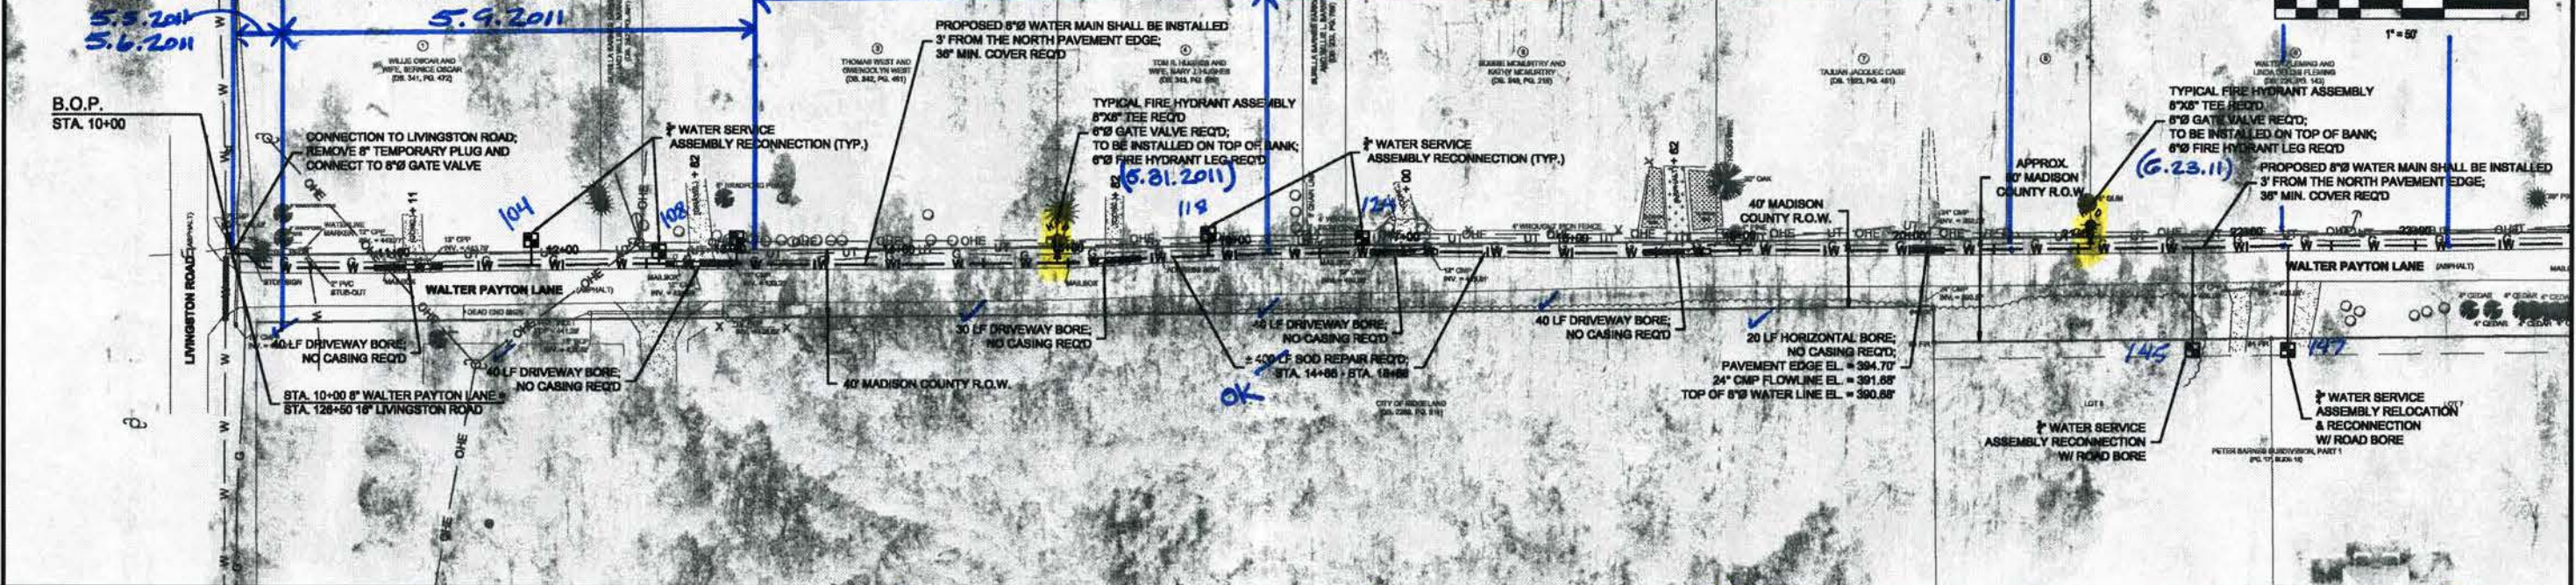

- NOTE:
- IT SHALL BE THE RESPONSIBILITY OF THE CONTRACTOR TO COORDINATE ALL UTILITY RELOCATIONS WITH THE APPROPRIATE UTILITY COMPANY. UTILITY RELOCATIONS WILL BE CONSIDERED AN ABSORBED ITEM.
 - WATER MAINS WILL NOT BE CONSIDERED ELIGIBLE FOR PAYMENT UNTIL THE TRENCH HAS BEEN BACKFILLED AND THE ORIGINAL SURFACE HAS BEEN RESTORED TO THE FULL SATISFACTION OF THE ENGINEER.
 - ANCHOR COUPLINGS AND MEGA-LUGS ARE REQUIRED AT ALL DUCTILE IRON FITTING CONNECTION POINTS (ABSORBED ITEM).
 - FIRE HYDRANT ASSEMBLIES SHALL BE LOCATED ON THE ROAD SIDE OF ANY EXISTING FENCES, AND SHALL BE ORIENTED SO THAT THE MAIN NOZZLE IS FACING THE ROAD.

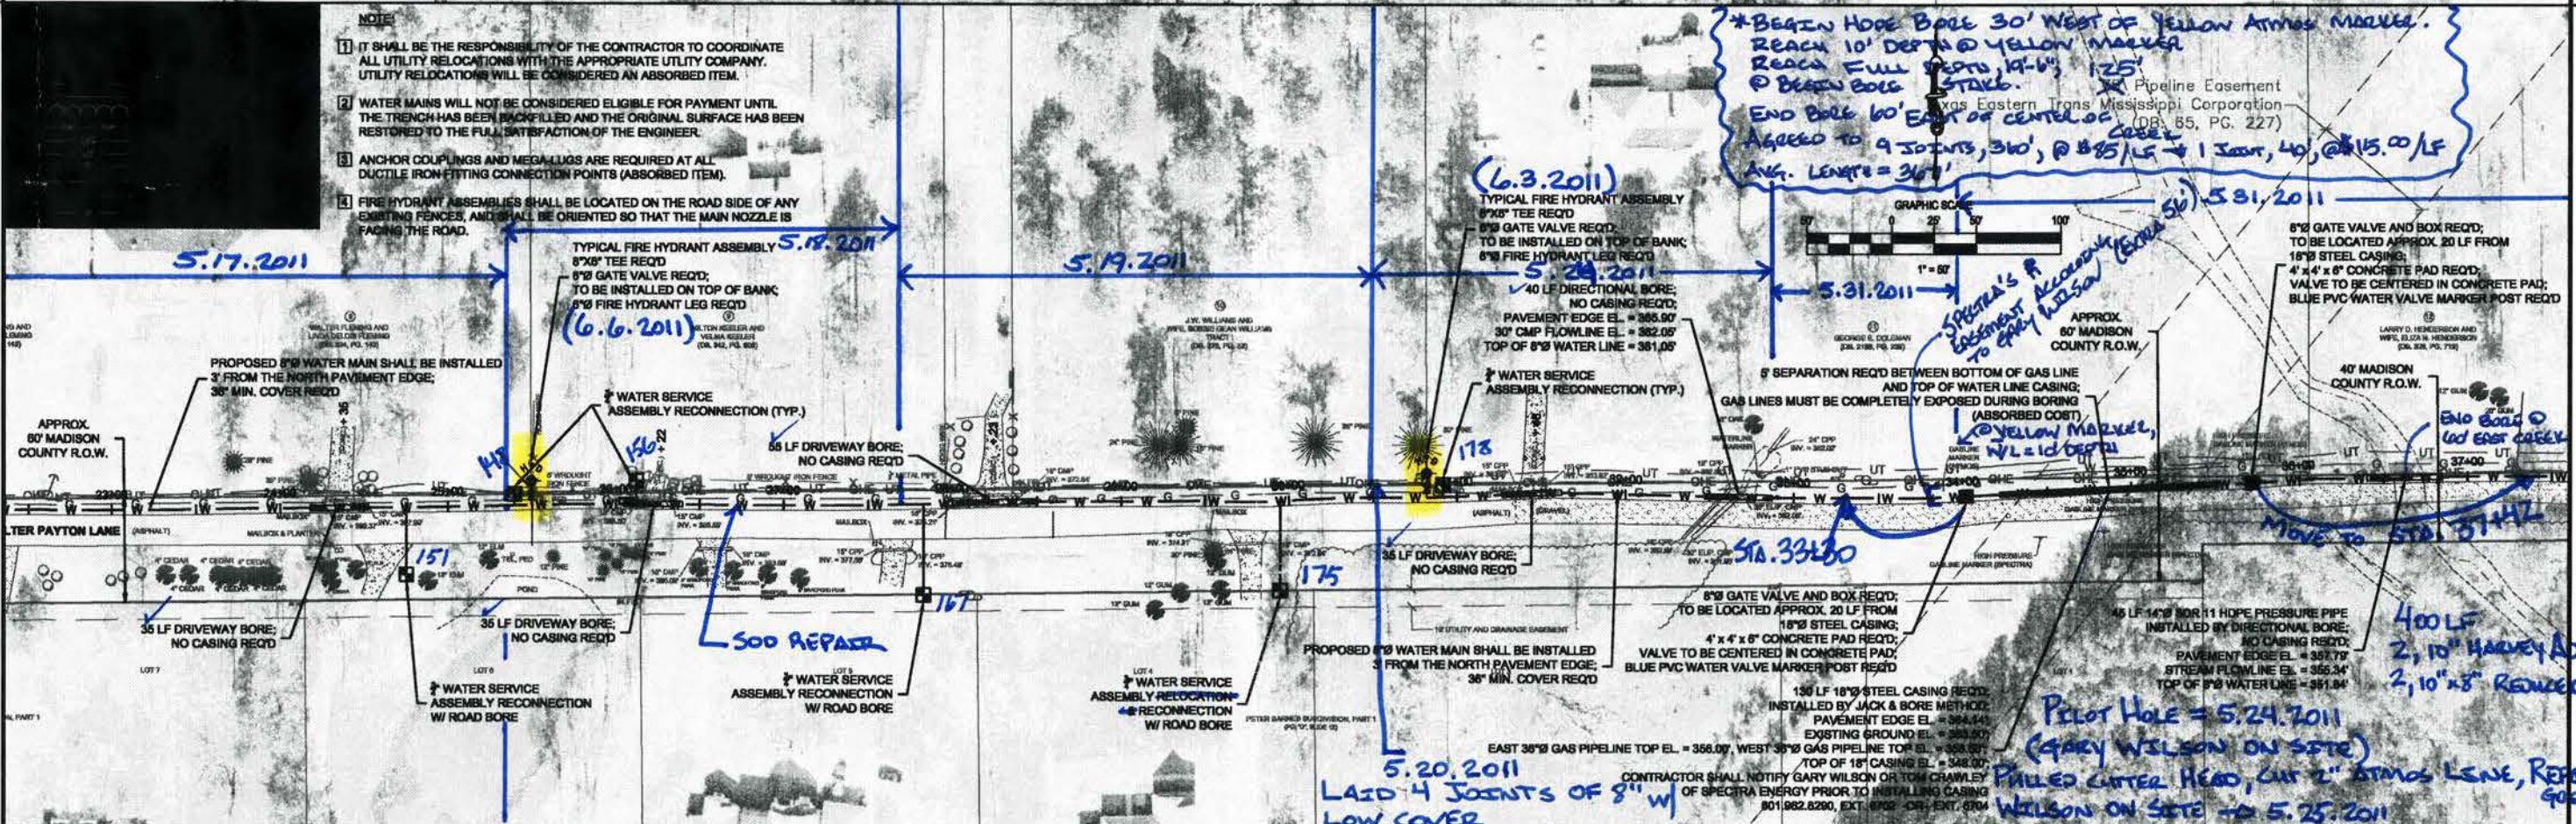


NO.	DATE	REVISIONS	BY	DATE	SCALE	PROJECT	LOCATION	DESCRIPTION	DATE	
				March 2011	1"=50'	WAGGONER	143-A LaFleurs Square JACKSON, MS 39211 601-355-9526 FAX 601-352-3945	WESTERN WATER SYSTEM IMPROVEMENTS PHASE I WATER MAINS CITY OF RIDGELAND, MS	WALTER PAYTON LANE WATER MAIN PLAN VIEW (B.O.P. STA. 10+00 TO STA. 37+50)	WP P1.0

6.6.2011
(43+65 - 44+07)

- NOTE:
- IT SHALL BE THE RESPONSIBILITY OF THE CONTRACTOR TO COORDINATE ALL UTILITY RELOCATIONS WITH THE APPROPRIATE UTILITY COMPANY. UTILITY RELOCATIONS WILL BE CONSIDERED AN ABSORBED ITEM.
 - WATER MAINS WILL NOT BE CONSIDERED ELIGIBLE FOR PAYMENT UNTIL THE TRENCH HAS BEEN BACKFILLED AND THE ORIGINAL SURFACE HAS BEEN RESTORED TO THE FULL SATISFACTION OF THE ENGINEER.
 - ANCHOR COUPLINGS AND MEGA-LUGS ARE REQUIRED AT ALL DUCTILE IRON FITTING CONNECTION POINTS (ABSORBED ITEM).
 - FIRE HYDRANT ASSEMBLIES SHALL BE LOCATED ON THE ROAD SIDE OF ANY EXISTING FENCES, AND SHALL BE ORIENTED SO THAT THE MAIN NOZZLE IS FACING THE ROAD.

MATCHLINE STA. 37+50

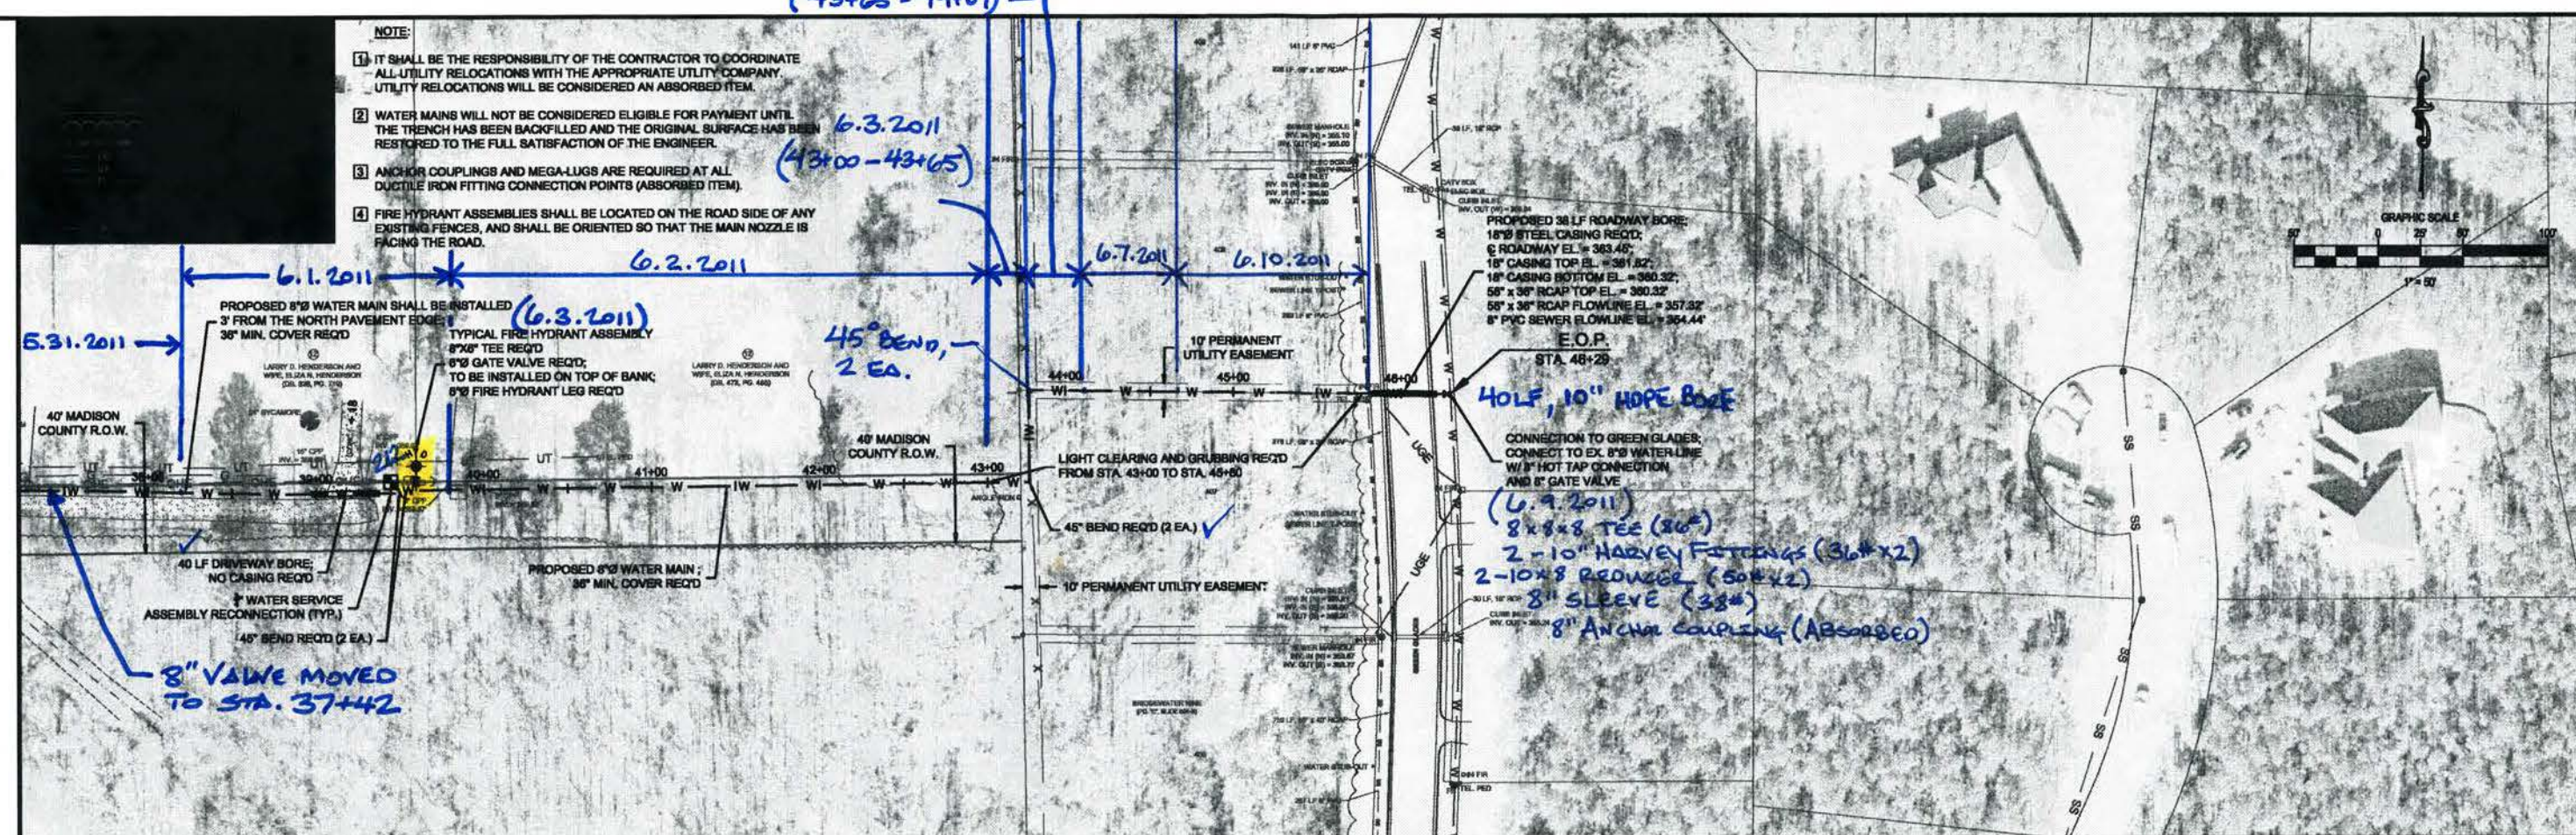

E.O.P. STA. 46+29

5.31.2011

8" PVC = STA. 38+18 - STA. 32+90 - 400 LF BORE = 123 LF
 10" HDPE = 367'
 2-8" VALVES
 2-10x8 REDUCER x 2 @ 50# EA.
 2 HARVEY ADAPTERS @ 36# EA. [INDEPENDENT PIPE PRODUCTS]

NO.	DATE	REVISIONS	BY	DATE	SCALE		143-A LeFleurs Square JACKSON, MS 39211 601-355-9526 FAX 601-352-3945	WESTERN WATER SYSTEM IMPROVEMENTS PHASE I WATER MAINS CITY OF RIDGELAND, MS	WALTER PAYTON LANE WATER MAIN PLAN VIEW (STA. 37+50 TO E.O.P. STA. 46+29)	WP P2.0
			CWB	March 2011	1"=50'					
			CWB							
			BGG	01/06/17	N/A					

