


CONSTRUCTION PLANS FOR:
THE WATERFORD ACCESS ROAD

STREET, DRAINAGE, MAJOR UTILITIES
 CITY OF RIDGELAND,
 MADISON COUNTY, MISSISSIPPI

NORTH

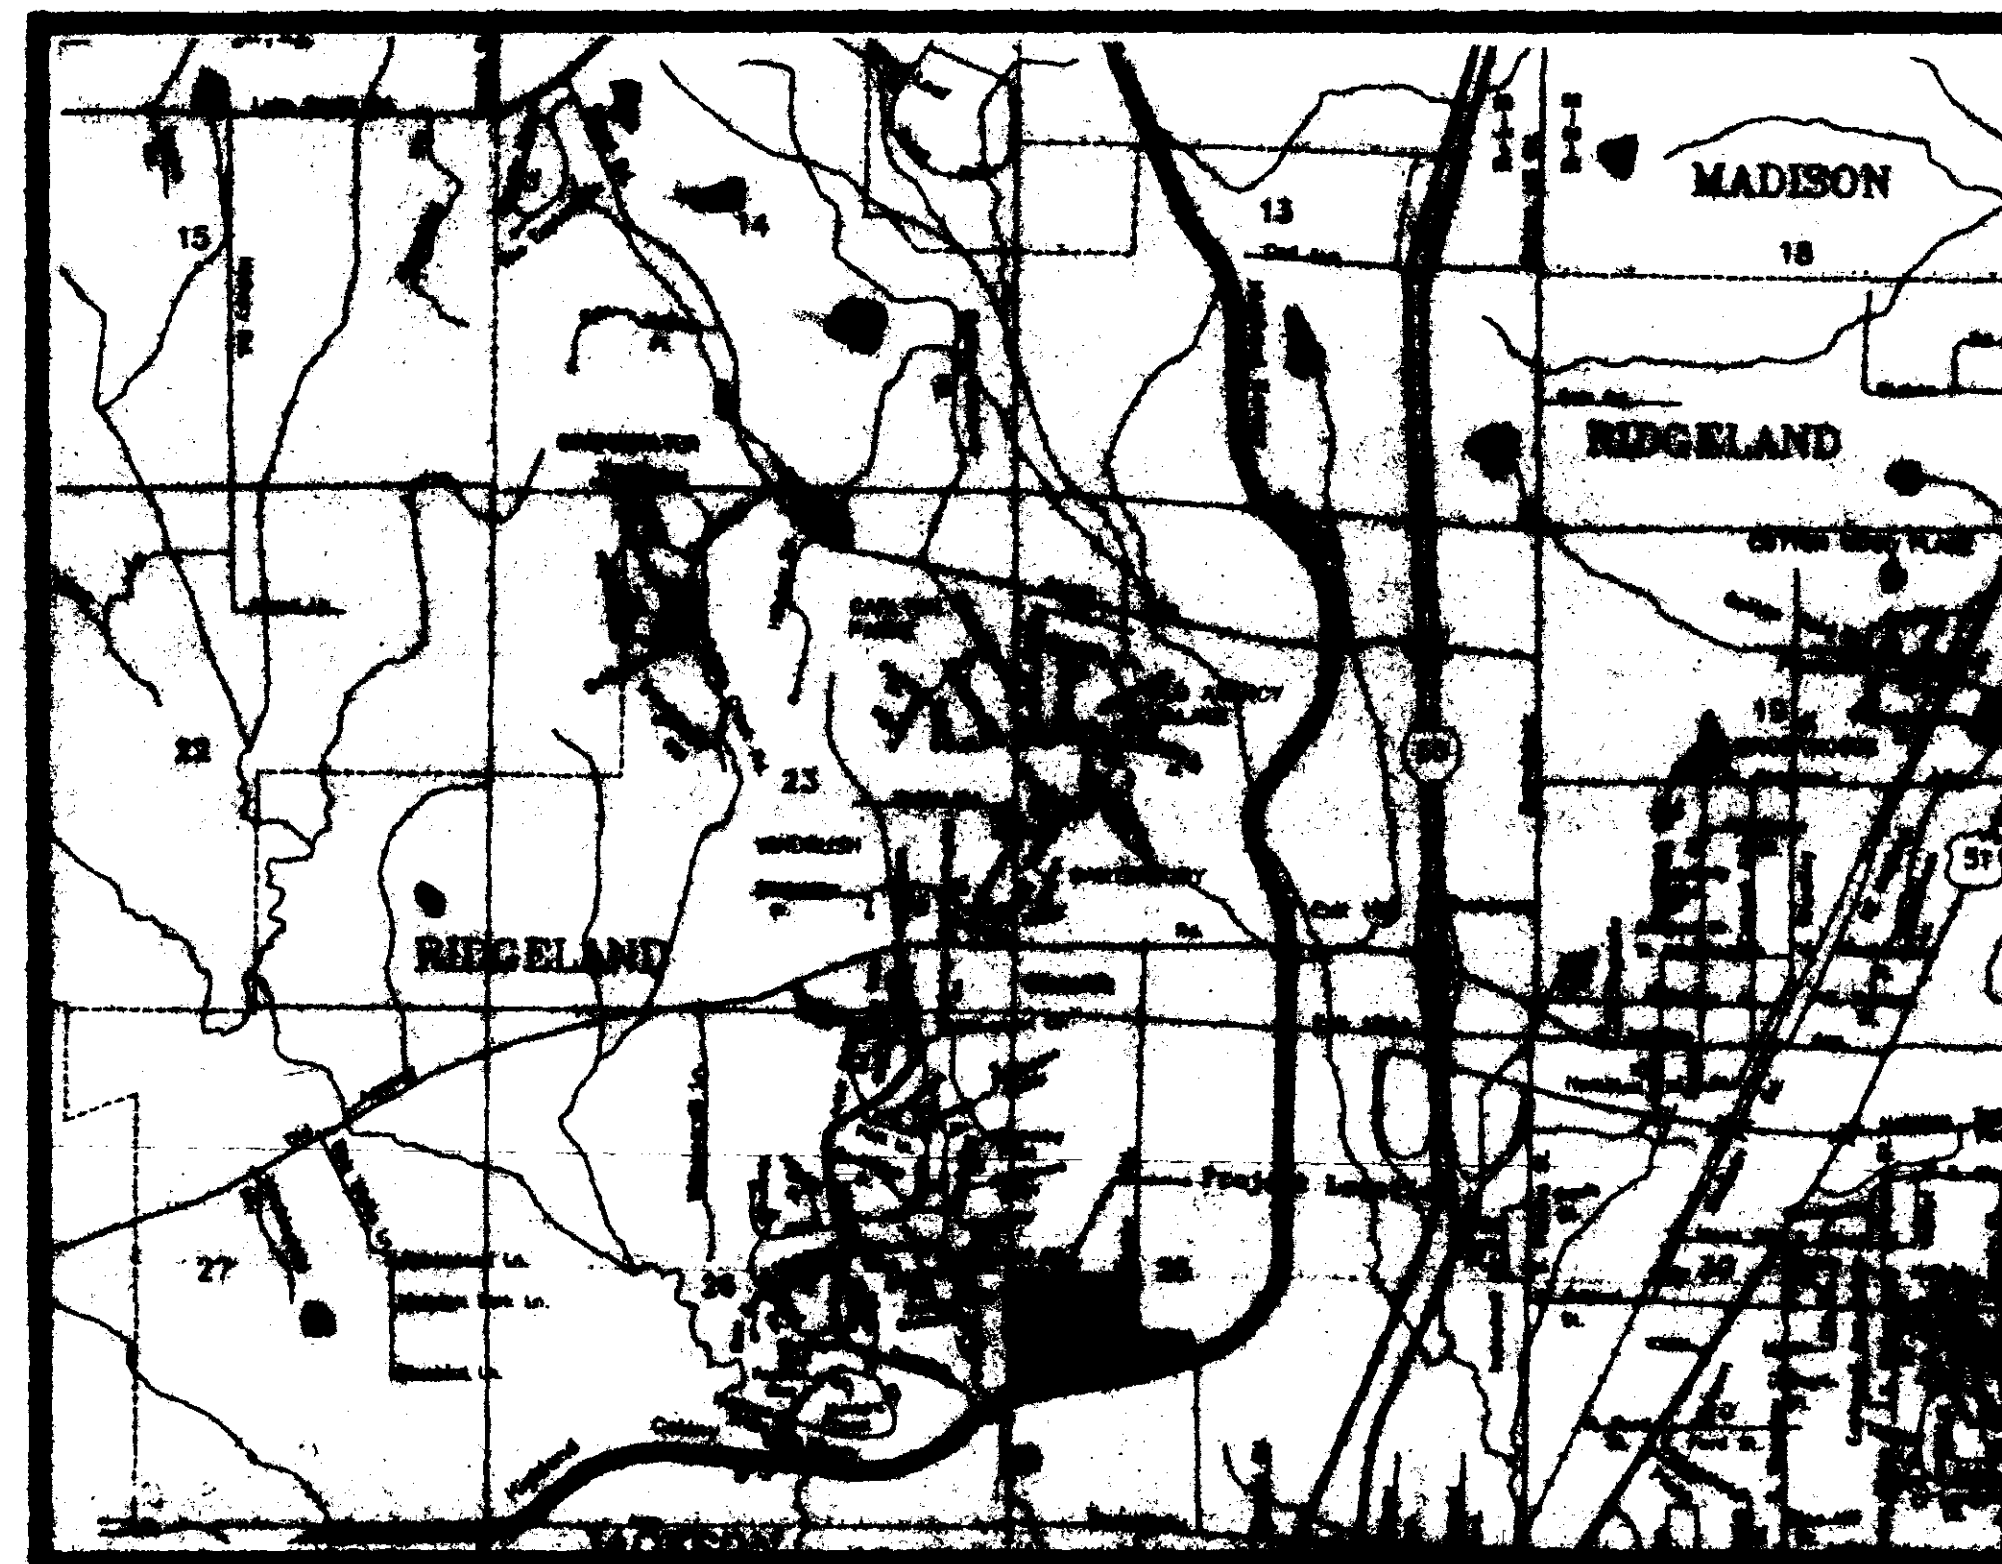

INDEX TO DRAWINGS

DESCRIPTION	SHEET
COVER, INDEX	1
TYPICAL SECTIONS & GENERAL NOTES	2
GEOMETRIC LAYOUT	3
UTILITY LAYOUT	4
WATER & SEWER LAYOUT	5
STORM DRAINAGE LAYOUT	6
EROSION CONTROL PLAN	7
STRIPING LAYOUT	8
SANITARY SEWER DETAILS	9
STORM DRAIN DETAILS	10
JUNCTION BOX FOR PIPE CULVERTS	11
STORM SEWER INLET (TYPE SS-3)	12
MISCELLANEOUS DETAILS	13
WATER DETAILS	14
PLAN / PROFILE	15

LOCATION MAP

PREPARED BY:

GC **GUEST CONSULTANTS, INC.**
 CONSULTING ENGINEERS & LAND SURVEYORS
 TWENTY SIX EASTGATE DRIVE • P.O. BOX 1225 • BRANDON, MS 39043
 TELEPHONE (601) 825-8341

JUNE, 2000

DEVELOPER:
JAMES L. PETTIS, III
 2026 SILVER LANE
 MADISON, MS 39110

OFFICE COPY

PLANS REVIEW

Public Works Director *sv*


Building Official

Traffic Engineer *W 6/1*

Drainage Engineer *BA 6-12-00*

Fire Official

Site plans will not go forward to the Architectural Review Board or the Mayor and Board of Aldermen prior to the above review.

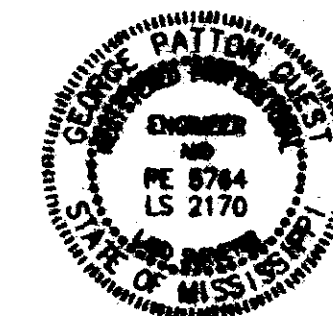


PWP-05042

Technical specifications for street and storm sewer construction for this project shall be the Construction details (Technical Specifications) of the Mississippi Standard Specifications for State Aid Road and Bridge Construction, 1989 Edition.

Equipment, Materials and Construction of Water Distribution System and Sanitary Sewer System shall conform to "UTILITY AND STREET CONSTRUCTION FOR THE WATERFORD ACCESS ROAD" A Separate Bound set of specifications by GUEST CONSULTANTS, INC.


If during construction the Engineer finds it necessary to change the lines, dimensions, thickness, grades, slopes, sections or quantities or if such changes are ordered for any other reason; the final quantities will be recomputed based on the plan changes, as a result of authorized changes.

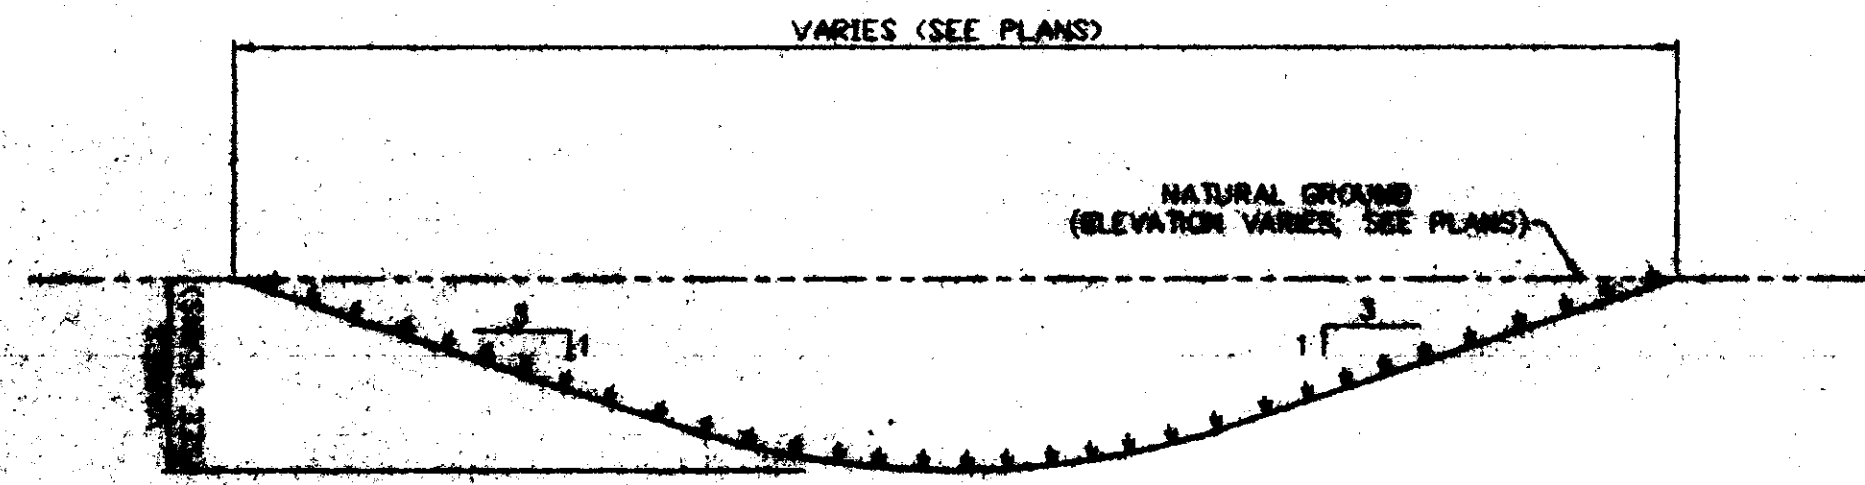

TYPICAL SWALE DITCH SECTION


N.T.S.

NOTE: SEE PLANS FOR ACTUAL LOCATION OF DITCH

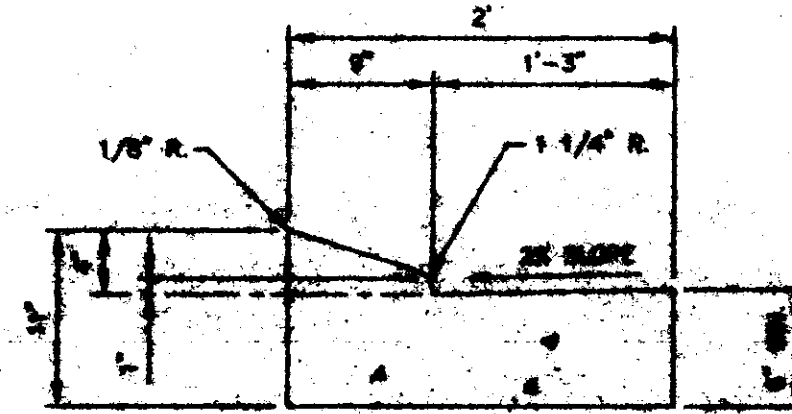


SECTION OF MOUNTABLE CURB AND OUTER

N.T.S.

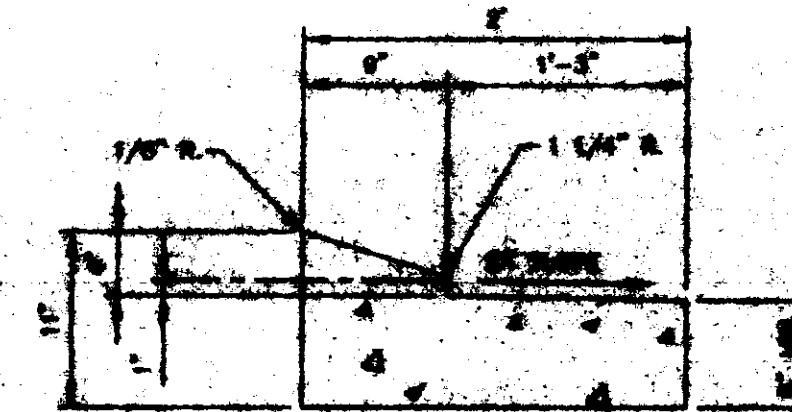


SECTION OF MOUNTABLE CURB AND GUTTER AT ISLAND MEDIANS

N.T.S.

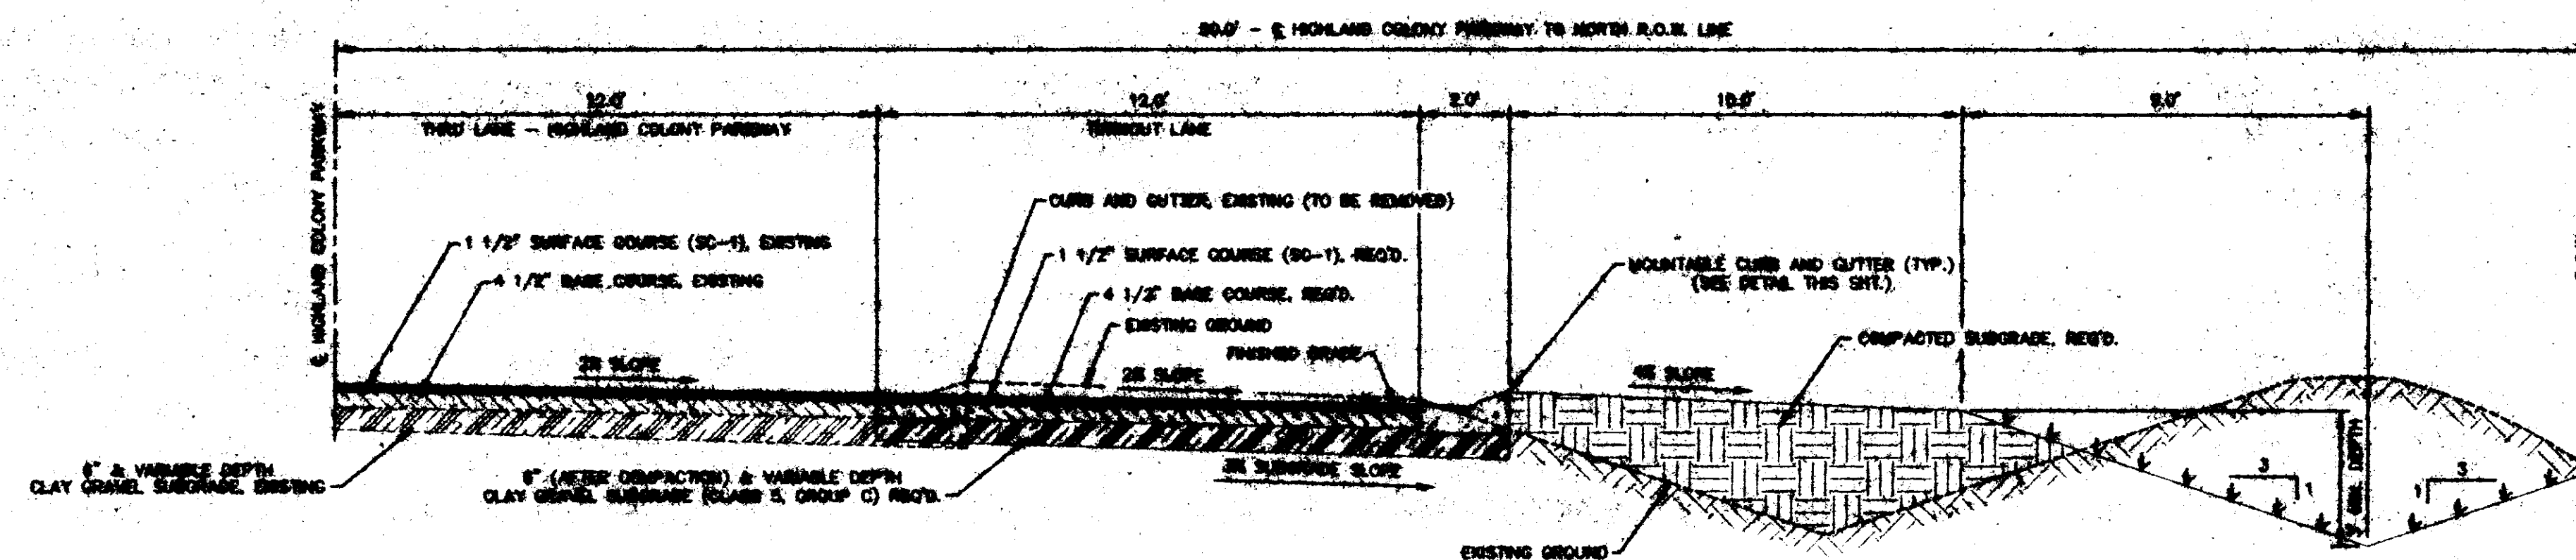

TYPICAL SECTION HIGHLAND COLONY PARKWAY DECELERATION LANE

SCALE: 1" = 3'

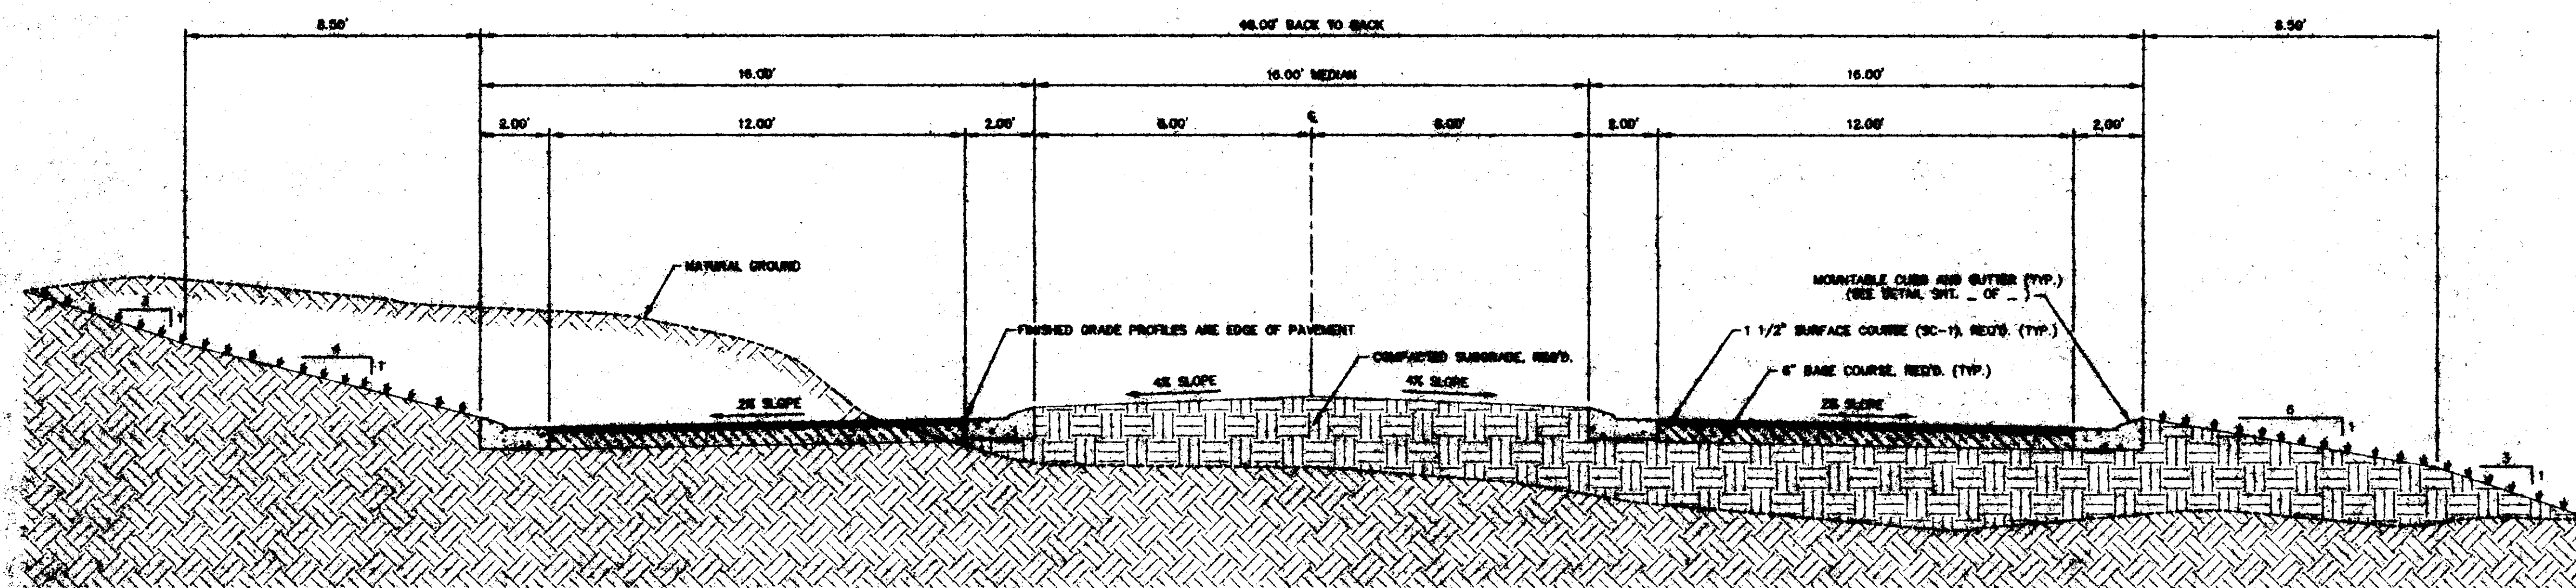


SECTION OF TYPICAL BOULEVARD

SCALE: 1" = 3'


GENERAL NOTES

- All work necessary shall be placed evenly on adjoining property as directed by the Engineer.
- Prior to placement of asphalt base, quality tests shall be performed by a separate laboratory of the contractor's option.
- The contractor is specifically cautioned that the location, width, depth, and slope of any ditch, swale, gutter, or curb shall be as shown on the plans. No alterations shall be made without the written approval of the Engineer. The contractor shall be responsible for the accuracy of the existing ground conditions and for the accuracy of the proposed improvements shown on the plans.
- Elevations are based on M.S.L. datum.
- Manhole tops and utility covers to be equipped on 24" size as necessary to match existing grade.
- Underpinning of existing material and building with exact bearing may be required as directed by the engineer.
- Stop signs and Street Signs not a Separate Pay Item. Cost to be absorbed in Other Items.
- Contractor shall comply with the requirements of the City of Raleigh Green Building Ordinance and the 2008 State Water Pollution Policy.
- Utility easements and elevations shall govern over local ordinances and elevations.
- The lengths of sanitary sewer lines shown on these drawings are the distances from center to center of manhole.
- Sanitary sewer lines shall be installed in accordance with the requirements of the City of Raleigh. The contractor shall be responsible for the accuracy of the existing ground conditions and for the accuracy of the proposed improvements shown on the plans.
- Sanitary sewer lines shall be installed in accordance with the requirements of the City of Raleigh. The contractor shall be responsible for the accuracy of the existing ground conditions and for the accuracy of the proposed improvements shown on the plans.
- Water and sanitary sewer systems shall be installed in accordance with the requirements of the City of Raleigh. The contractor shall be responsible for the accuracy of the existing ground conditions and for the accuracy of the proposed improvements shown on the plans.
- The contractor shall be responsible for the accuracy of the existing ground conditions and for the accuracy of the proposed improvements shown on the plans.
- Water service assemblies shall include all piping from the main to the meter box, tapping saddle, corporation stop, meter, yoke, and meter box and "No. 7" or "No. 8" Check Valve" meters to be supplied by the City of Raleigh.
- Contractor is required to take ground surface within right-of-way to grade shown on the typical sections prior to grading and installation of all work.
- All block walls of curb, gutter and junction basins shall be placed and finished and curbs with a 1:2 ratio of concrete mortar 1/2" thick.
- Class "B" structural concrete or precast may be used to construct basins in lieu of masonry.
- Concrete slab and covers for inlets and junction basins shall be class "B" structural concrete.
- Curb and gutter shall be 3000 PSI minimum concrete.
- Provide expansion joints with 3/4" expansion joint material at intervals of not greater than 30 feet for curb and gutter.
- Provide contraction joints in curb and gutter at intervals of not greater than 10 feet.
- Contractor shall comply with the latest editions of the City of Raleigh Ordinances or any other applicable ordinances for installation and working procedures. The contractor shall also comply with all applicable laws, codes, and other orders of government. The contractor shall not be held liable in, claims and suits from all construction and building. Contractor is responsible to comply with performance criteria for GMA.
- The contractor shall adhere to all terms & conditions as outlined in the General N.P.S.S. permit for storm water discharge associated with construction activity.
- After forms and/or curb and gutter slabs have been set and before concrete is placed, contractor shall verify that all gutters drain to inlets.
- Build pre-grade when there are no other structures or utilities in the area. The contractor shall be responsible for the accuracy of the existing ground conditions and for the accuracy of the proposed improvements shown on the plans.
- Prior to placing asphalt base, quality tests shall be performed by a separate laboratory of the contractor's option.

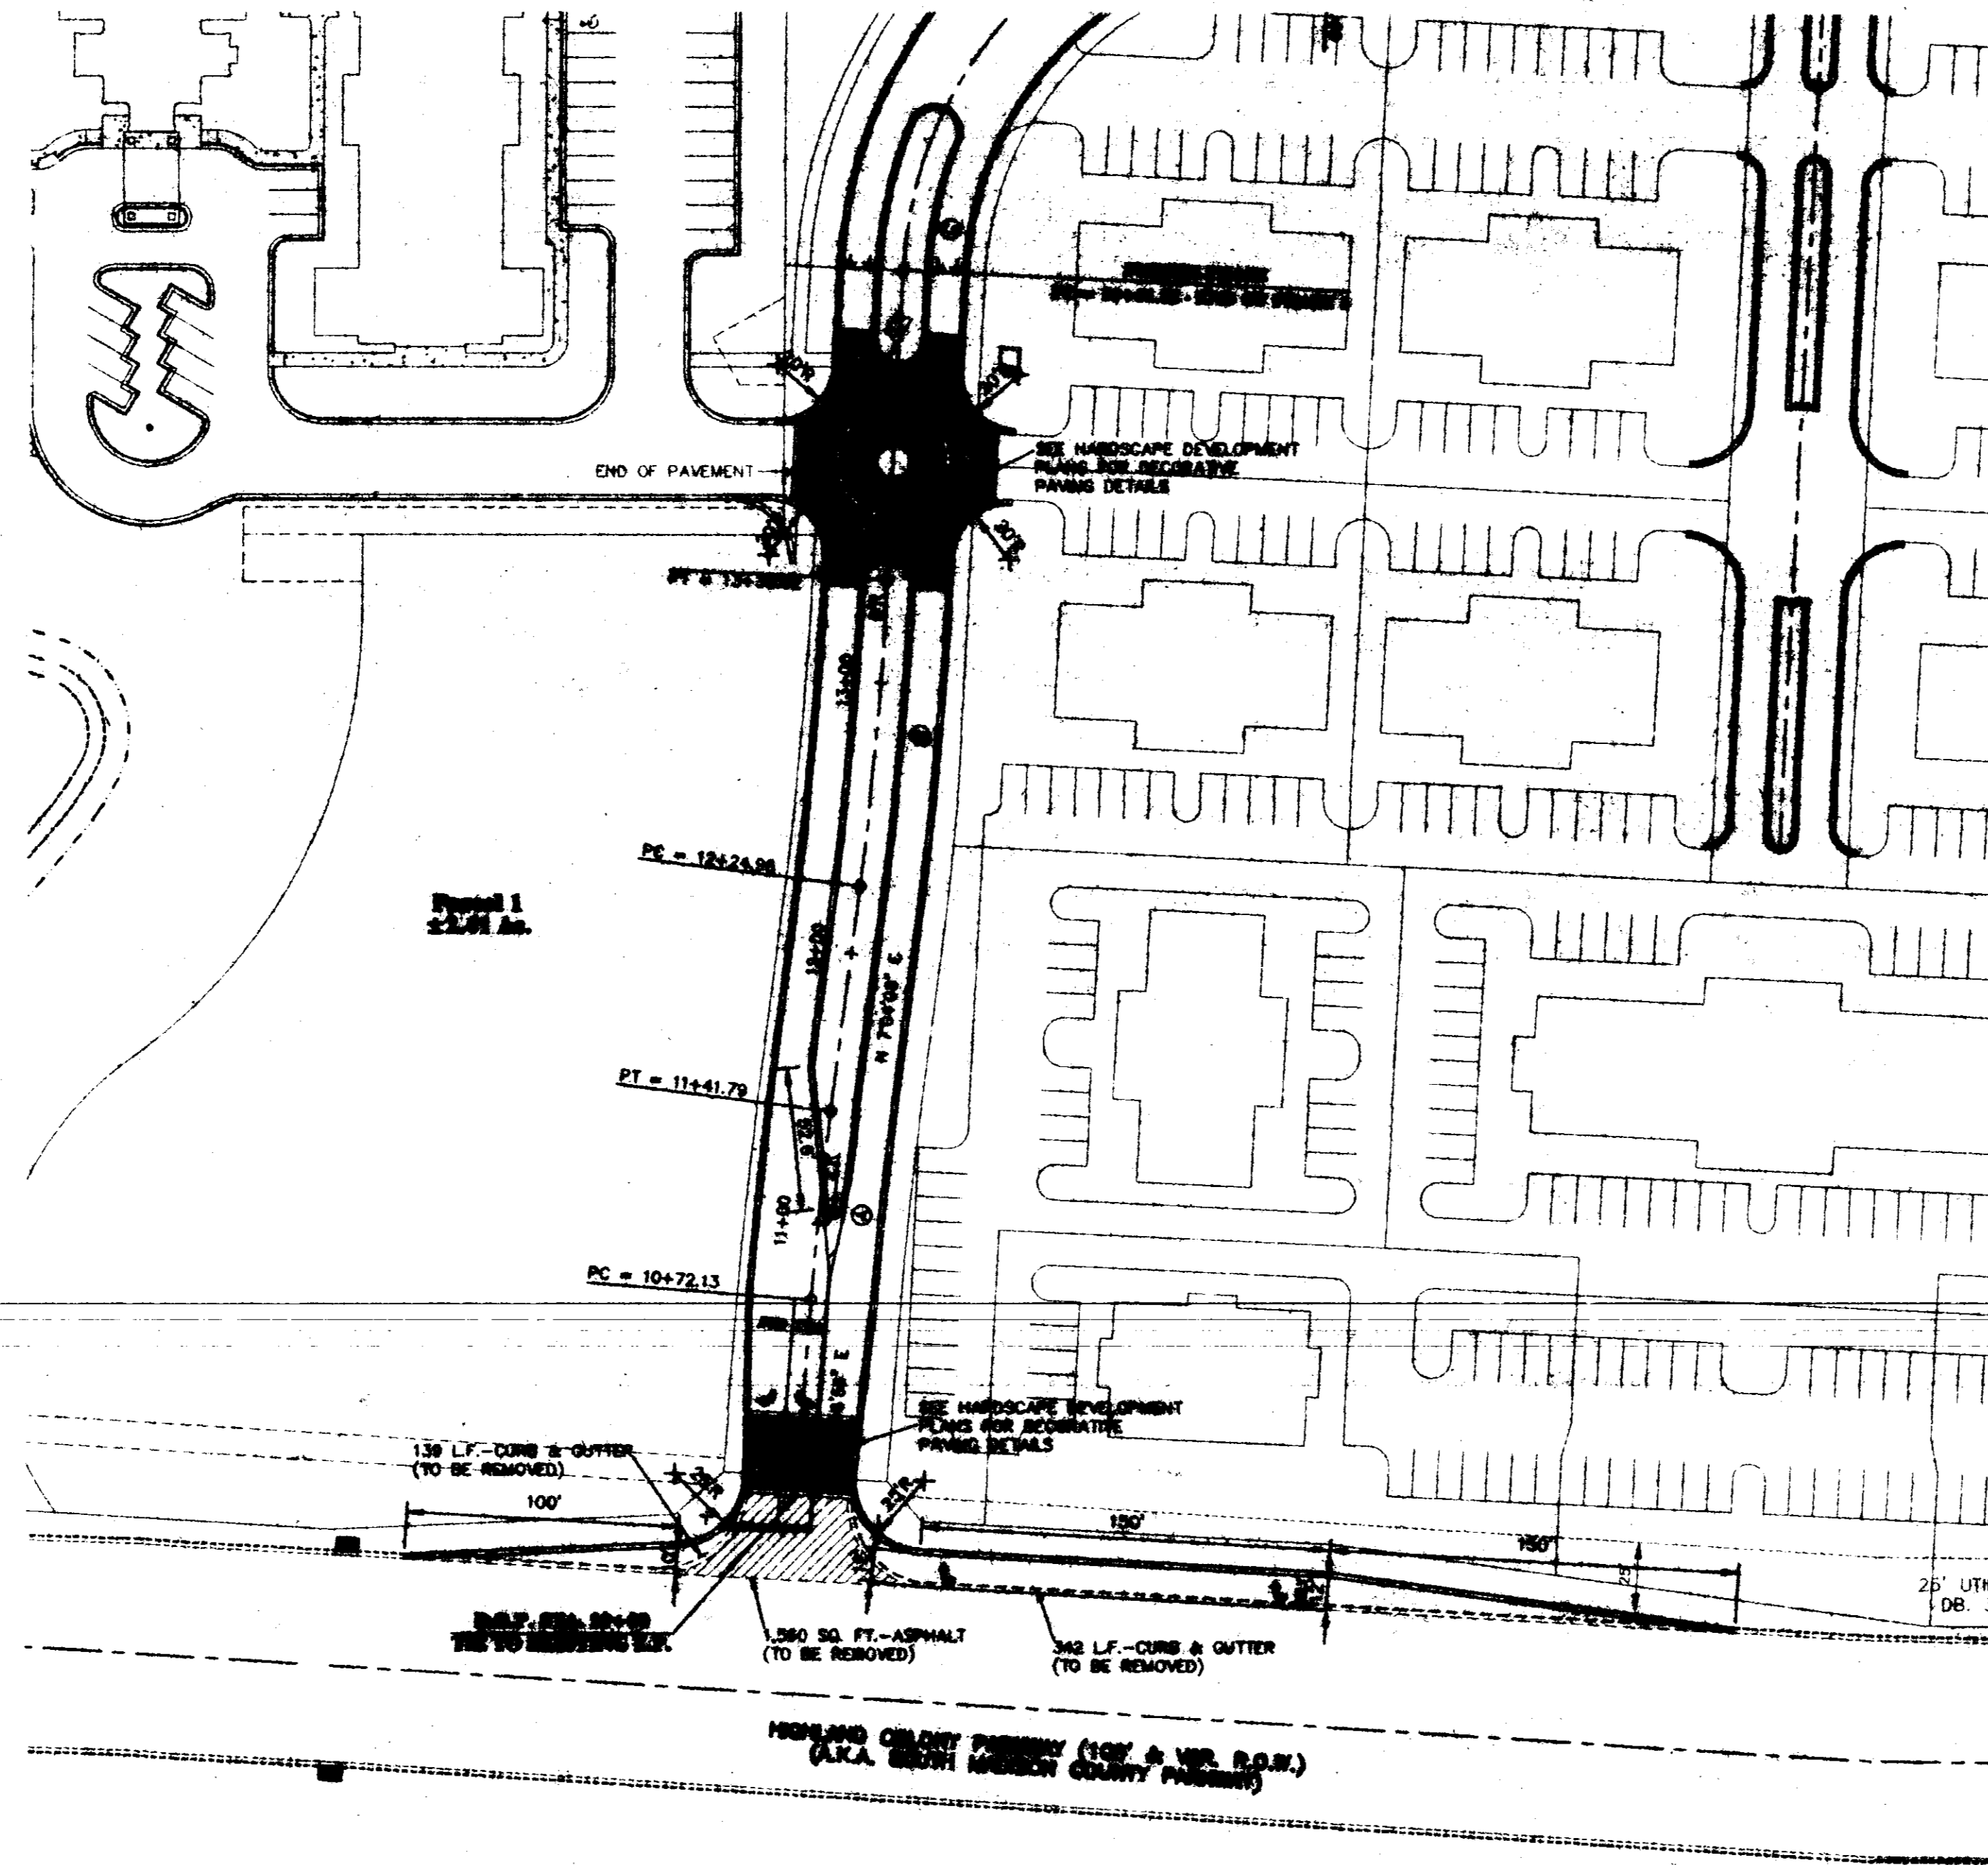

CURVE DATA

① Delta=02°47'11" R=1432.30' L=68.86' T=34.86' C=88.86' Brg=N 5°40'30" E	② Delta=04°31'22" R=1482.30' L=113.07' T=56.30' C=113.04' Brg=N 4°46'27" E	③ Delta=18°29'13" R=130.00' L=68.30' T=24.30' C=47.97' Brg=N 11°46'53" E
--	--	--

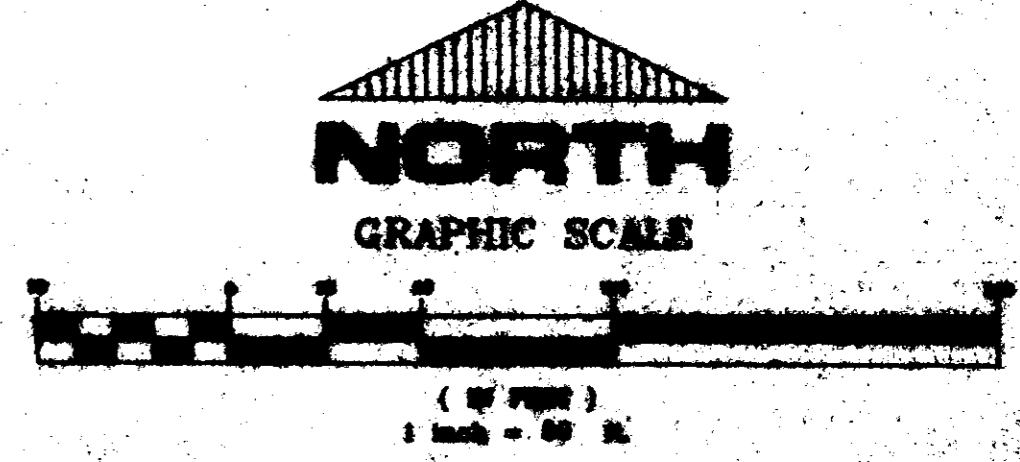


DATE: 02-01-99
 SHEET NO: 6-2738

Client: **Great Consultants, Inc.**
 CONSULTING ENGINEERS & LAND SURVEYORS
 TWENTY SIX SHERBORN DRIVE, 4TH FL. SUITE 4228 • BOSTON, MA 02043
 TELEPHONE (617) 888-8841 FAX (617) 888-3832


Project: **THE COMMONS, PHASE 1**

Geometric Layout

Sheet No: **3**

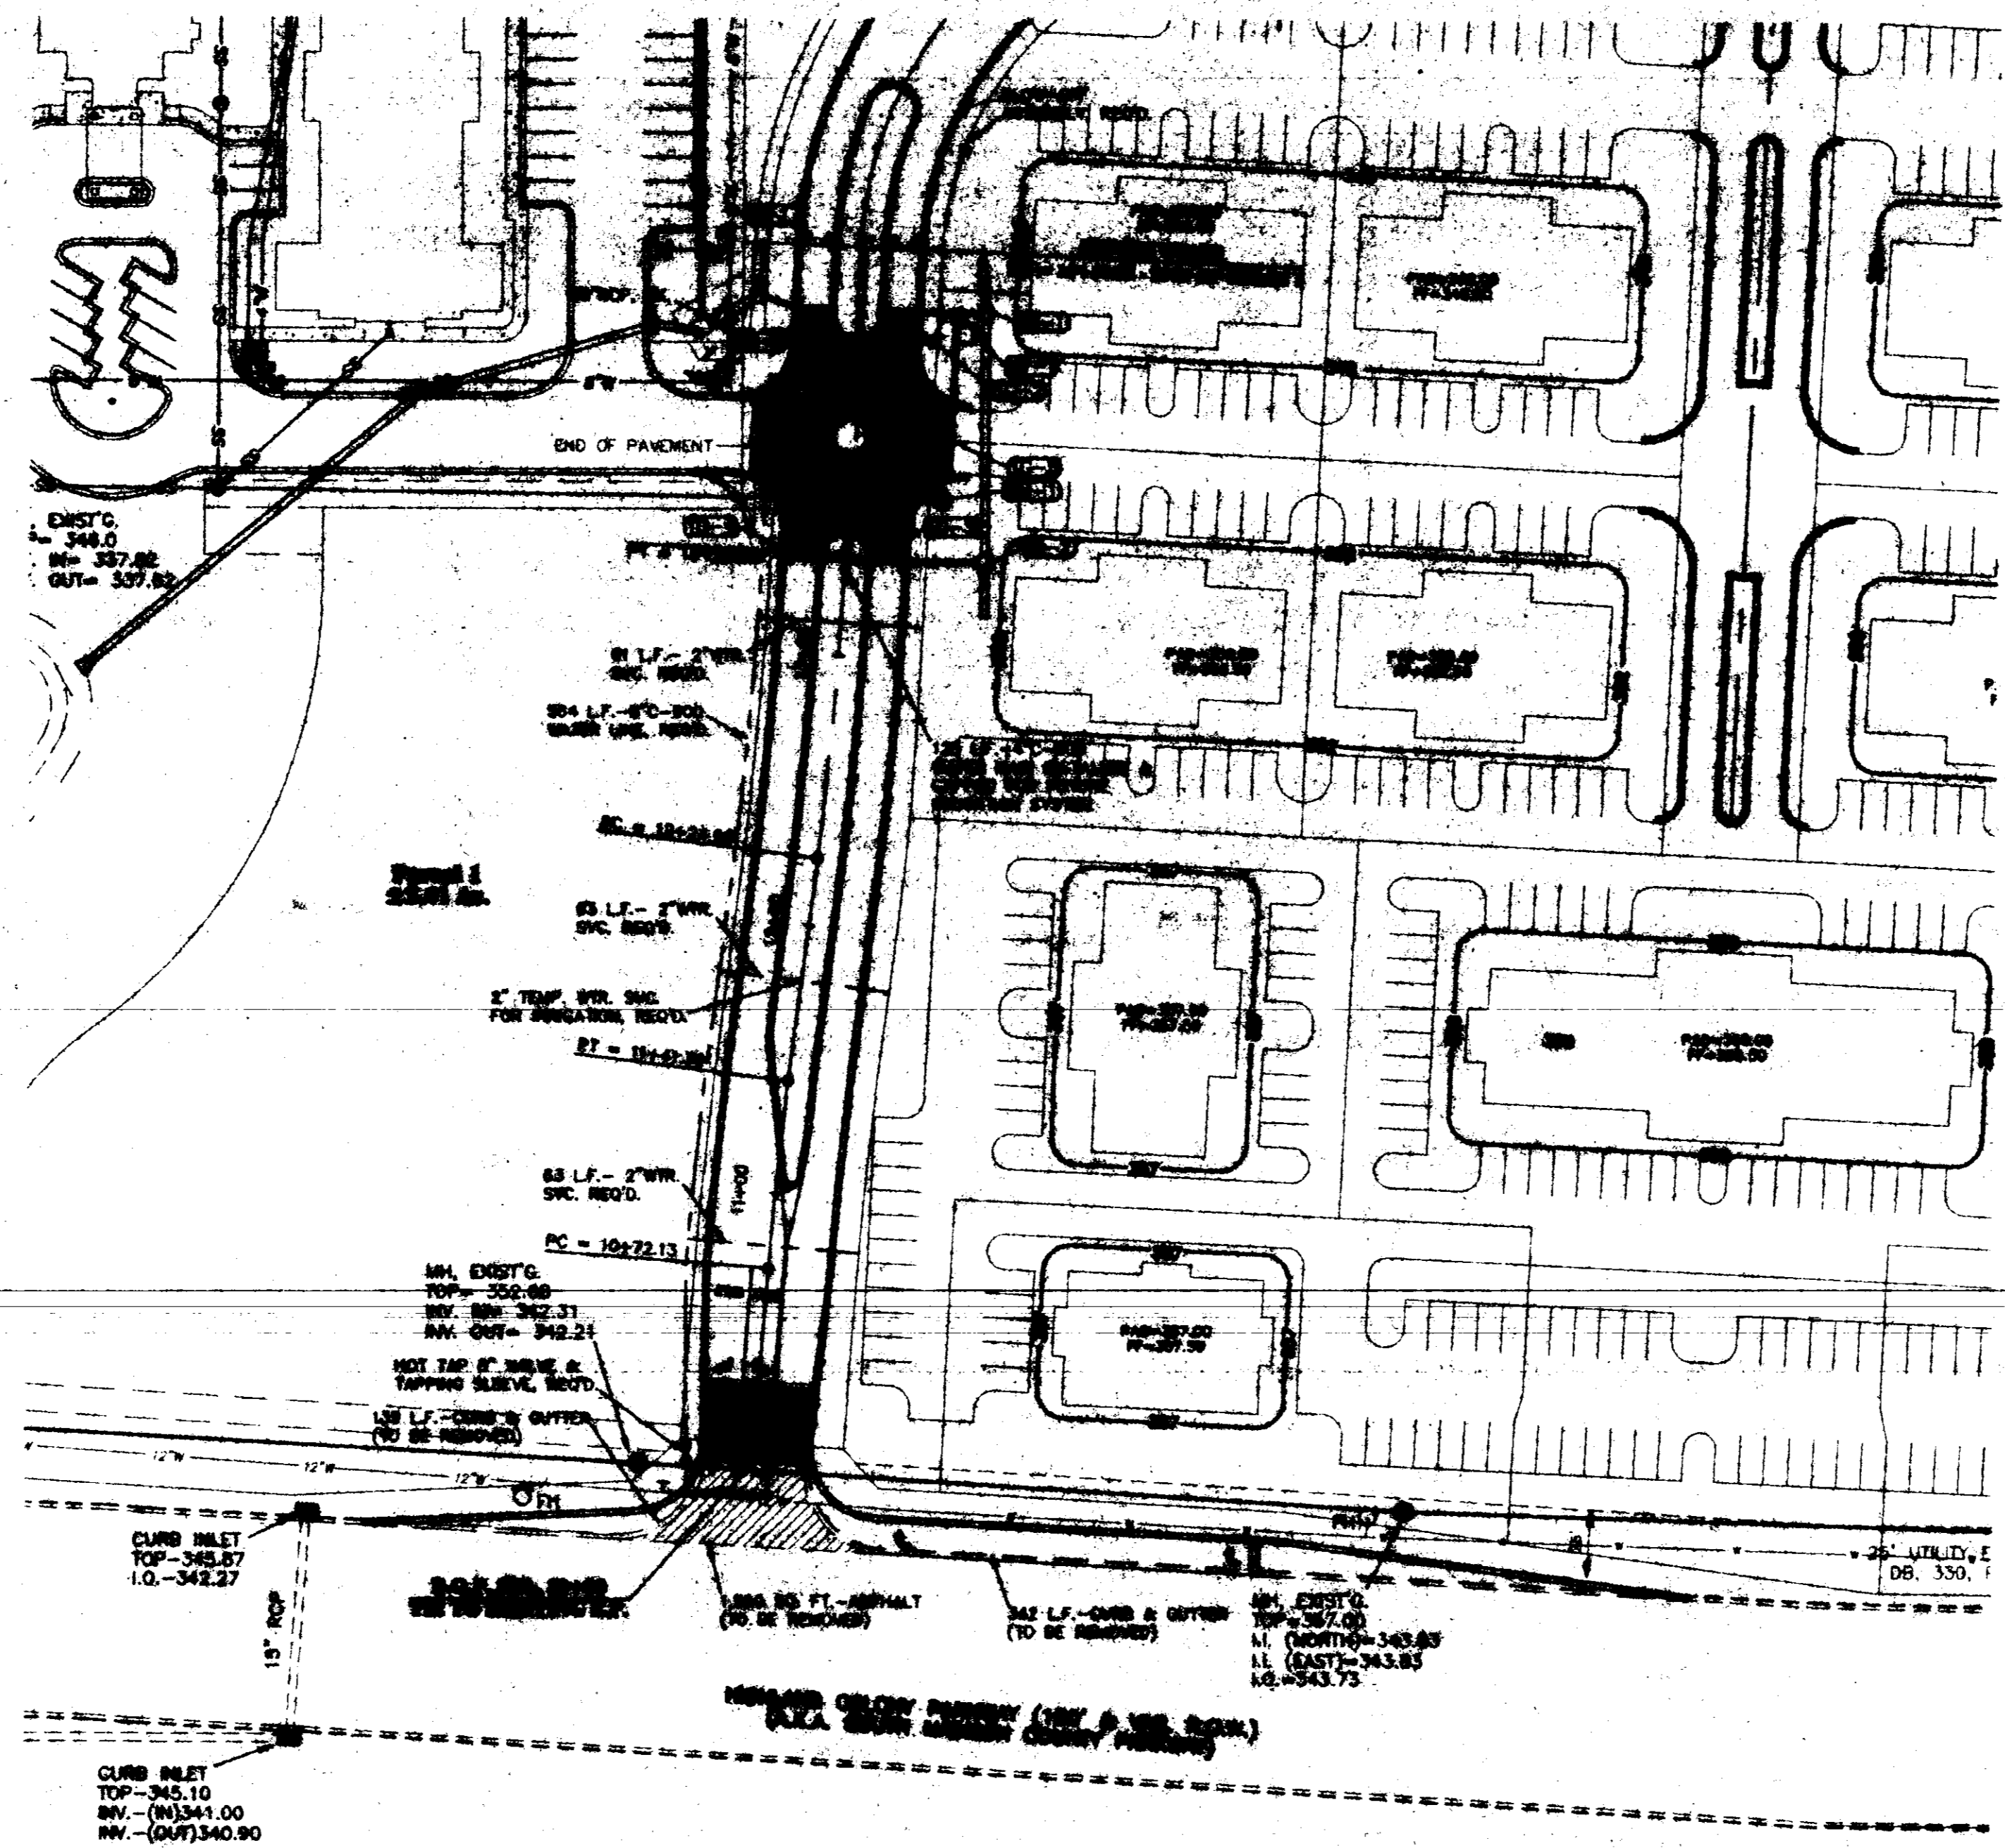



- NOTES:**
1. CONTRACTOR TO STUB 5" CONDUIT INTO MEDIAN FOR ELECTRICITY. COORDINATE LOCATION WITH ENTERY.
 2. CONTRACTOR TO COORDINATE HOT TAP CONNECTION FOR WATER MAIN WITH THE CITY OF RIDGELAND PUBLIC WORKS DEPARTMENT.
 3. ALL UTILITY CROSSINGS SHALL BE BACK FILLED IN 6" LIFTS AND COMPACTED TO 95 PERCENT PROCTOR DENSITY.

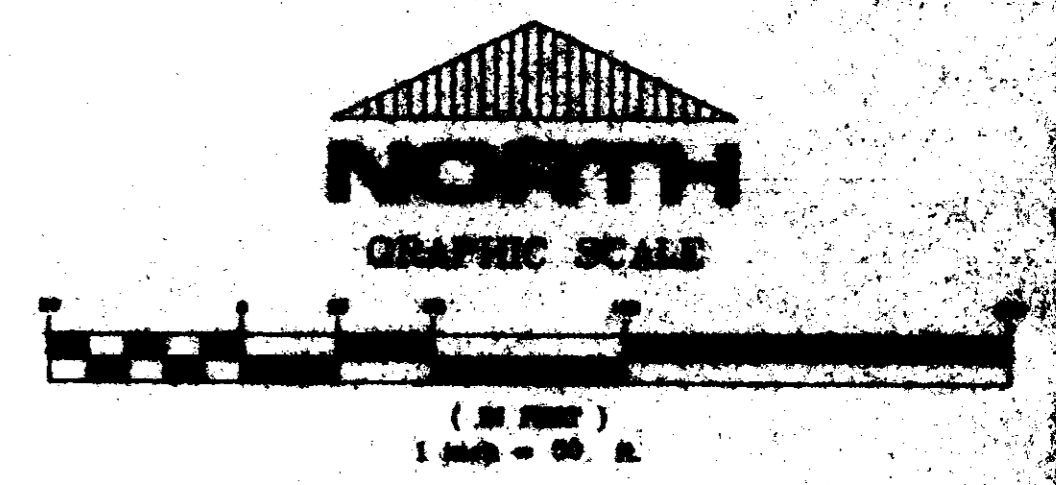

PROJECT NO. 00-00-00 DATE 02-28-00 SHEET NO. 00-00-00-001	DRAWN BY: P.M. WEST CHECKED BY: G. J. W.	PREPARED BY:	Grant Consultants, Inc. CONSULTING ENGINEERS & LAND SURVEYORS TWENTY SIX ESTATE DRIVE • P.O. BOX 7220 • BIOWASH, MS 38943 TELEPHONE (601) 828-8341 FAX (601) 828-3652	THE COMMONS, PHASE 1	UTILITY LAYOUT	SHEET NO. 4
---	---	--------------	---	-----------------------------	-----------------------	--------------------

EXHIBIT 10000-000000-0000

MH-1
STA. = 61+25.13
TOP = 348.86
INV. OUT = 338.89
BOTTOM = 338.79
DEPTH = 7.17

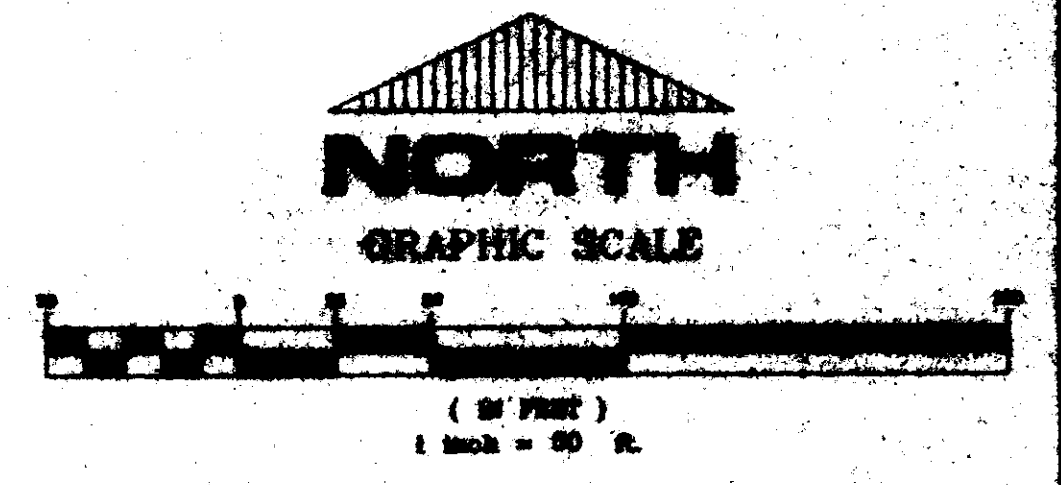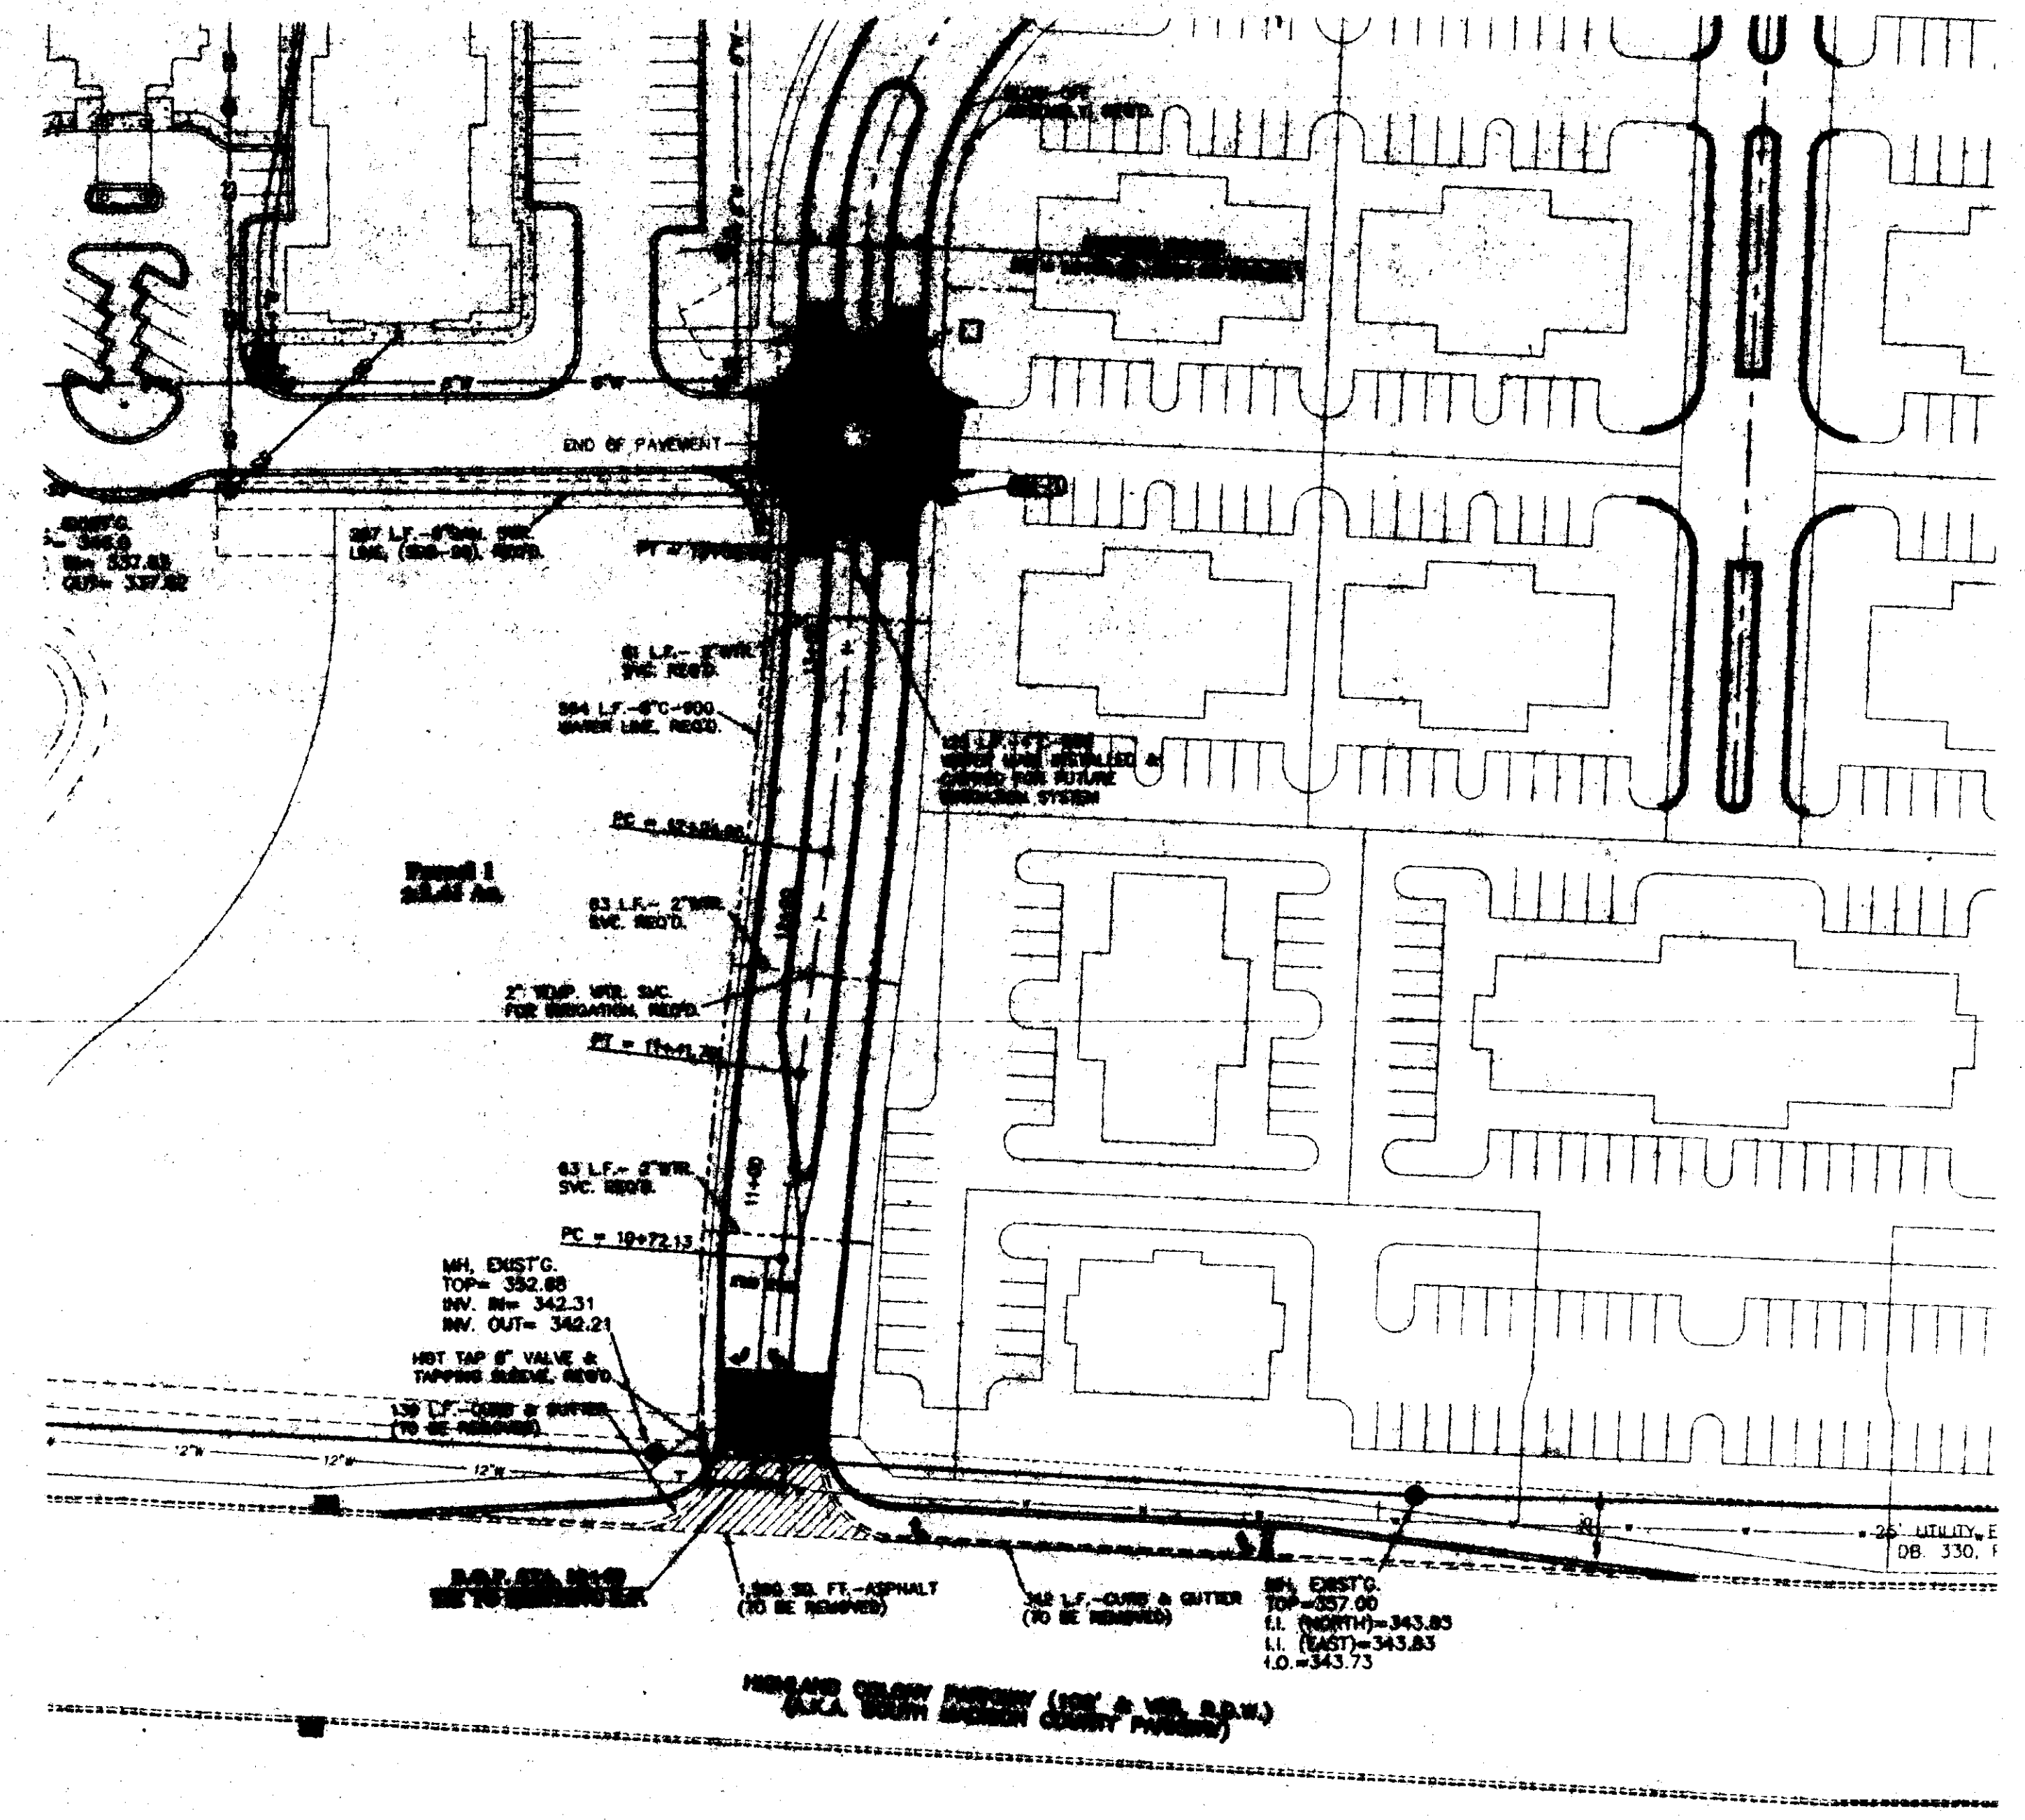

DESIGNED BY: SCOTT SCHWAB	APPROVED BY: FRY CHASE
DATE: 08-28-06	SCALE: C-2758
PROJECT NO.: 2758-01-05	


PROJECT:	
DATE:	
SCALE:	

Grant Consultants, Inc.
CONSULTING ENGINEERS & LAND SURVEYORS
THURSDAY, NEW HAMPSHIRE STATE * P.O. BOX 1200 * WARRAHAN, NH 38043
TELEPHONE (603) 885-8341 FAX (603) 885-3032

PROJECT: **THE COMMONS, PHASE 1**

WATER / SEWER LAYOUT

5

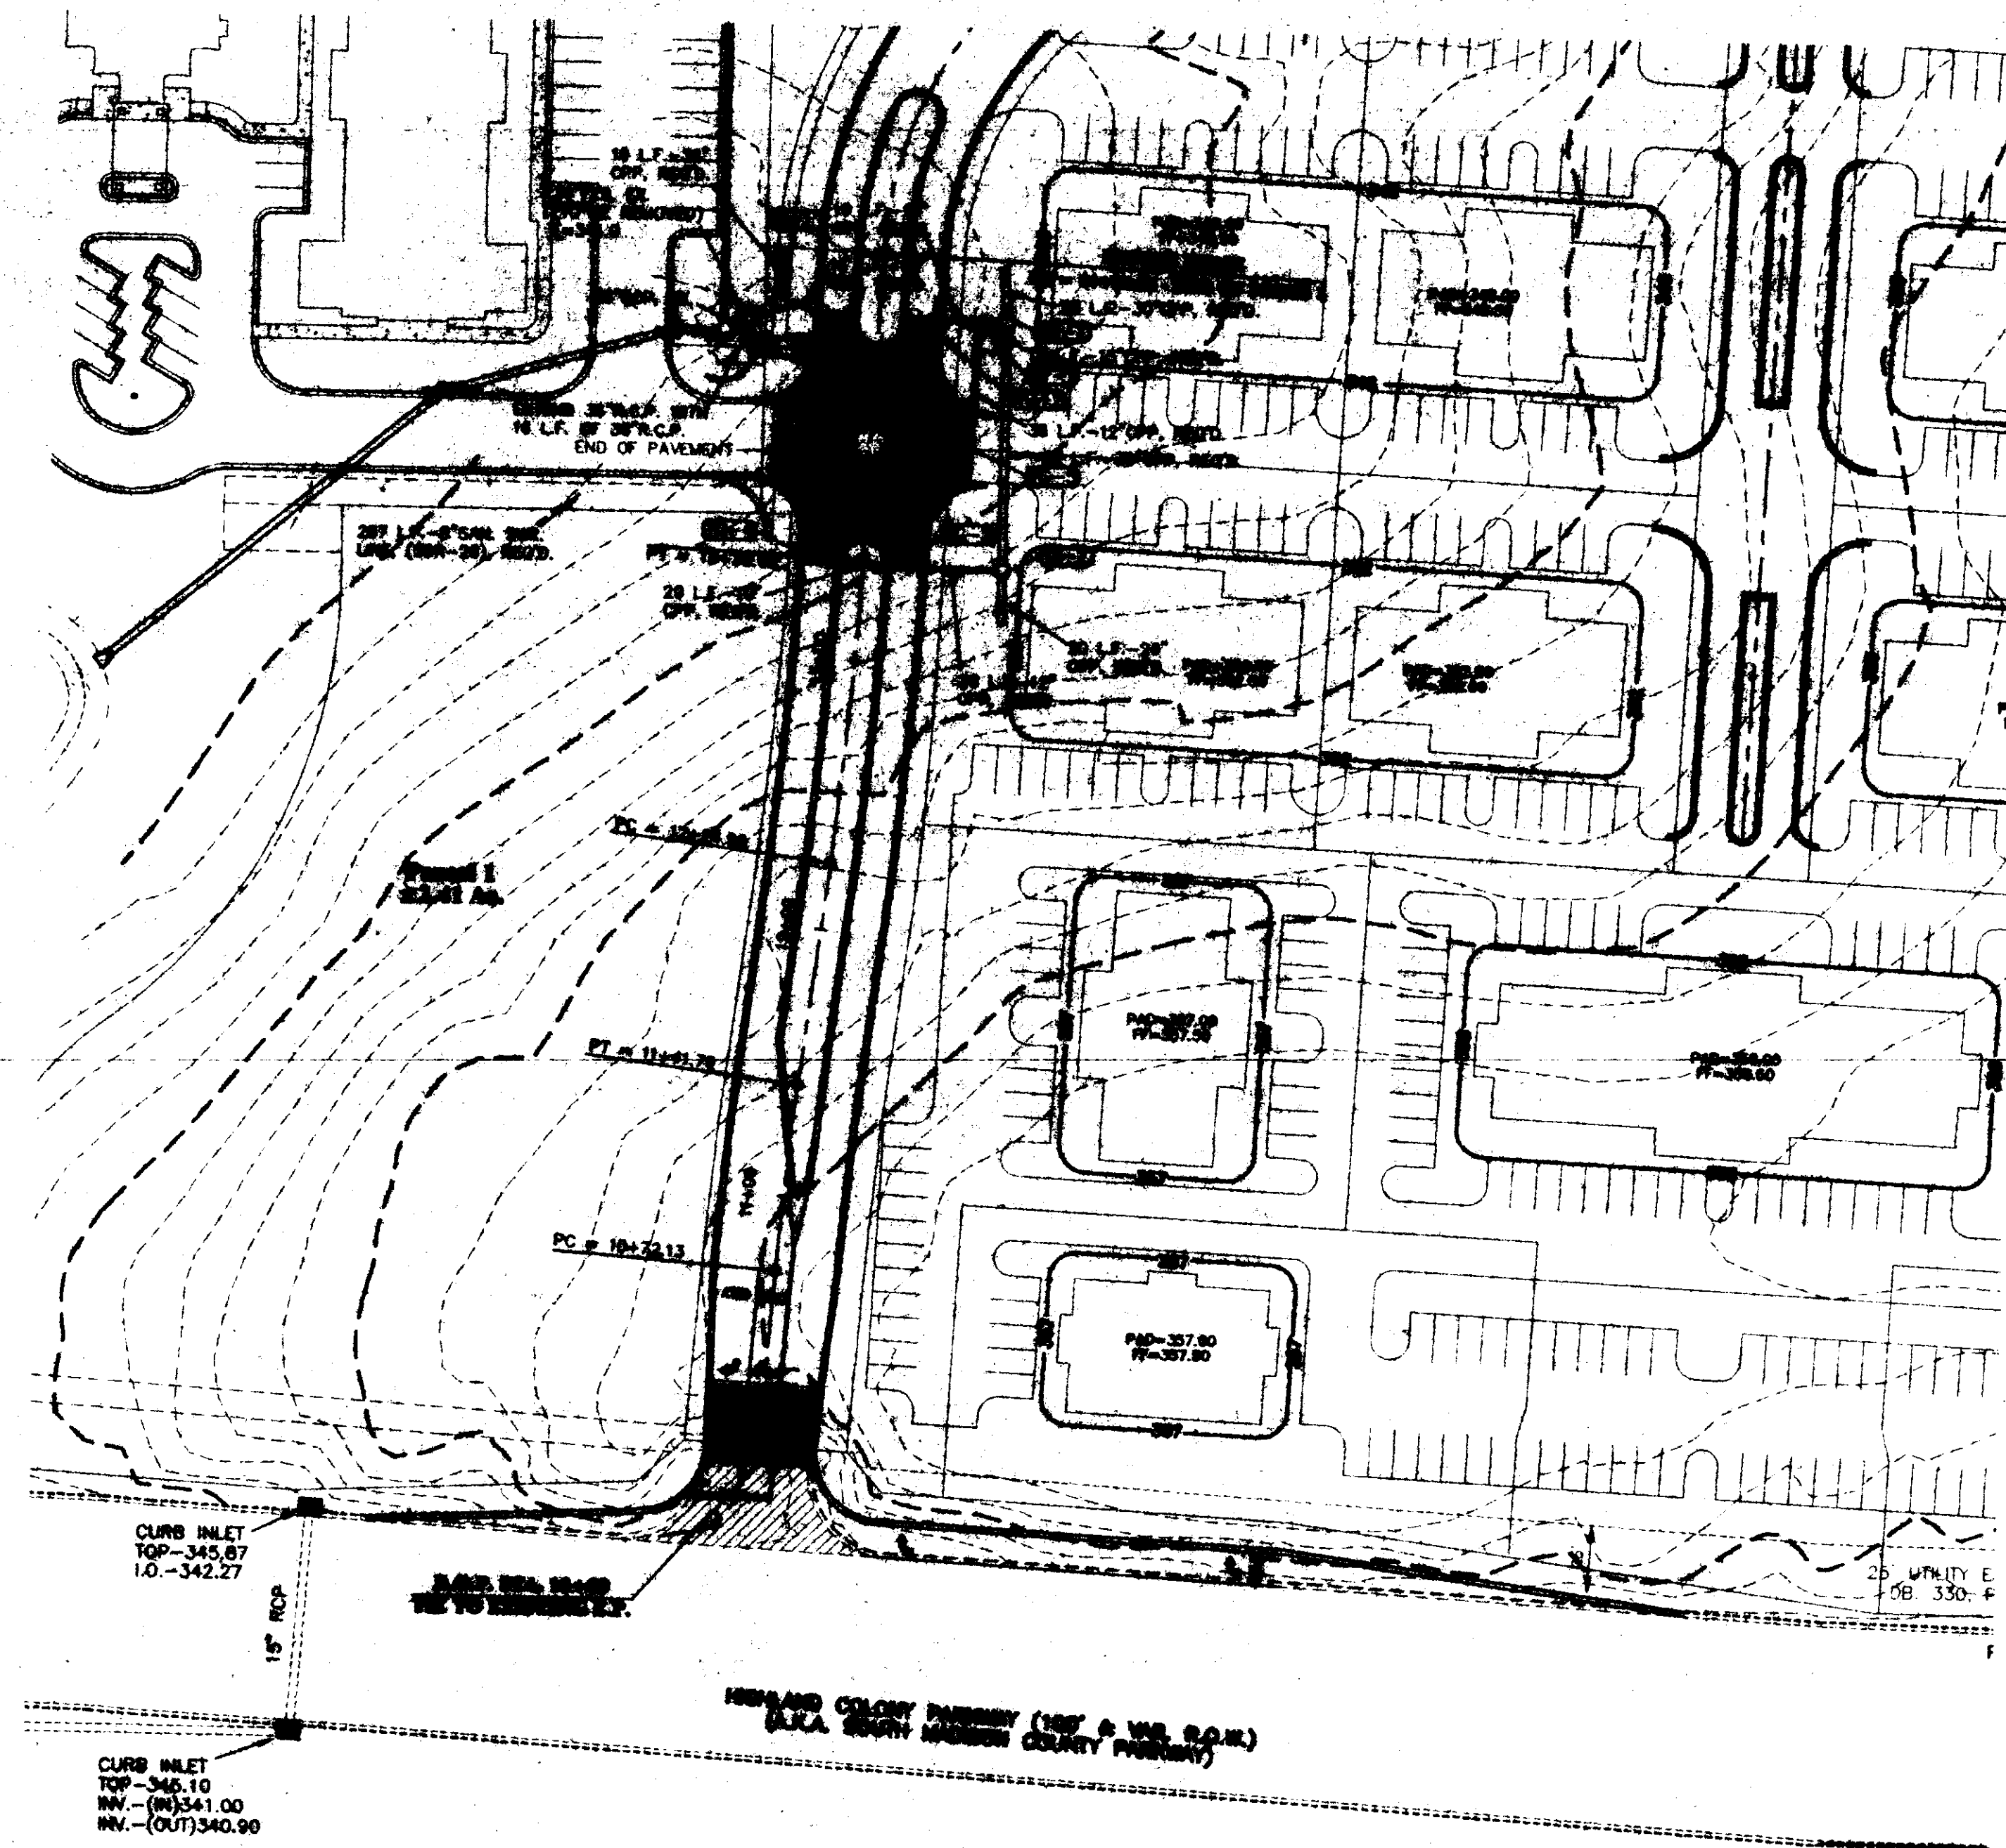

CONTRACTOR NOTES:
 1. Contractor will be required to establish construction benchmarks and provide construction staking for grading.

DETAIL NOTES:
 1. See sheet 302 for Junction Box Details.
 2. See sheet 322 for Curb Inlet Details.


STORM DRAINAGE SYSTEM DATA:


S-1 D.A.=0.50 Ac. Csg.=0.00 c.f.s. TOP=348.00 INV.=342.50	S-1 D.A.=0.11 Ac. Csg.=0.03 c.f.s. TOP=348.00 INV.=341.10	S-2 D.A.=0.18 Ac. Csg.=0.02 c.f.s. TOP=347.50 INV.=343.50
TP-1 D.A.=0.07 Ac. Csg.=0.48 c.f.s. TOP=348.00 INV.=342.88	TP-1 D.A.=0.37 Ac. Csg.=2.31 c.f.s. TOP=344.75 INV. IN=342.75 INV. OUT=342.46	TP-2 D.A.=0.09 Ac. Csg.=0.52 c.f.s. TOP=344.75 INV. IN=343.16 INV. OUT=342.84
TP-3 D.A.=0.23 Ac. Csg.=1.28 c.f.s. TOP=348.75 INV. IN=344.10 INV. OUT=343.76	TP-4 D.A.=0.18 Ac. Csg.=1.17 c.f.s. TOP=348.50 INV. IN=344.62 INV. OUT=344.30	TP-5 D.A.=0.06 Ac. Csg.=0.57 c.f.s. TOP=348.50 INV. IN=343.80 INV. OUT=343.50

SYMBOLS:

- 18" NYLOPLAST GRATE INLET
- CONCRETE JUNCTION BOX (SEE SHEET 11)
- GRATE INLET TYPE SS-3 (SEE SHEET 12)
- TRENCH GRADE

NOTES:
 CONTRACTOR TO SUB CORRUGATED PLASTIC PIPE INTO TRENCH GRADE AND GROUT. FIELD ADJUSTMENT OF TRENCH WIDTH AT PIPE CONNECTION AS REQUIRED.

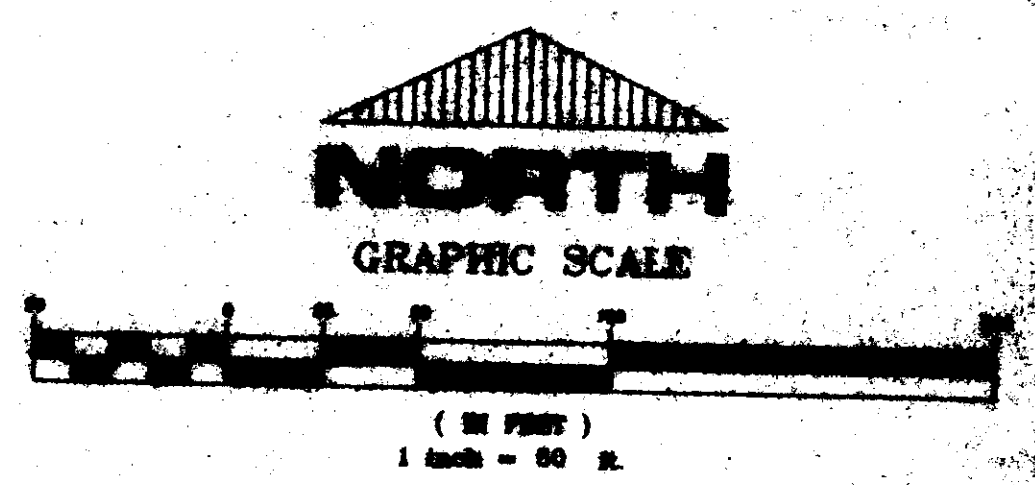

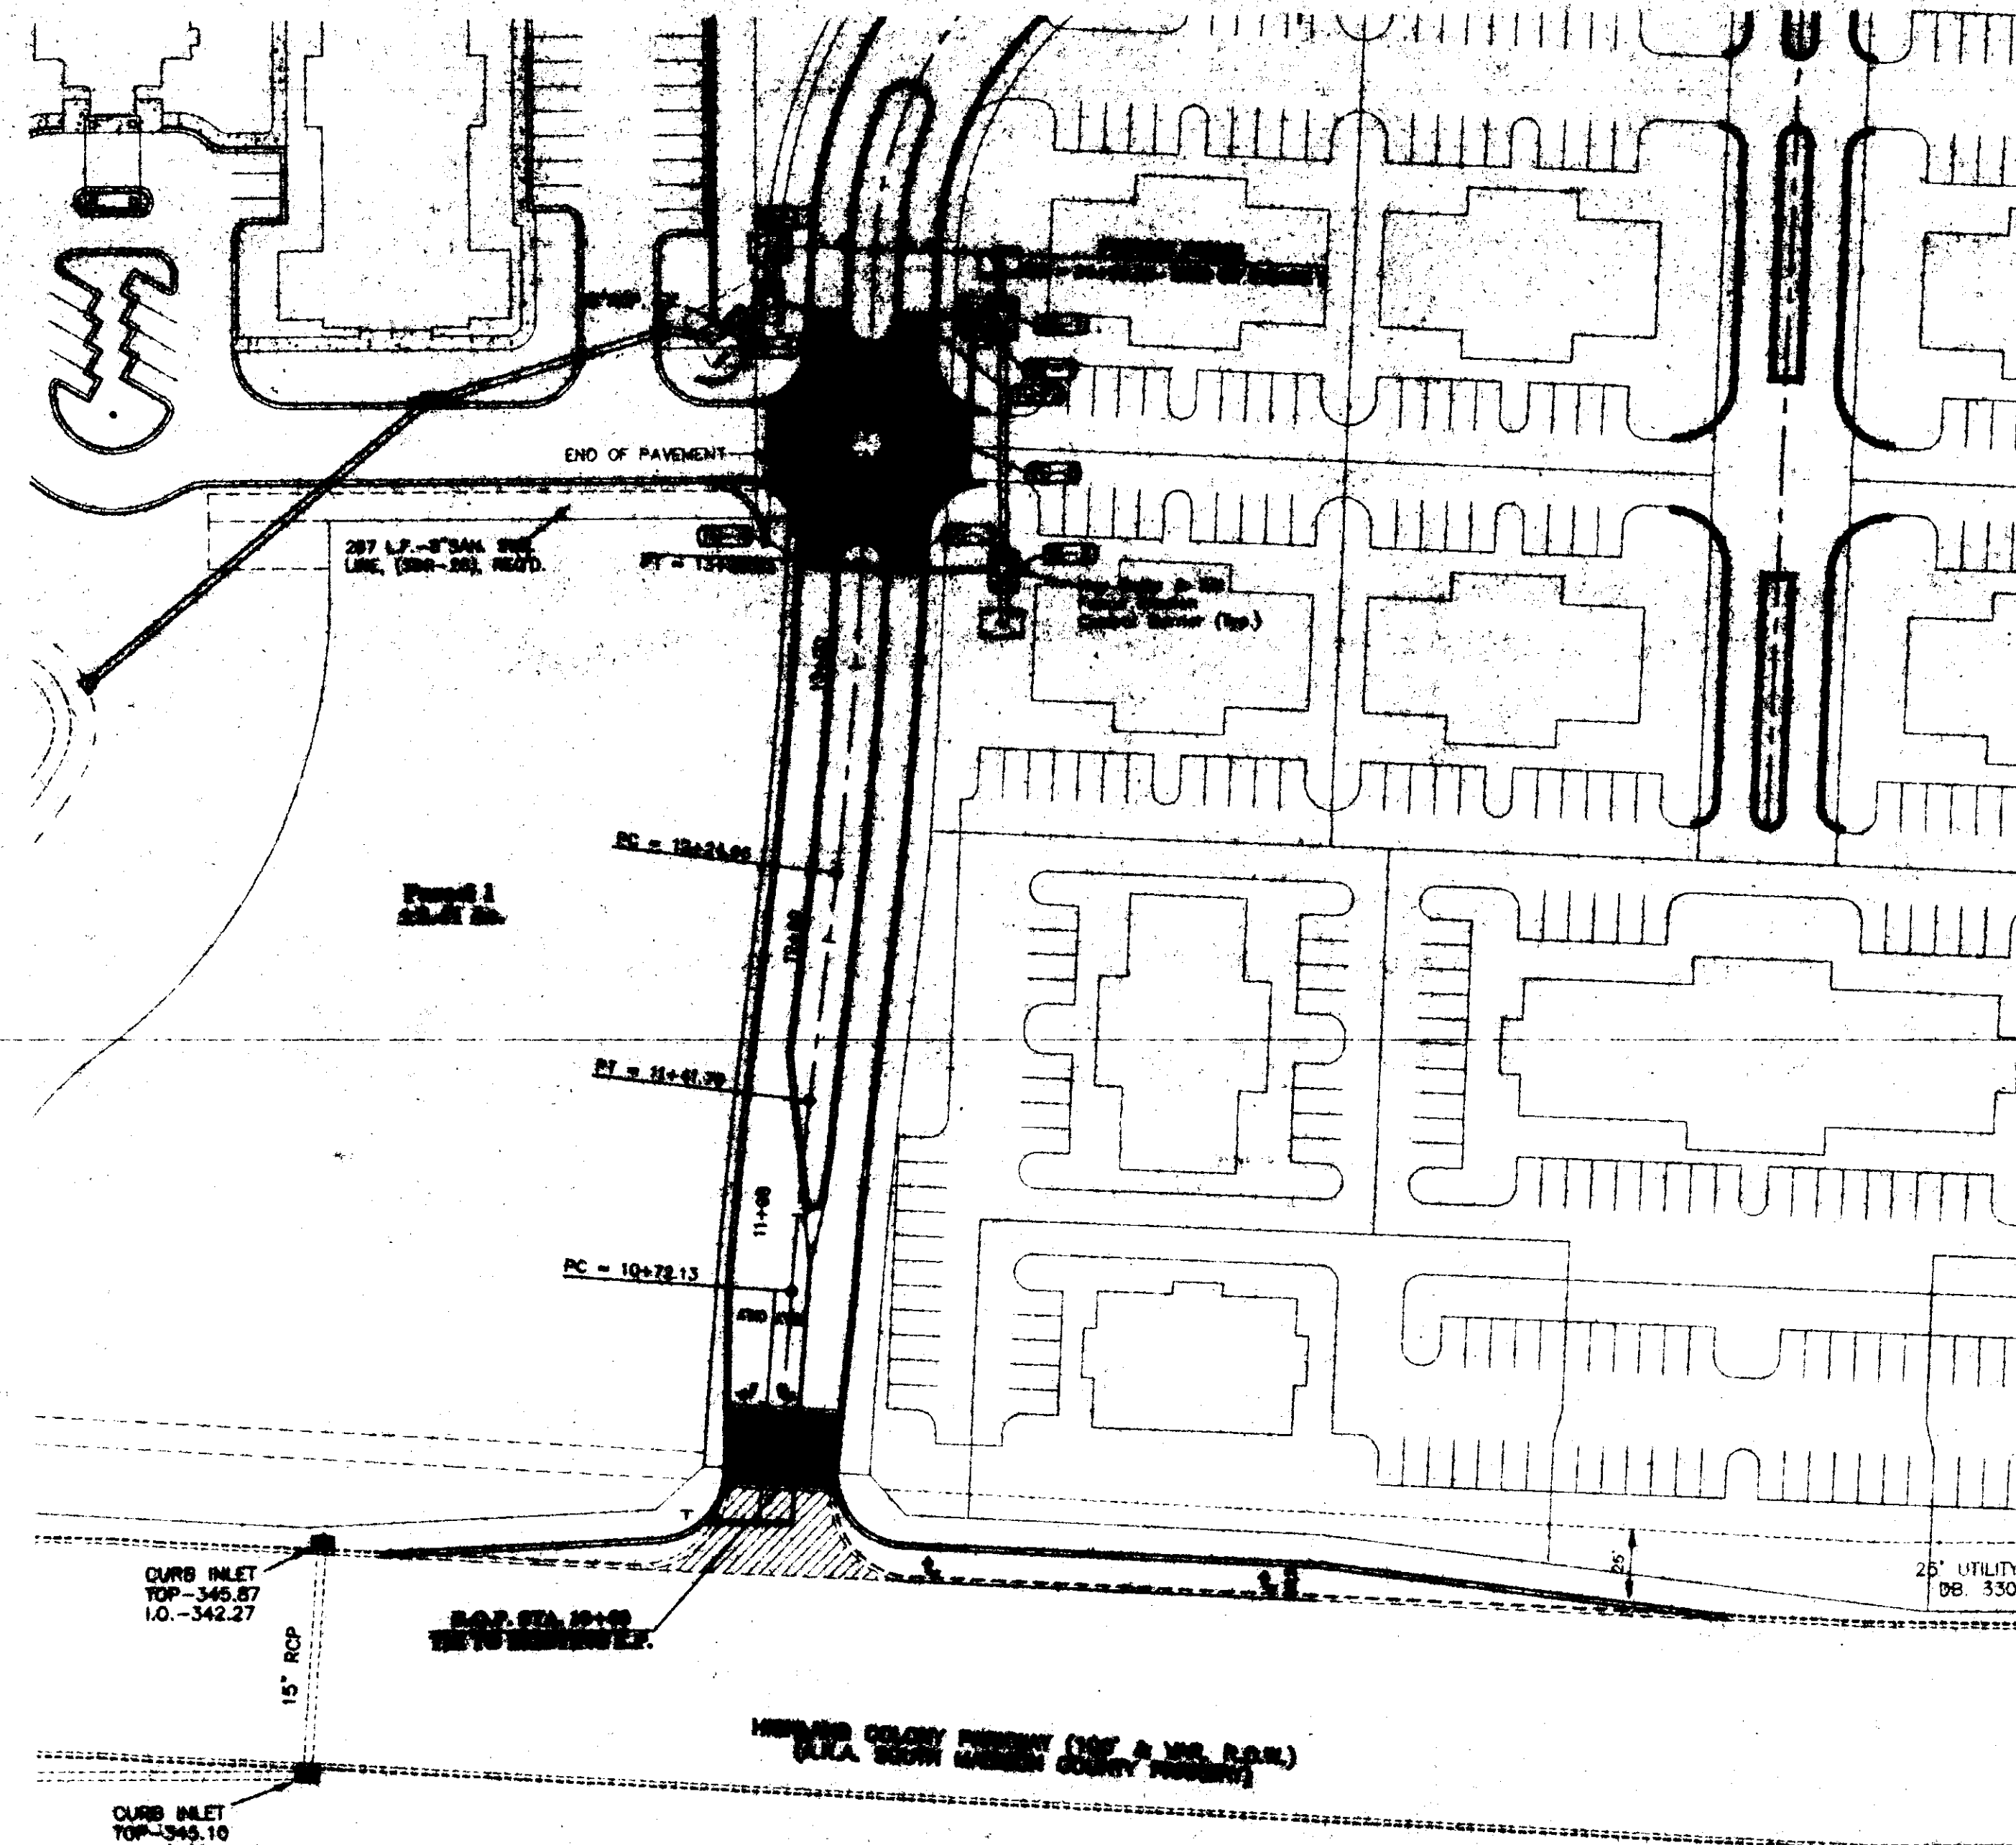

NOTES:
 Contractor shall adhere to all terms and conditions as outlined in the Contract, SPECIFICATIONS, and PERMITS for storm water discharge associated with construction activities.



CONSTRUCTION REQUIREMENTS:
 The following construction sequence for this project is intended to minimize the amount of sediment transport on site and adjacent sites until the project is complete.

- A. Site Preparation**
 The grading work shall include removal of surface material and topsoil, as required by the geotechnical report.
- B. Erosion Control**
 Eri fabric shall be placed on the slope above curb of 10' vertical, within 10' of the exterior of all storm water inlets and resulting catch basins. The fabric shall be installed in the following sequence to minimize soil disturbance and erosion:
 1. Install all fabric in accordance with manufacturer's recommendations.
 2. Place a 2" layer of topsoil over the fabric.
 3. Place a 2" layer of mulch over the fabric.
 4. Replenish all fabric along slope above curb with 2" of topsoil and 2" of mulch.
 5. Replenish all fabric along slope above curb with 2" of topsoil and 2" of mulch.
 Refer to sheet ___ of ___ for all fabric details.
- C. Storm-Drain System**
 Install the storm-drain system in the grade and elevation of this location above on the plan. Care shall be taken to maintain a minimum of 12" clearance into the storm drain above and the reinforcing pipe during handling or repair. If possible, all fabric should be placed over the storm drain and reinforced with the fabric.
- D. Vegetation**
 Vegetate and/or landscape all curb, utility, and drainage areas as soon as possible during the construction operations.

MAINTENANCE PLAN:
 Both the short-term (during construction) and long-term (after completion) maintenance needs shall be addressed.


- A. Short-Term**
 All erosion and sediment-control practices shall be inspected for stability and operation following every rainfall. Practices shall be repaired or replaced as needed. Any heavy rains shall be noted immediately in writing for the project participant as needed.
 Sediment will be removed from the upstream face of all fabric when it has accumulated to about six-inch depth at the fence. The fabric shall be replaced as necessary to maintain a barrier.
 All vegetated areas will be defined and maintained as needed to maintain a vigorous and dense vegetative cover.
 All drainage structures that will be exposed to stormwater run-off during construction shall receive temporary erosion shields (Hay Bales). Refer to sheet ___ for details.
- B. Long-Term**
 All vegetative areas will be maintained in adequate condition to provide proper ground cover and reduce any areas of potential erosion. Where vegetation is lost, the area will be fertilized and seeded or other acceptable methods used to restore proper cover.

FABRIC:
 Synthetic filter fabric shall be a porous sheet of polypropylene, nylon, polyester and shall be certified by the manufacturer or supplier and conform to the following requirements:
 a) Filtration efficiency (75% minimum)
 b) Tensile strength (not less than 700 lb/ft. in. minimum)
 c) Flow rate 0.3 gal./sq. ft./min. (minimum)

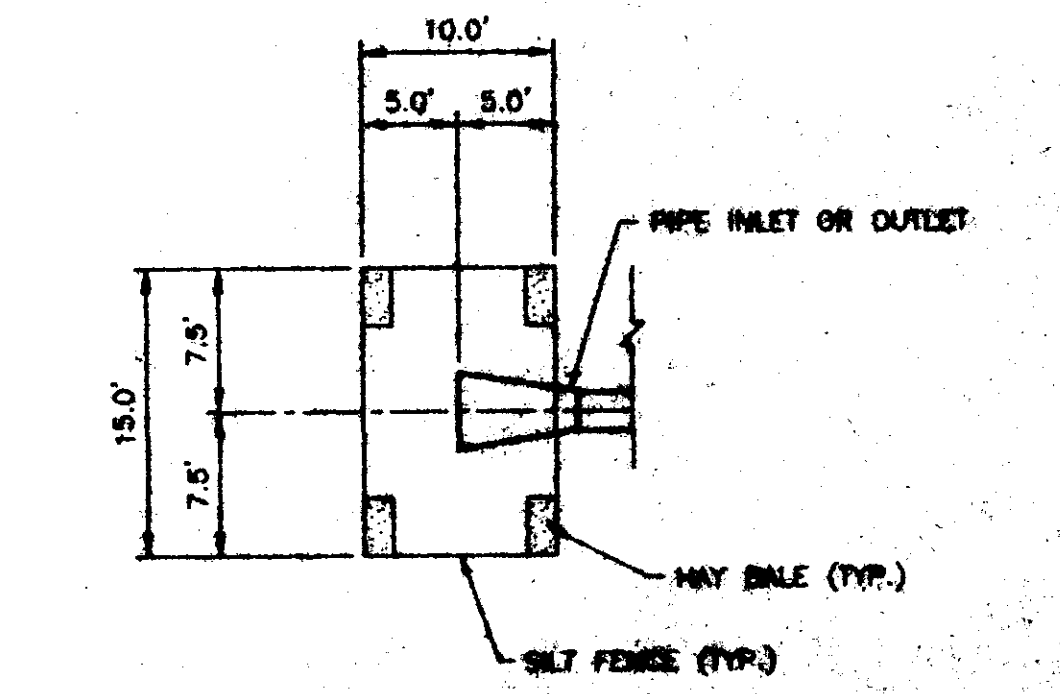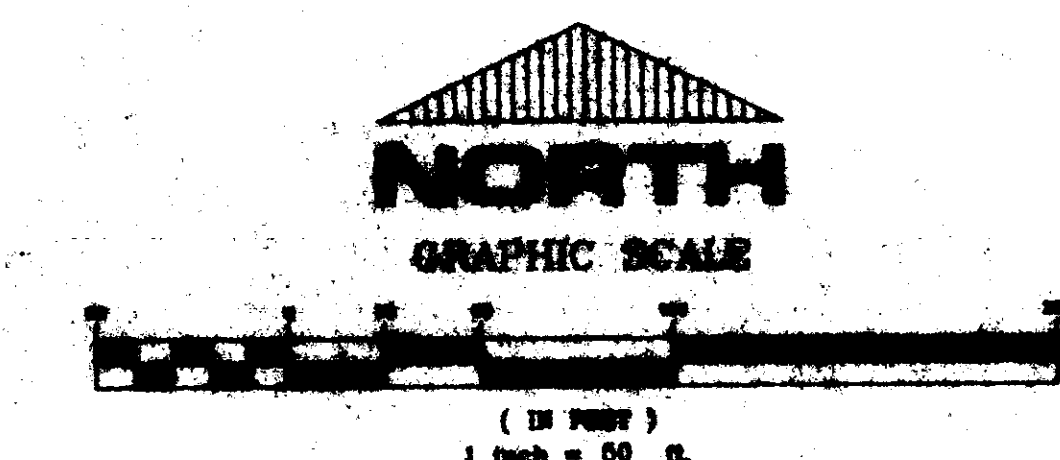


DRAWN BY: RICHARD SOMERS DATE: 05-28-08 SHEET NO.: 2738-ER-SCP	CHECKED BY: PAT GIBST DATE: 05-27-08	PROJECT: THE COMMONS, PHASE 1	DRAWING NO.: EROSION CONTROL PLAN	SHEET NO.: 7
--	---	-------------------------------	-----------------------------------	--------------

Gibst Consultants, Inc.
 CONSULTING ENGINEERS • LAND SURVEYORS
 TWENTY SIX EASTGATE DRIVE • P.O. BOX 1285 • BRUNSWICK, MS 38043
 TELEPHONE (601) 525-8341 FAX (601) 525-3432

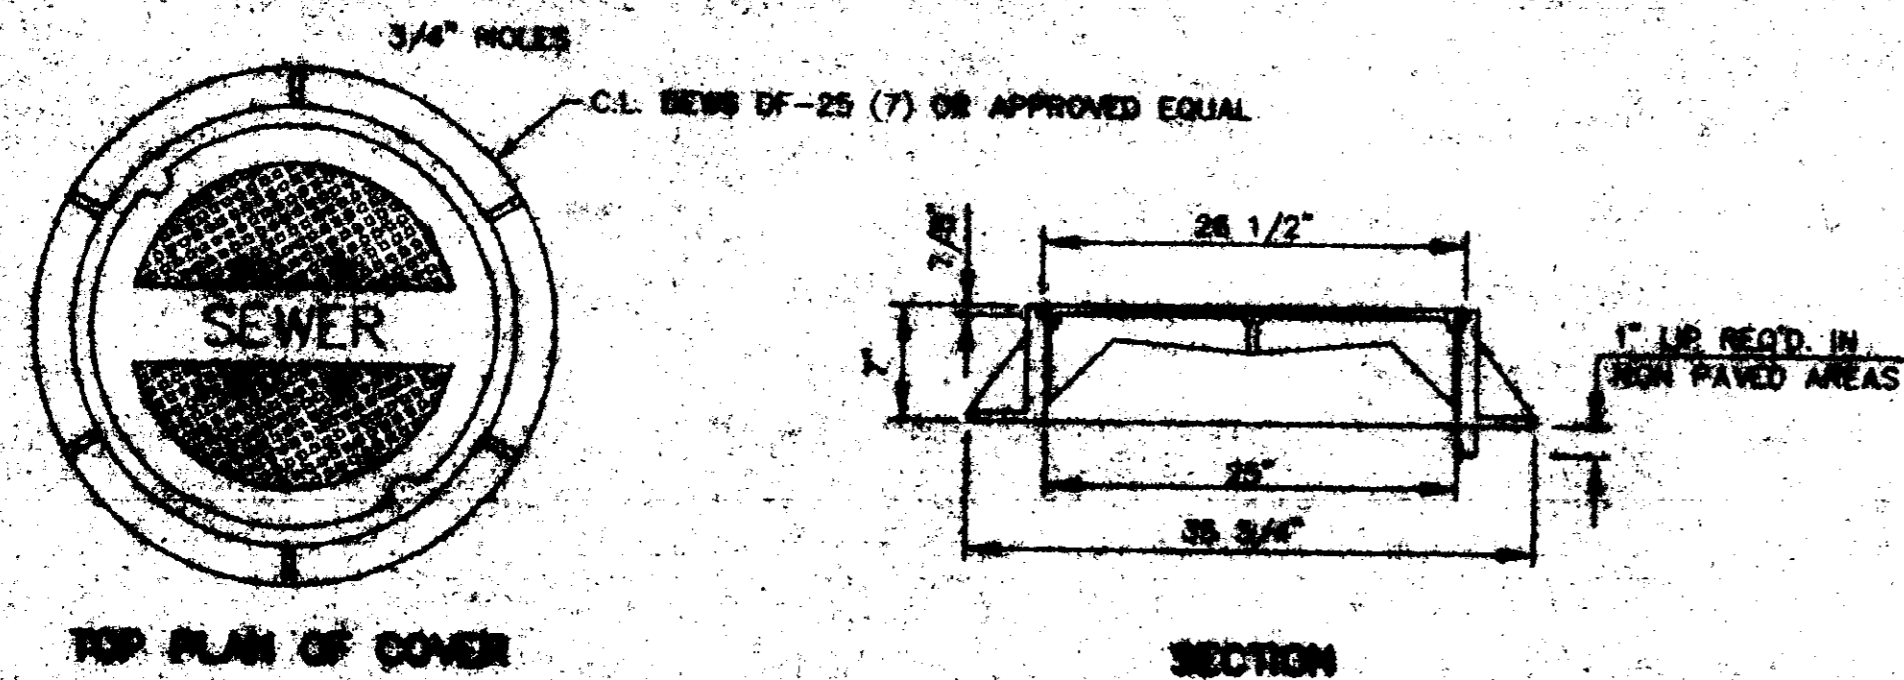


STANDARD MANHOLE FRAME AND COVER
N.T.S.

NOTE: INLET AND OUTLET PIPES SHALL BE JOINED TO THE MANHOLE WITH FLEXIBLE BOOTS WHICH ALLOW DIFFERENTIAL SETTLEMENT OF PIPE AND MANHOLE

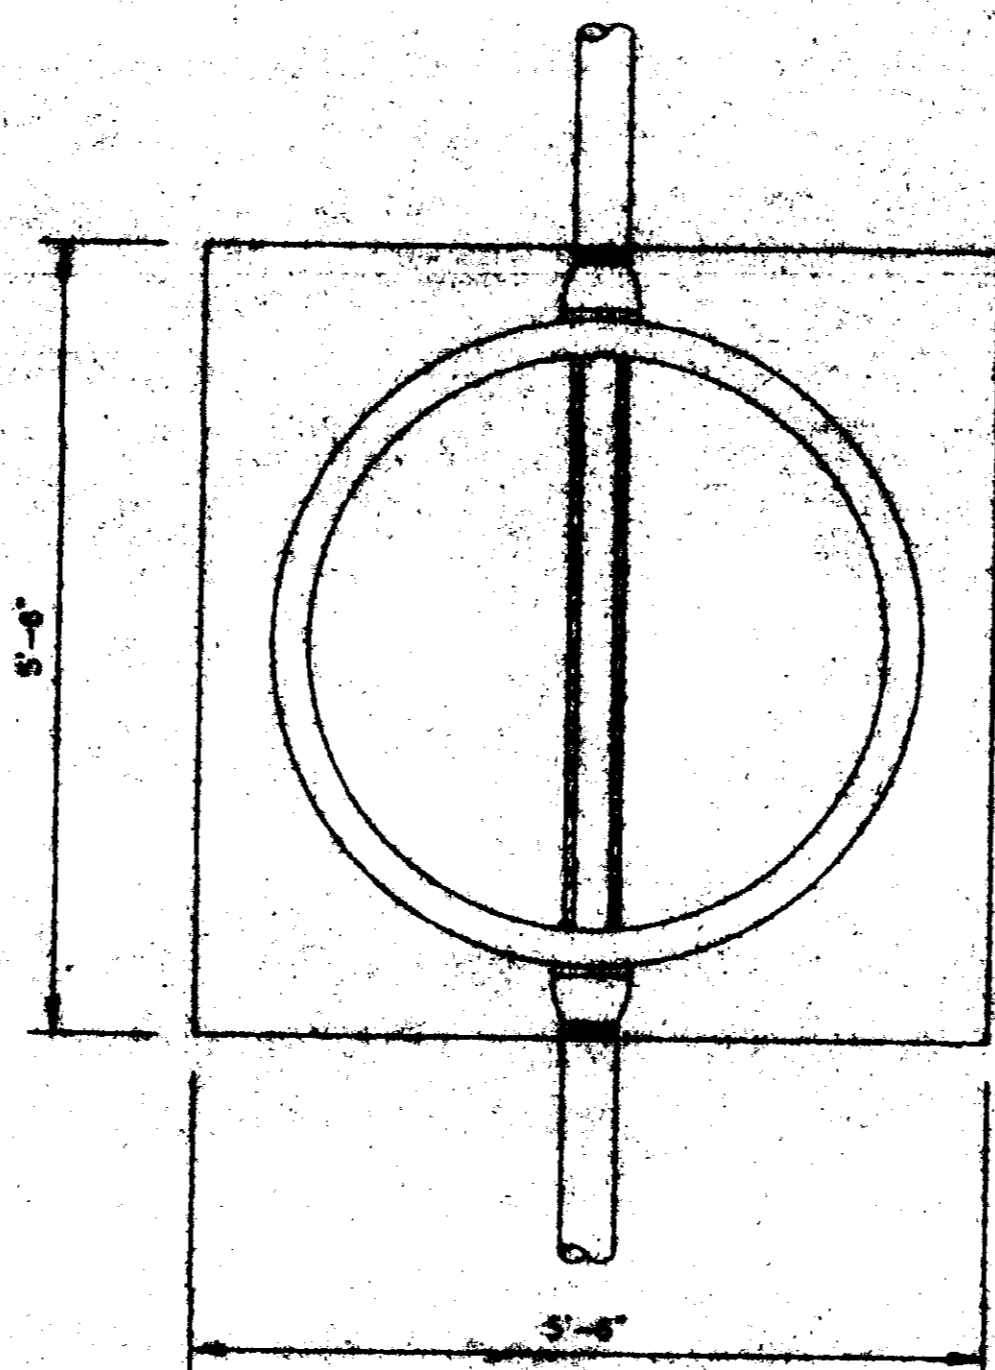


TYPICAL PIPE CONNECTION TO MANHOLE
N.T.S.

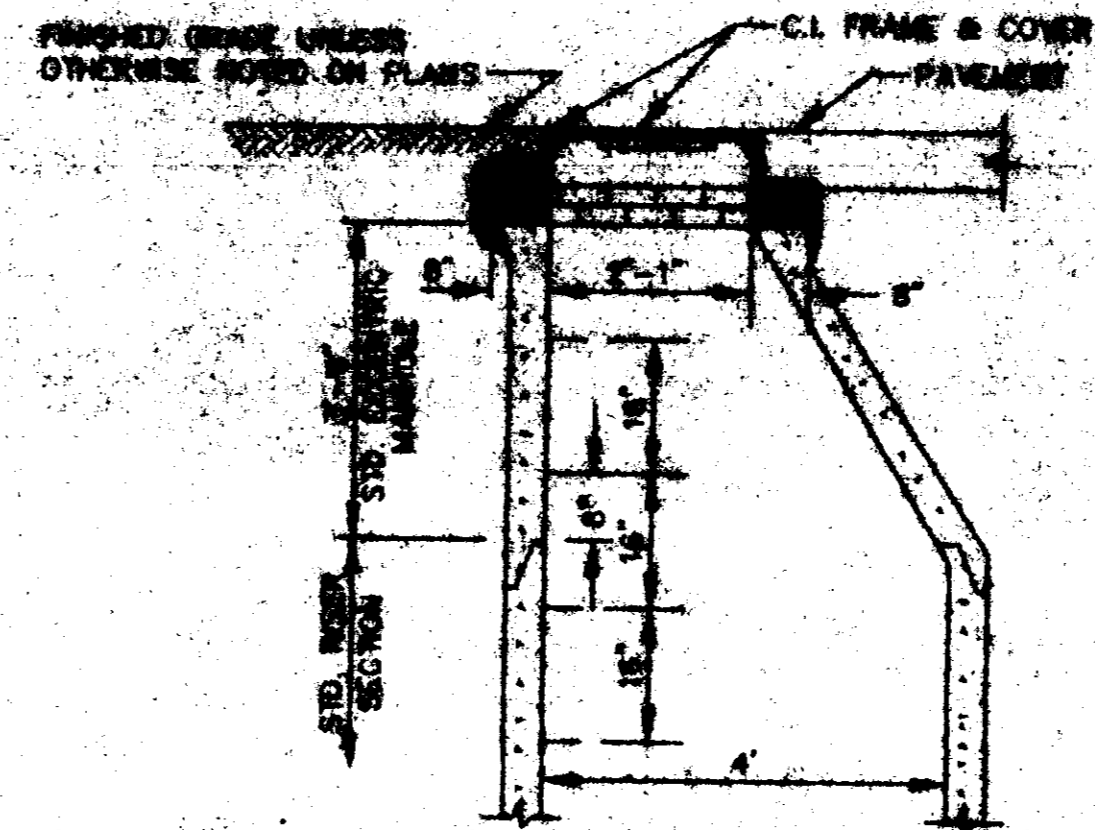


NOTE: DETAILS FOR RISER & BASE SECTIONS ARE SAME AS SHOWN IN SECTION OF PRECAST CONCRETE MANHOLE.


STANDARD ECCENTRIC CONE FOR ALL DIAMETER MANHOLES
N.T.S.

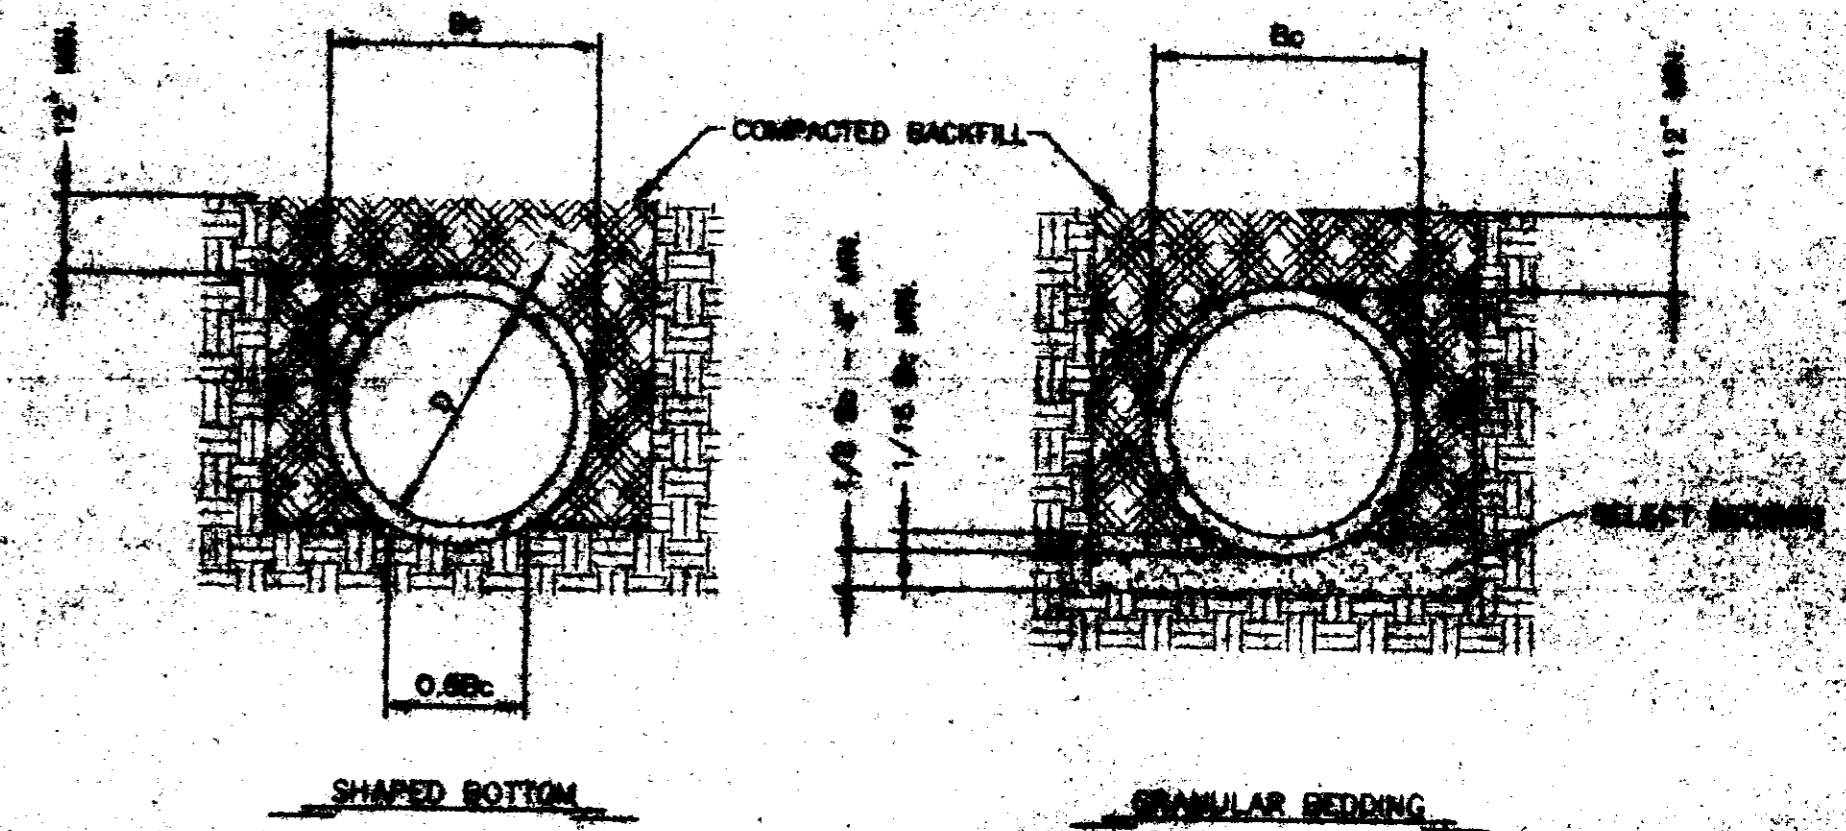

TYPICAL TRENCH DETAILS
CLASS "C"
N.T.S.

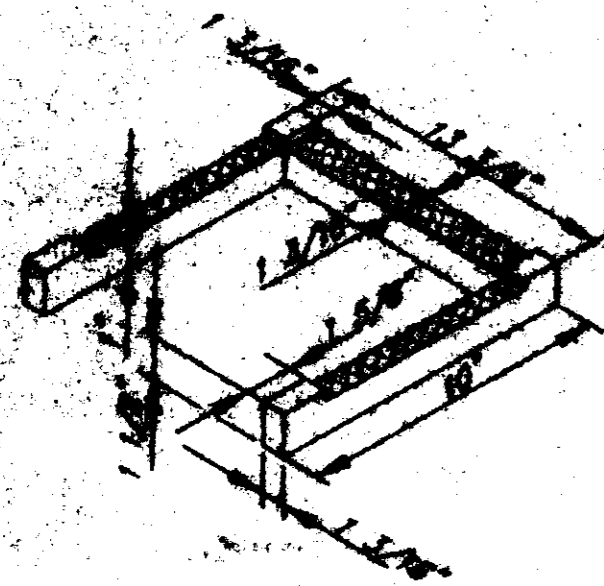


DETAIL "B"
N.T.S.

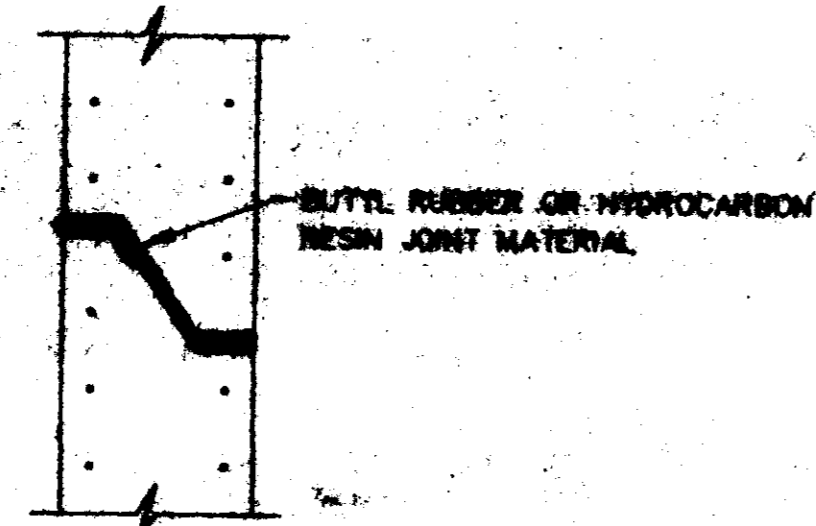


TYPICAL PRECAST CONCRETE MANHOLE JOINT DETAIL
N.T.S.


18" DIA. MANHOLE STEP AS MANUFACTURED BY M.A. INDUSTRIES INC. OR EQUAL

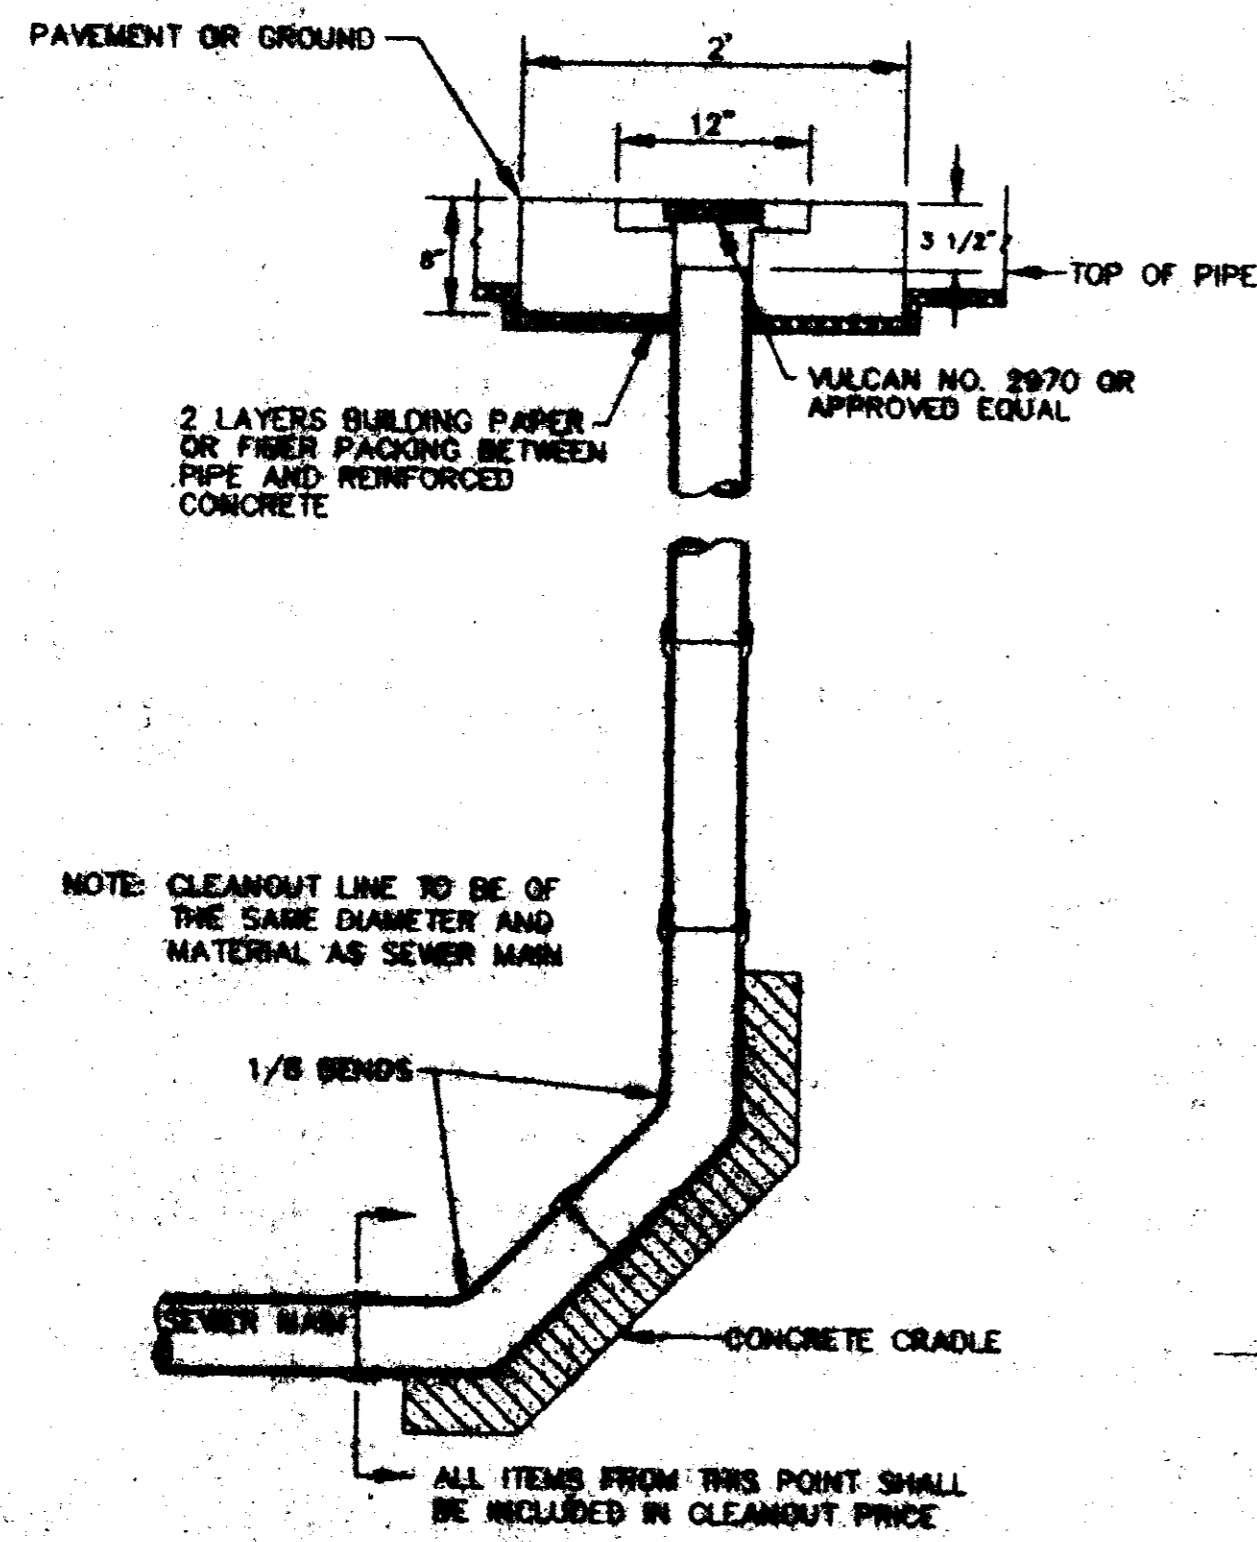

TERMINAL CLEANOUT
N.T.S.

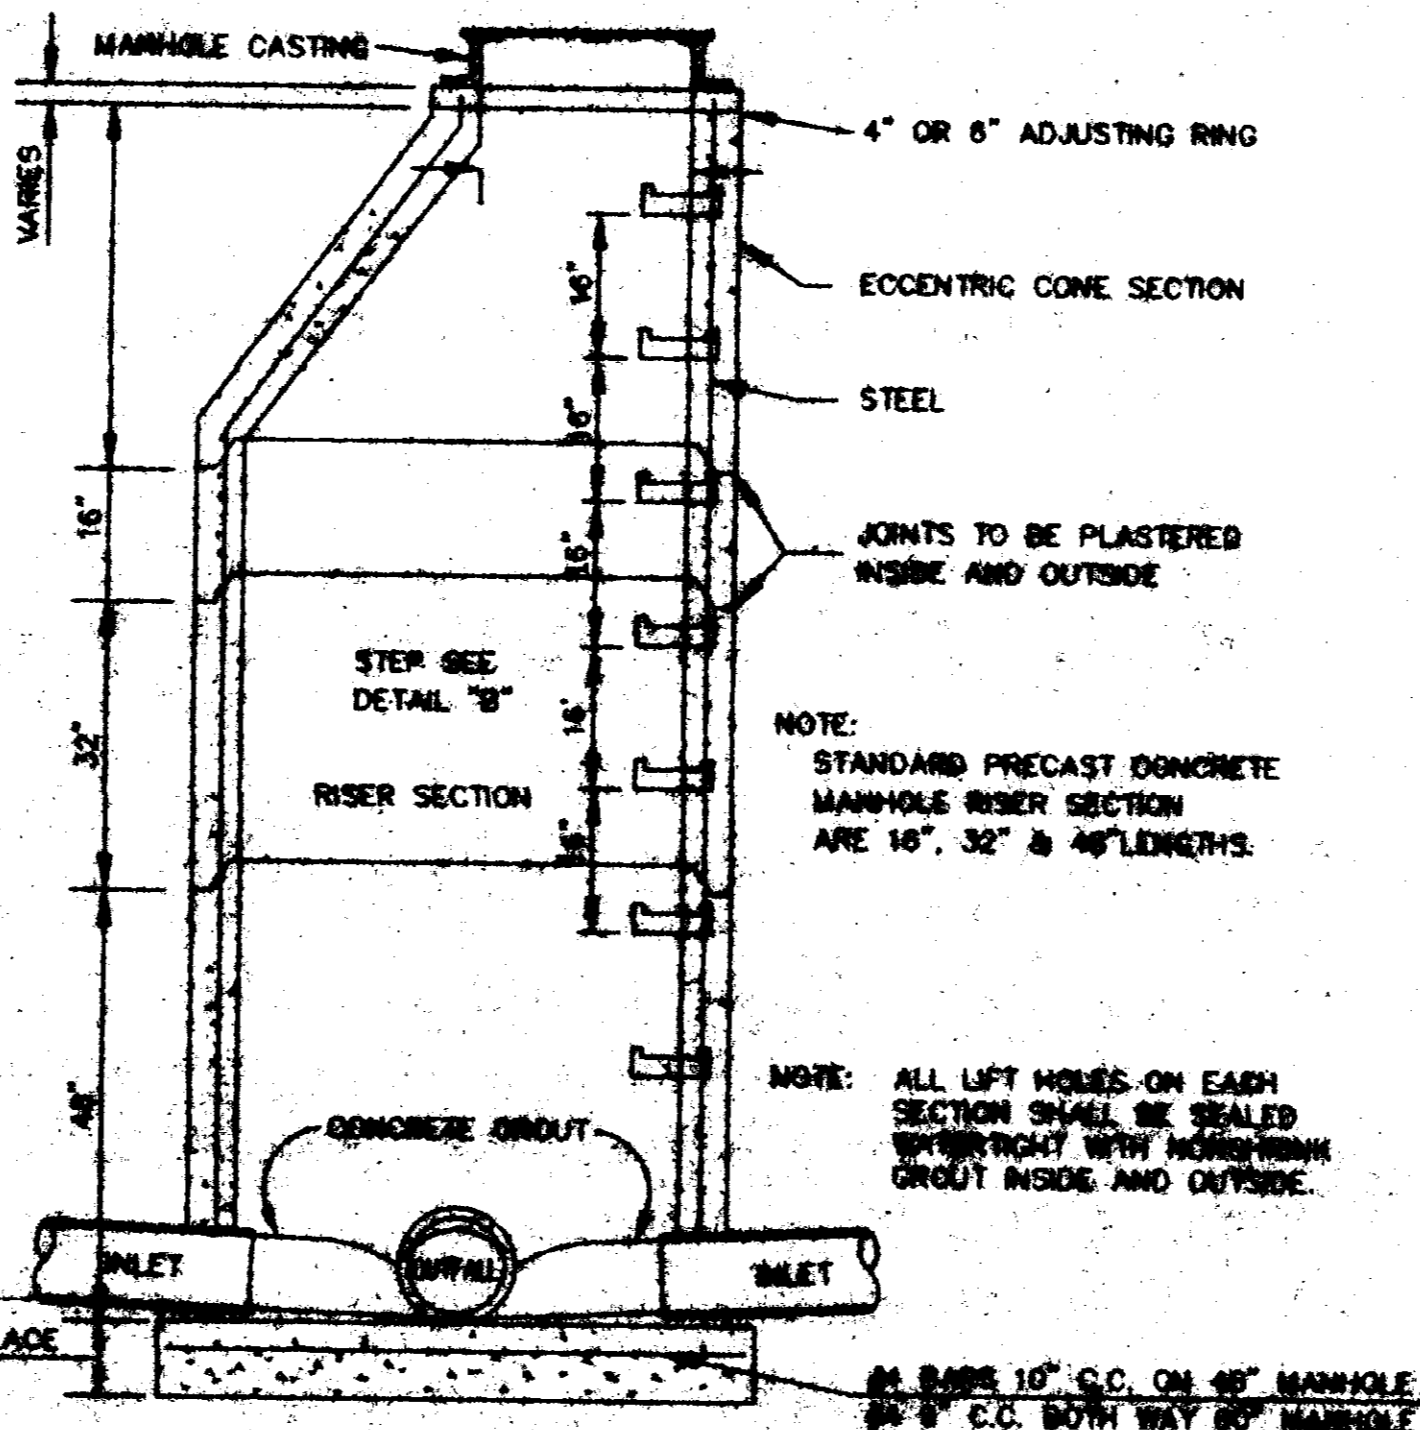


SECTION OF PRECAST CONCRETE MANHOLE
N.T.S.

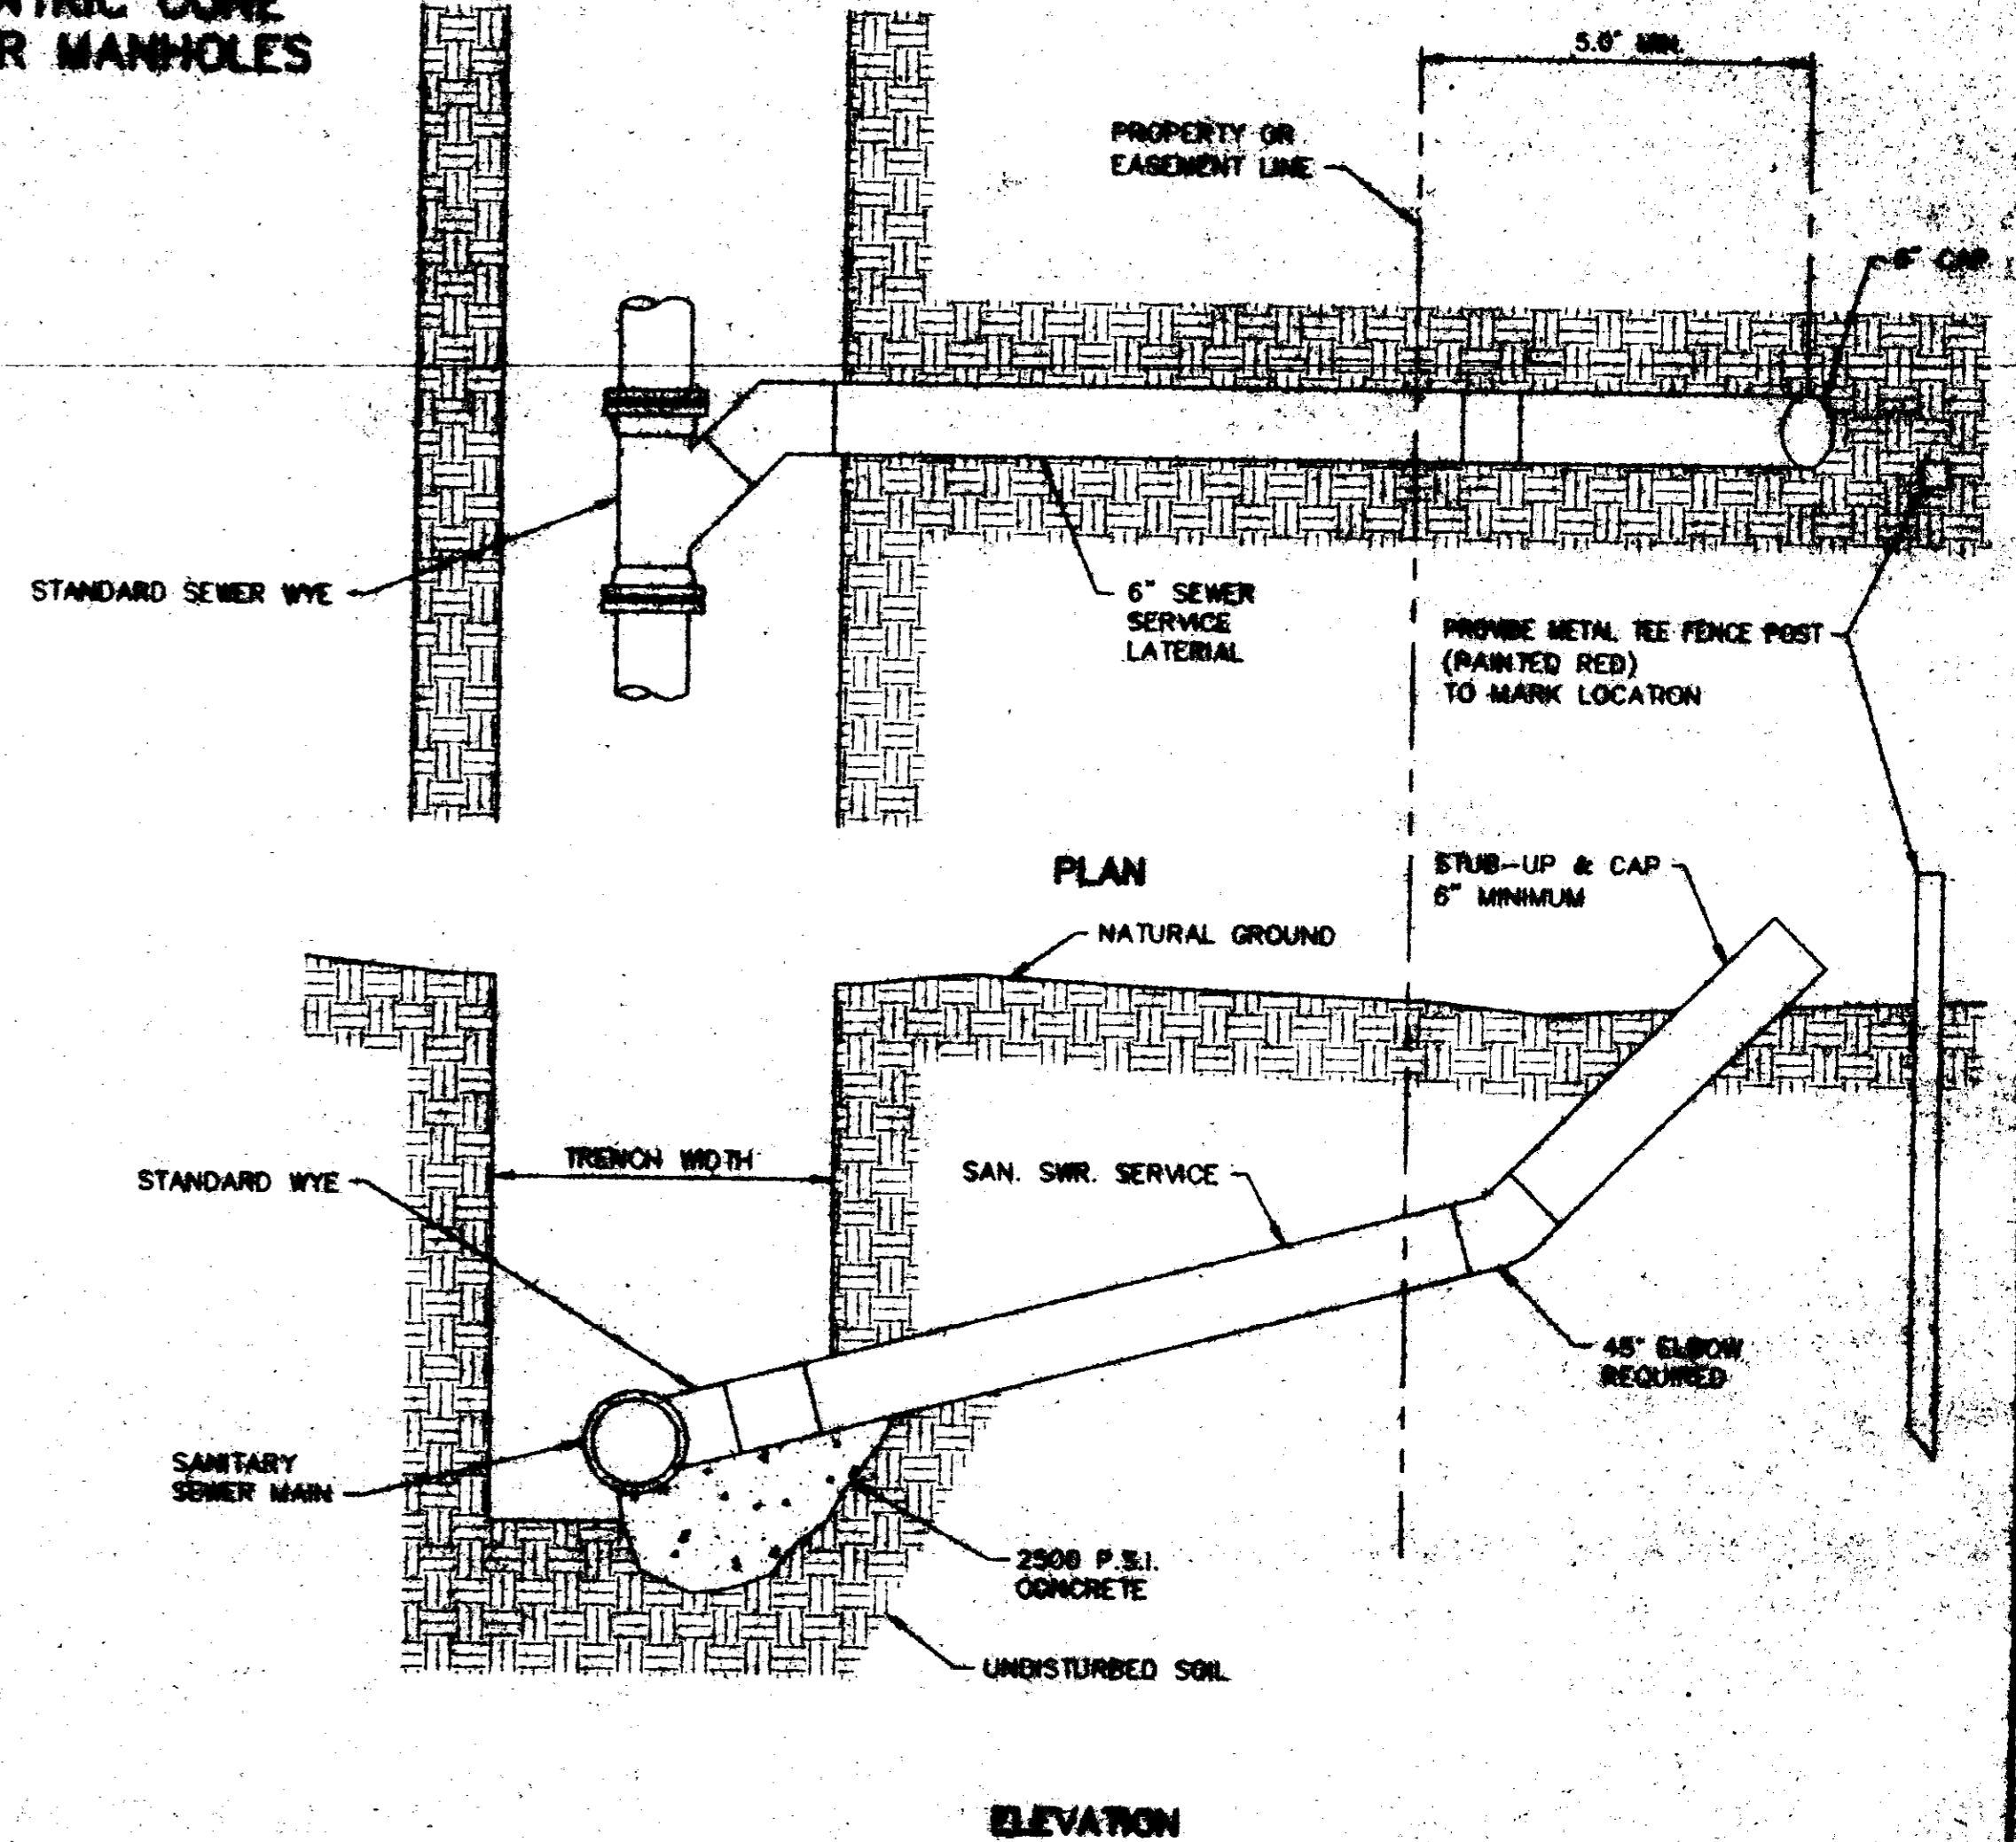


SEWER SERVICE CONNECTION
N.T.S.

DRAWN BY: [] CHECKED BY: [] DATE: []	PROJECT: THE COMMONS, PHASE 1	SHEET: 9
---	-------------------------------	----------


Grant Consultants, Inc.
CONSULTING ENGINEERS & LAND SURVEYORS
THIRTY SIX EASTGATE DRIVE • P.O. BOX 1266 • BIRMINGHAM, MS 38203
TELEPHONE (801) 825-8341 FAX (801) 825-3032

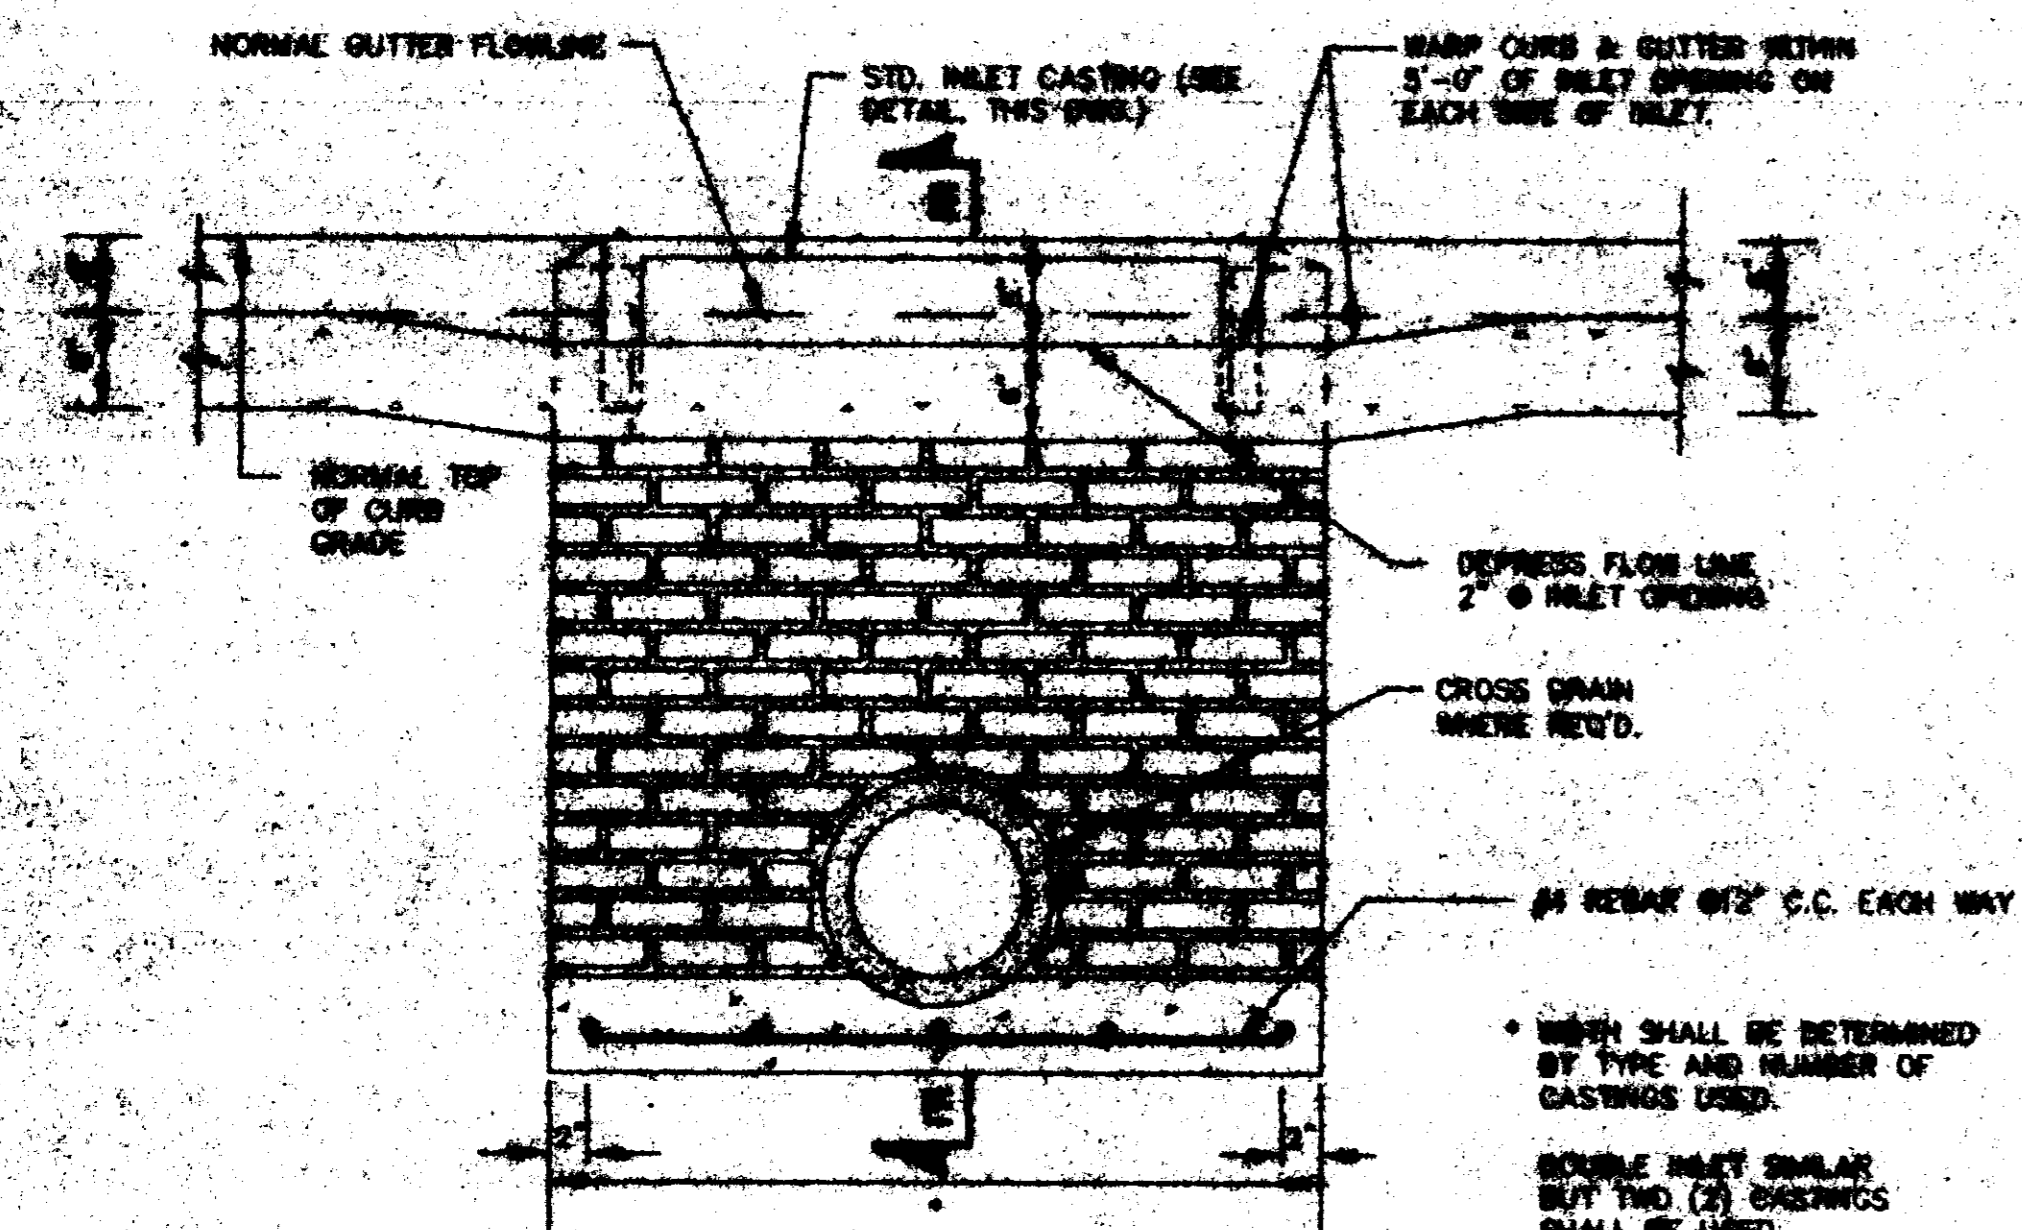

FRONT ELEVATION
INLET TYPES "A" AND "A" MODIFIED

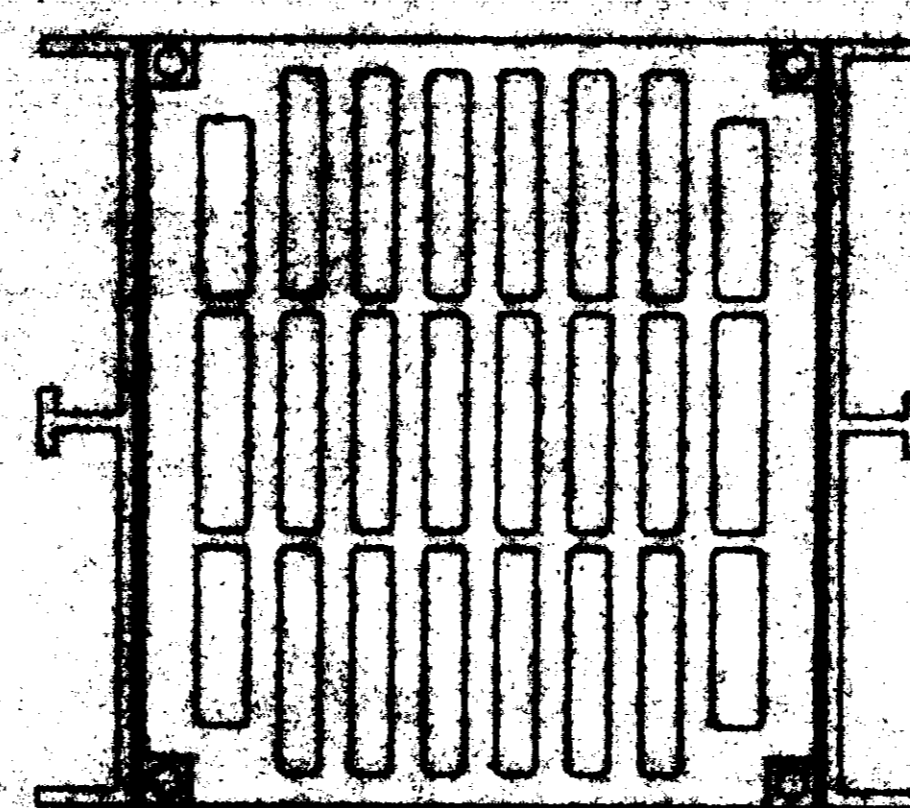


PLAN

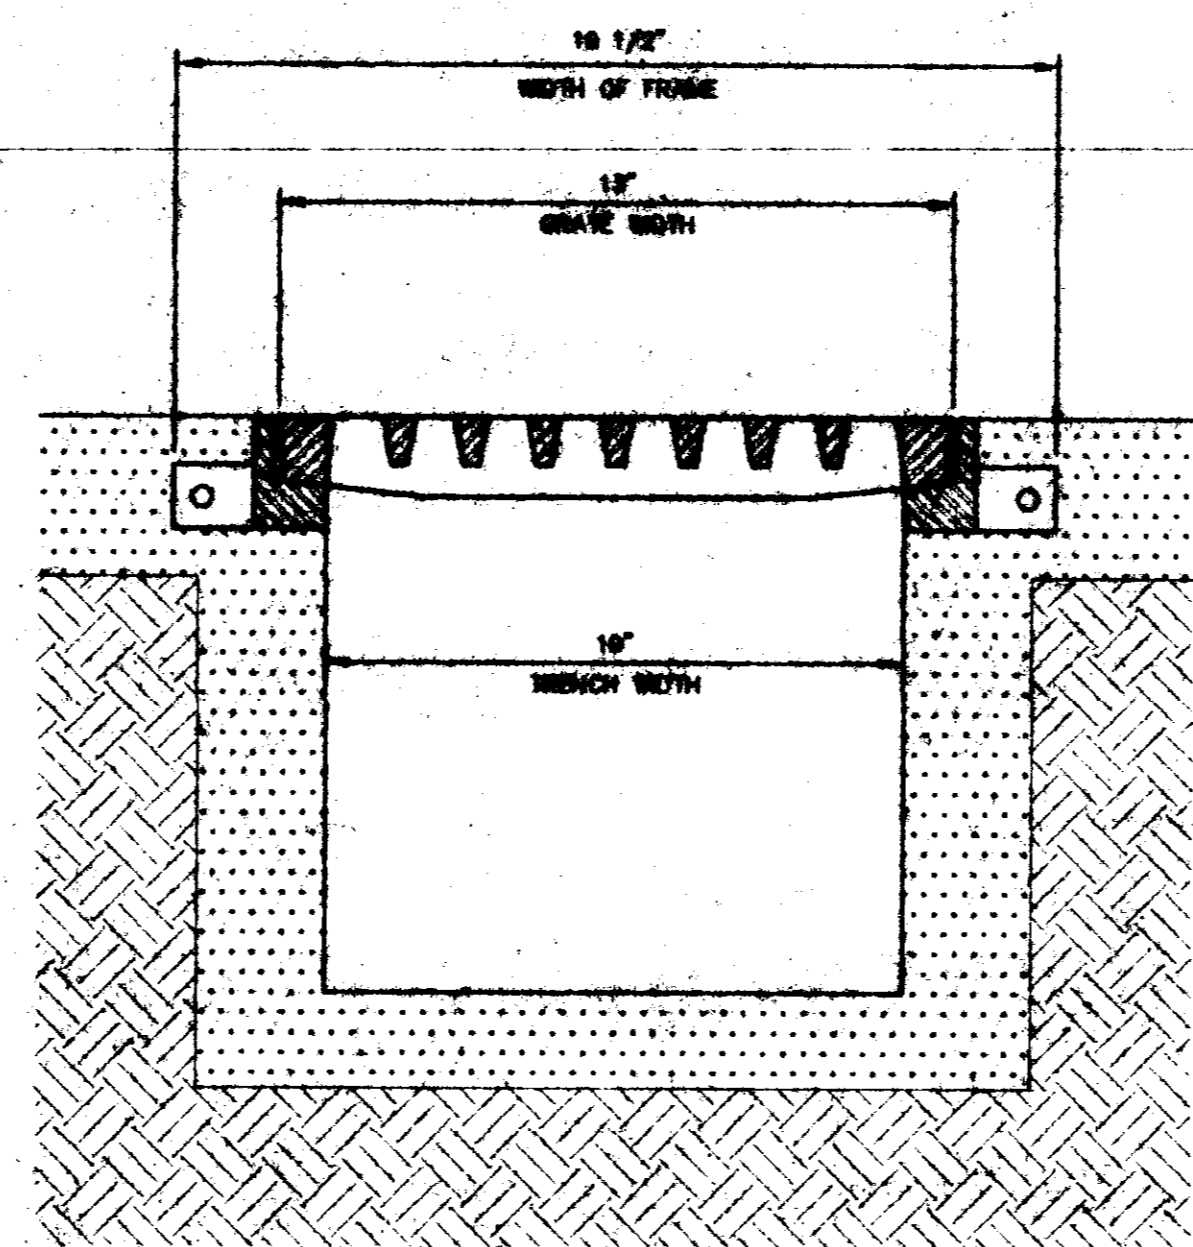


SECTION

TRENCH GRATE DETAIL


N.T.S.
NOTE: GRADE AND FRAME ARE EAST JORDAN IRON WORKS MODEL NUMBER V-7305 OR EQUAL.

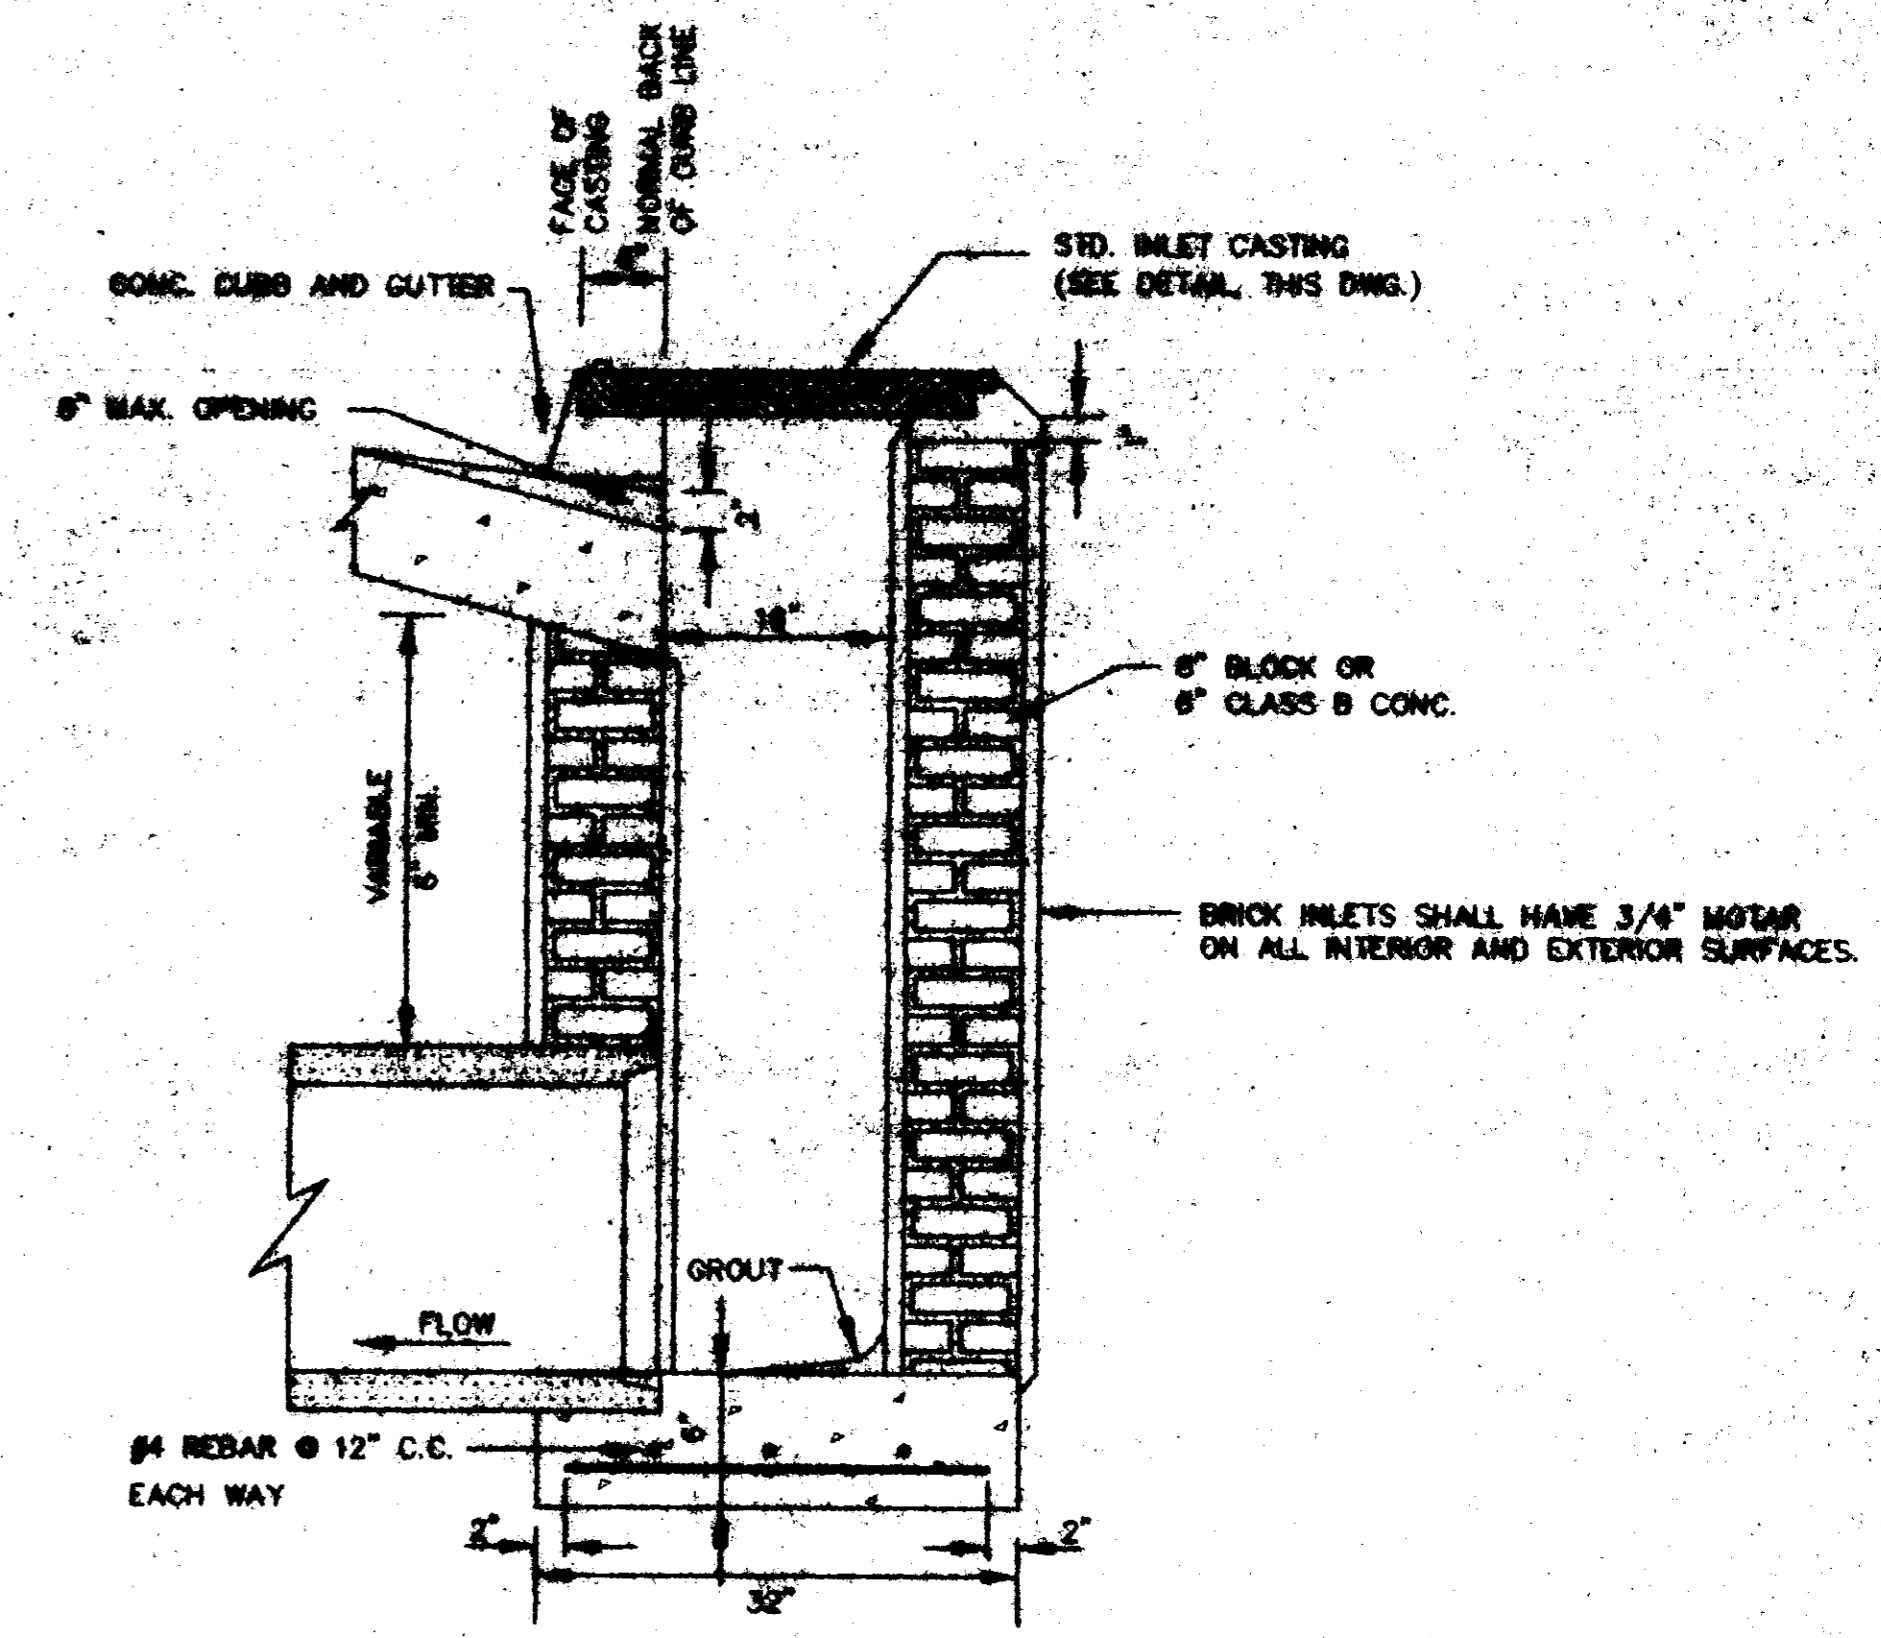

SECTION E - E
TYPE "A" INLET

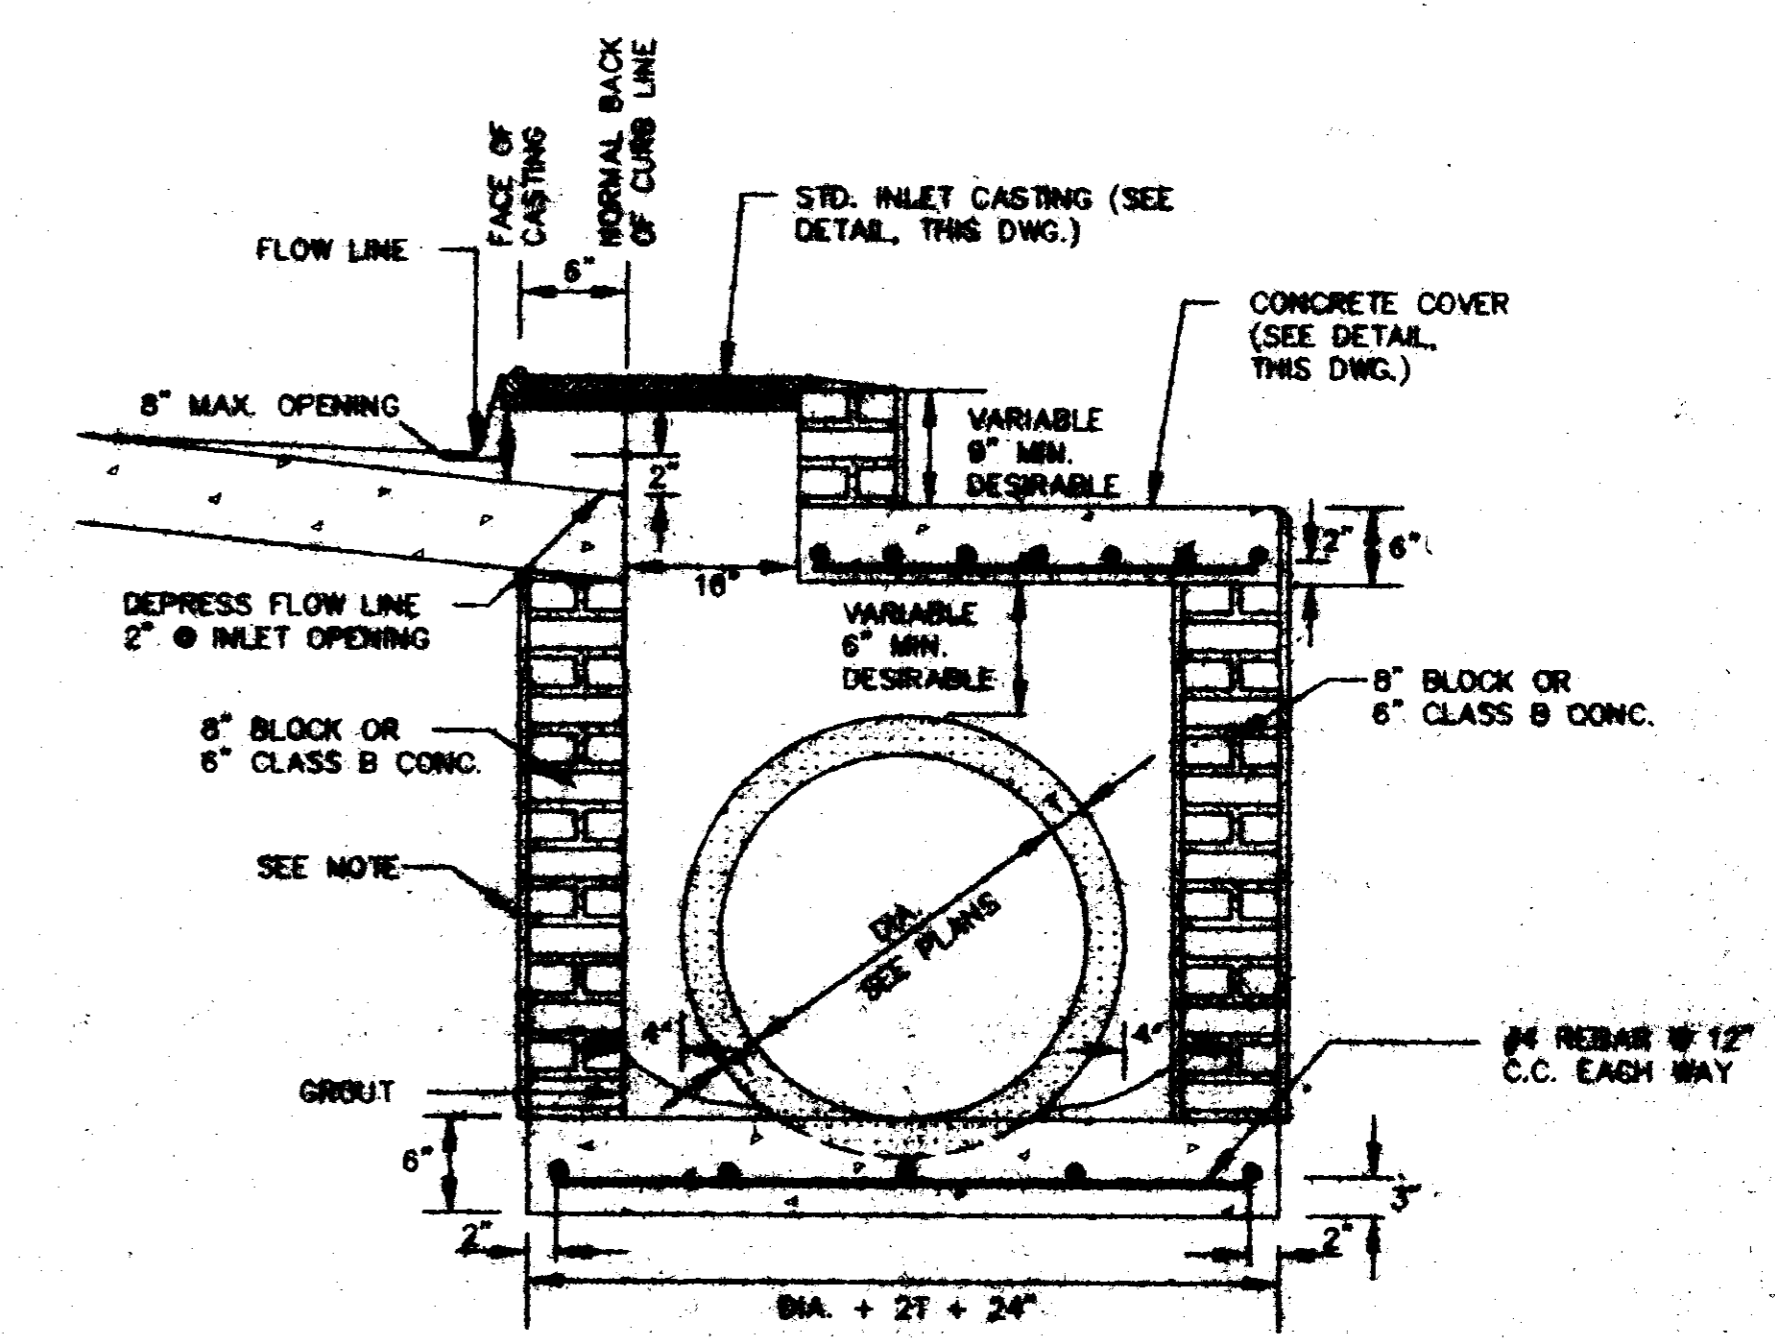

SECTION E - E
TYPE "A" MODIFIED

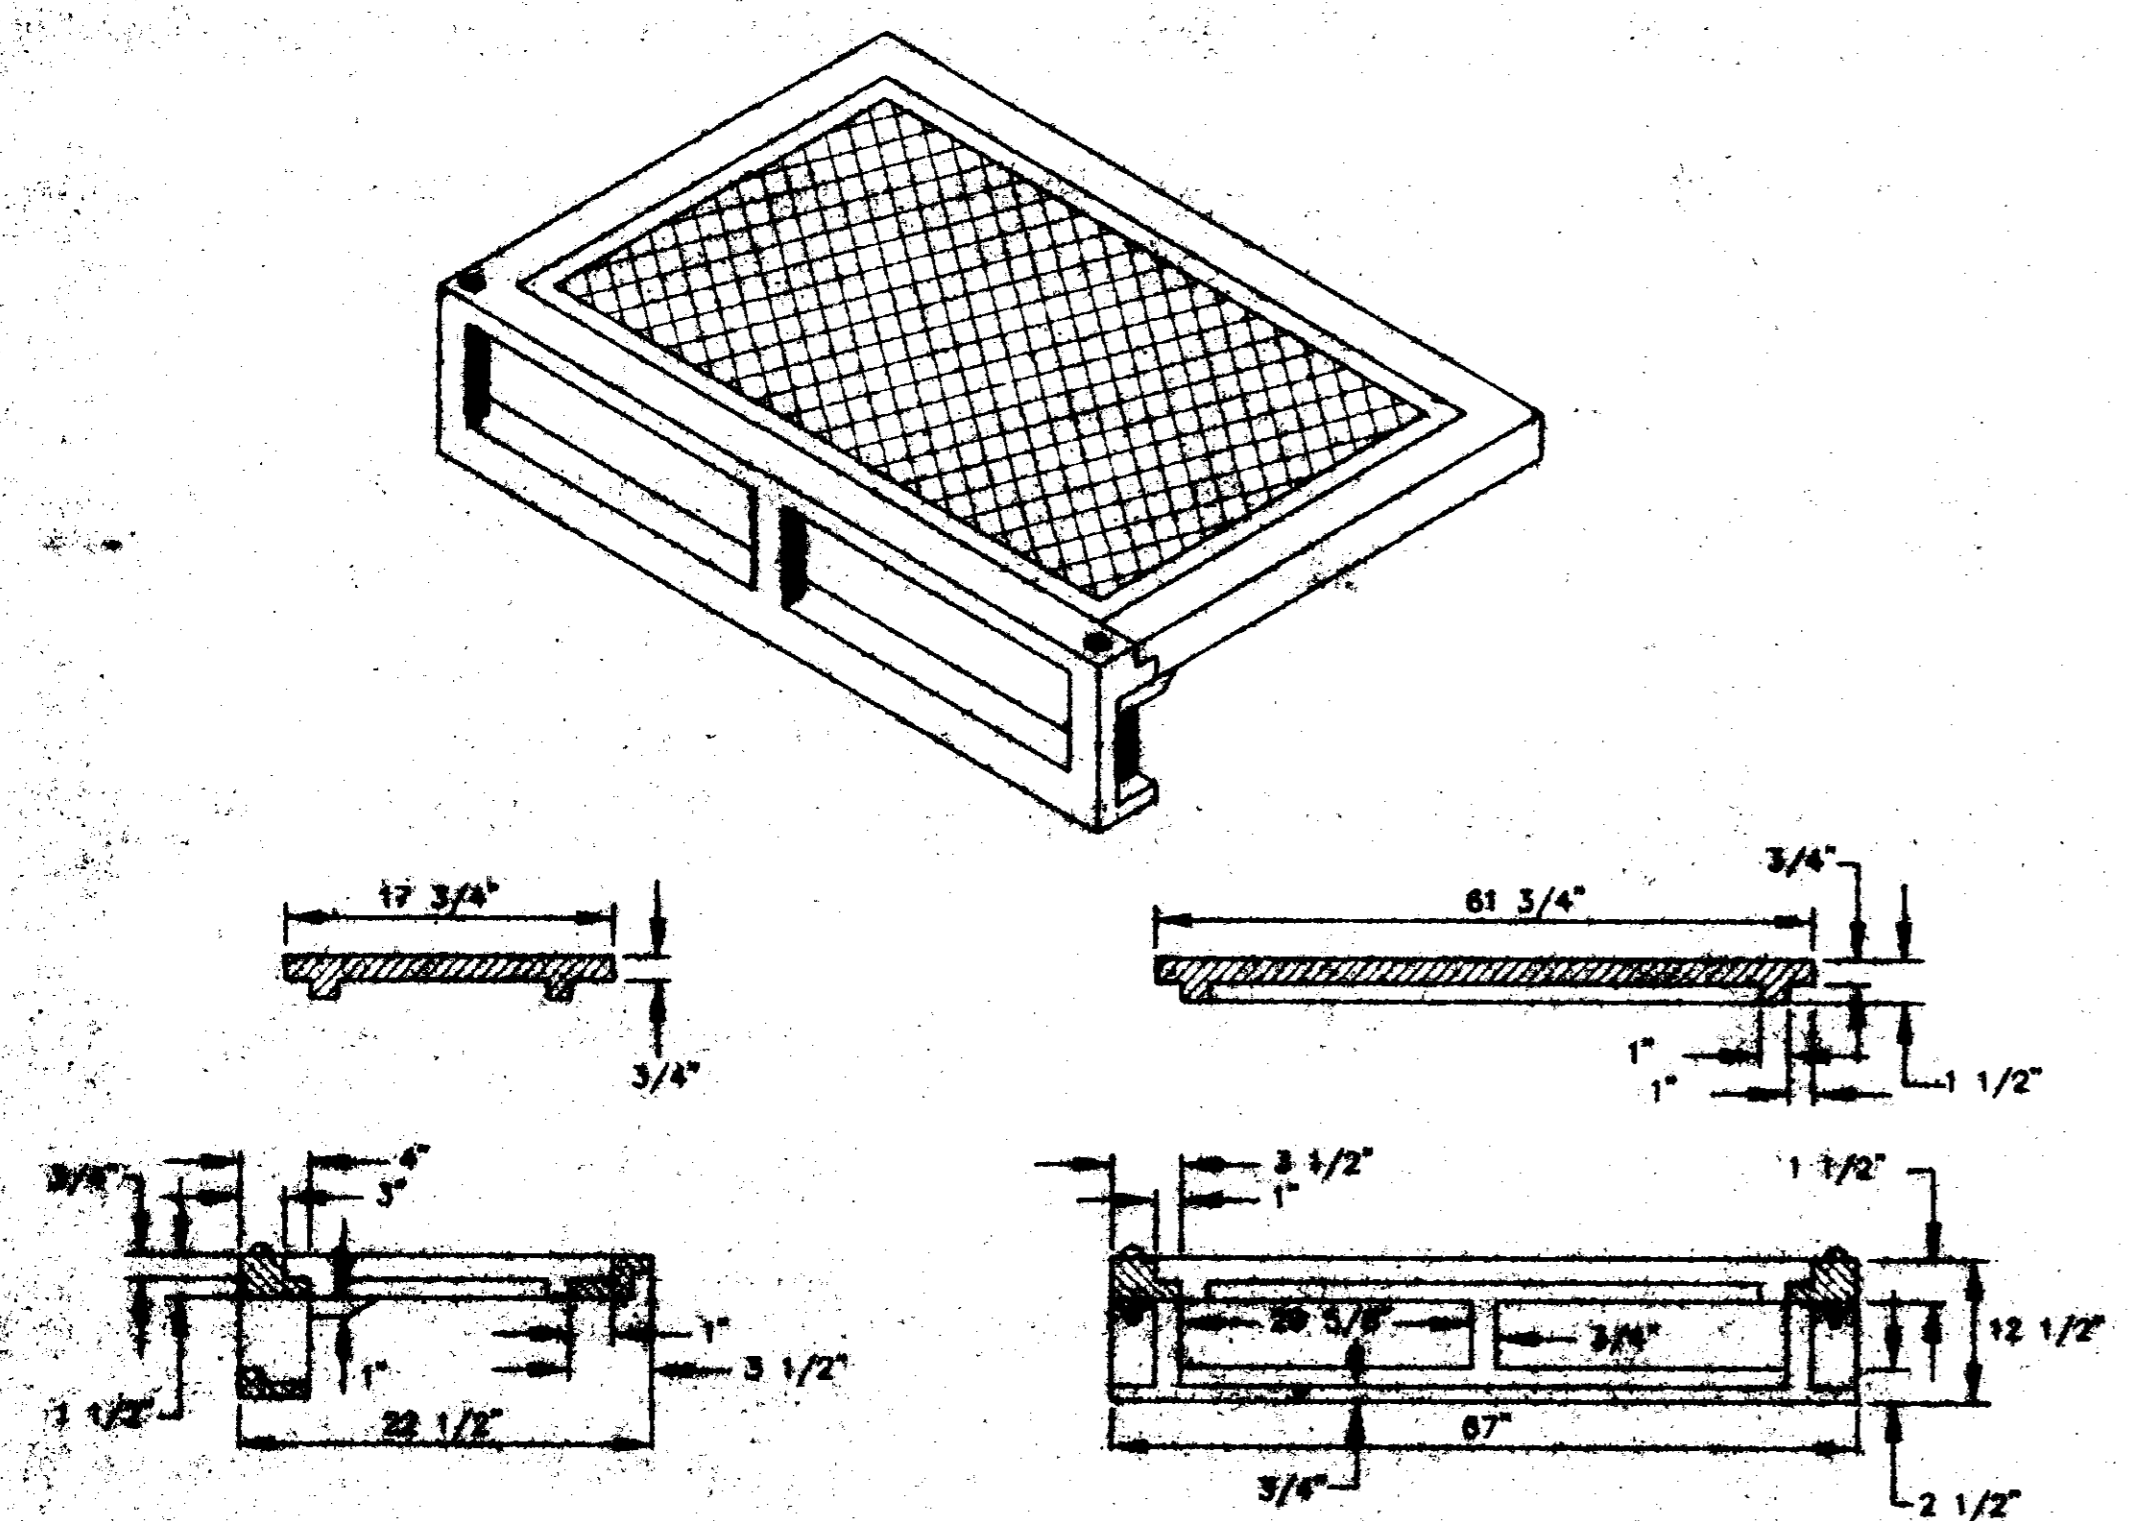

STANDARD CURB INLET CASTING

(VULCAN 4543-2)
N.T.S.


NOTE: CONTRACTOR MAY USE PRECAST CONCRETE INLETS

DESIGNED BY	CHECKED BY	DATE


Chief Consultant, Inc.
ENGINEERING ARCHITECTS AND SURVEYORS
10000 W. CENTRAL EXPRESSWAY • P.O. BOX 1000 • DENVER, CO 80202
(303) 751-4300 • FAX (303) 751-4301

THE COMMONS, PHASE 1


STORM DRAIN DETAILS

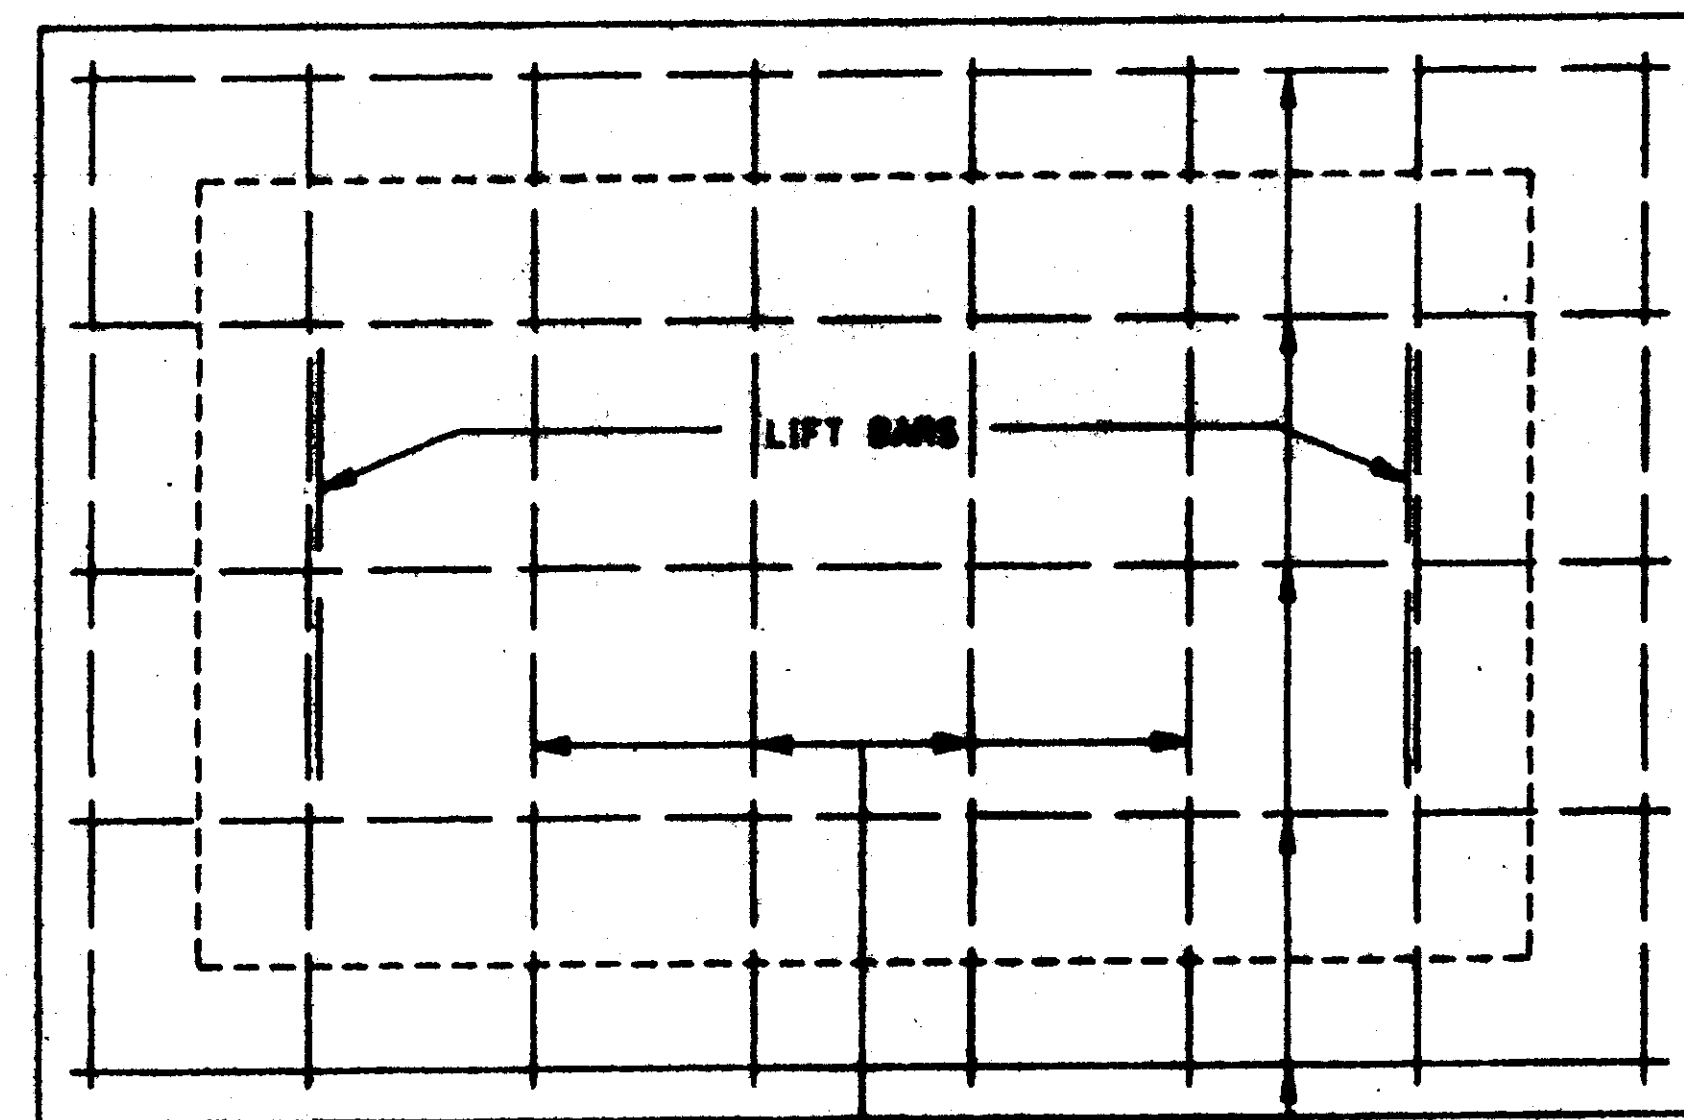

PLAN OF COVER

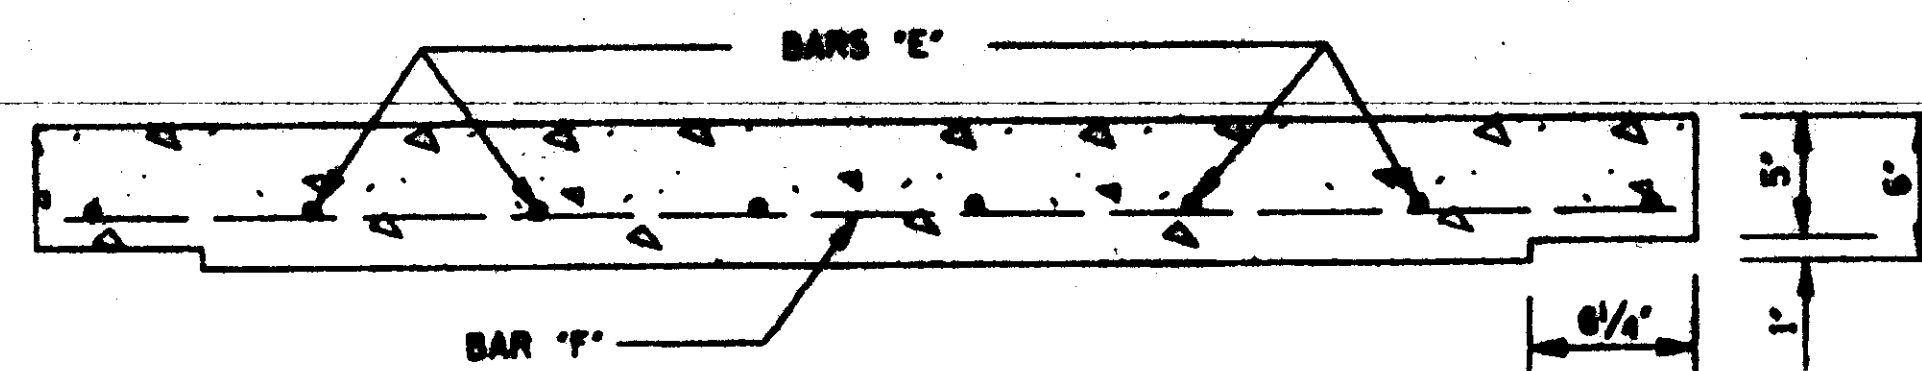

ELEVATION OF COVER

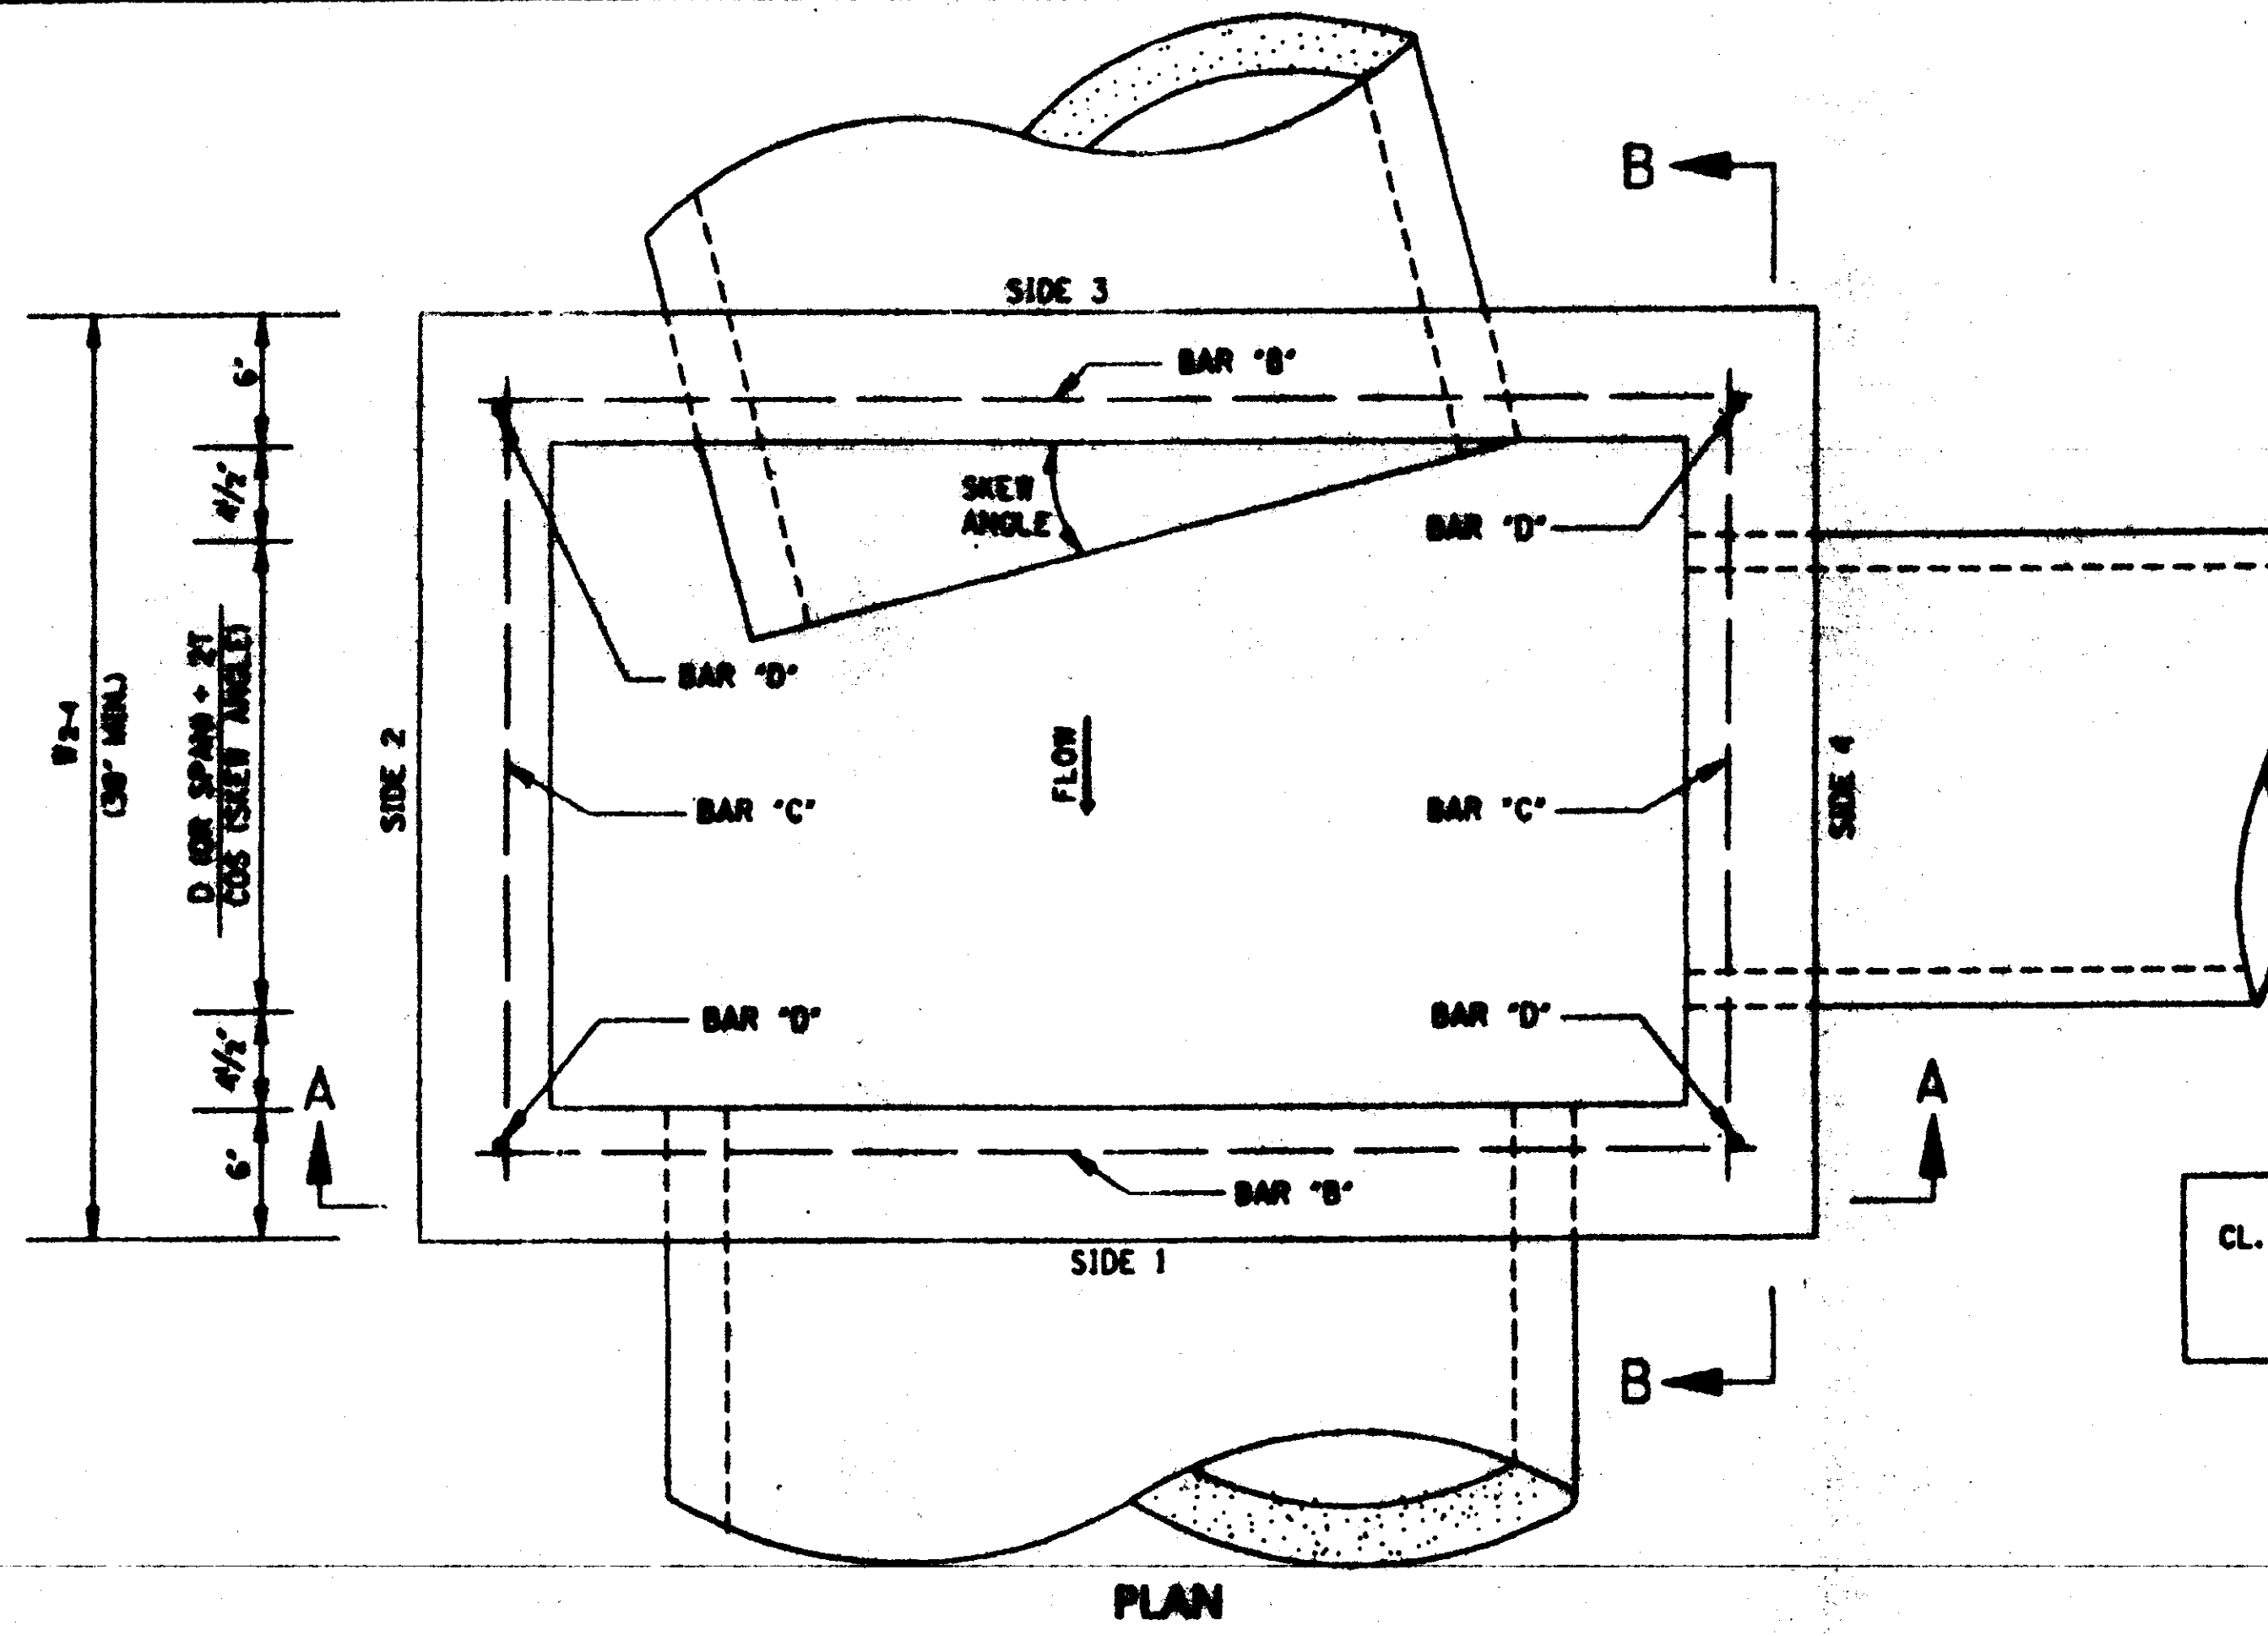

PLAN


BAR	SIZE	NUMBER REQUIRED	LENGTH
A	#4	2 PER PIPE OPENING	$\sqrt{196 + (W_1 + 2)^2}$
B	#4	2	$W_{1-3} - 6'$
C	#4	2	$W_{2-4} - 6'$
D	#4	4	$H - 6'$
E	#4	$2 \left[\left(\frac{W_{1-3}}{2} \right)^2 + 1 \right]$	$W_{2-4} - 4'$
F	#4	$2 \left[\left(\frac{W_{2-4}}{2} \right)^2 + 1 \right]$	$W_{1-3} - 4'$

NOTE: VARIABLES AND DESIGNATIONS ARE AS FOLLOWS:
 D (OR SPAN) = PIPE DIAMETER (OR SPAN)
 W₁₋₃ = WIDTH OF SIDE 1 & SIDE 3
 W₂₋₄ = WIDTH OF SIDE 2 & SIDE 4
 H = HEIGHT OF COVER
 #4 = #4 REINFORCING BAR
 ° = ROUND TO NEAREST WHOLE NUMBER


CL. "B" CONC. (yd³) = $0.01 + 0.021 / 46,656 [1 - \sum \text{PIPE OPENING DEDUCTIONS}]$
 WHERE: $Q_1 = [5'W_{1-3}W_{2-4}] + [1'(W_{1-3} - 12.5'W_{2-4} - 12.5'W_{1-3}) + (T_1 + 6'W_{1-3}W_{2-4})]$
 $Q_2 = 12'WH - (T_1 + 6')(W_{1-3} - 12') + W_{2-4}$

CIRCULAR PIPE			ARCH PIPE		
PIPE SIZE	T	PIPE OPENING DEDUCTION (yd ³)	PIPE SIZE	T	PIPE OPENING DEDUCTION (yd ³)
18"	2 1/2"	0.053	22" x 13"	2 1/2"	0.053
24"	3"	0.091	28" x 18"	3"	0.097
30"	3 1/2"	0.138	36" x 23"	3 1/2"	0.129
36"	4"	0.196	44" x 27"	4"	0.185
42"	4 1/2"	0.263	51" x 31"	4 1/2"	0.245
48"	5"	0.340	58" x 36"	5"	0.318
54"	5 1/2"	0.427	65" x 40"	5 1/2"	0.394
60"	6"	0.524	73" x 45"	6"	0.489
66"	6 1/2"	0.630			
72"	7"	0.747			


- GENERAL NOTES:
1. REINFORCING STEEL QUANTITIES TO BE COMPUTED FROM BAR LIST AND SHOWN ELSEWHERE ON THE PLANS.
 2. QUANTITIES FOR JUNCTION BOXES SHOWN ON THE PLANS WILL BE THE BASIS FOR PAYMENT UNLESS AUTHORIZED MODIFICATIONS ARE MADE.
 3. CONCRETE SHALL BE CLASS "B" AND REINFORCING STEEL SHALL BE DEFORMED BARS.
 4. SIDE 1 OF THE JUNCTION BOX WILL ALWAYS BE THE OUTFLOW SIDE.
 5. IF PIPES ARE SKEWED MORE THAN 15° OR IF SKEWED PIPES PRODUCE CONFLICTS WITH ANOTHER OPENING, THE PIPE SHALL BE BROKEN BACK TO THE WALL OF THE JUNCTION BOX.

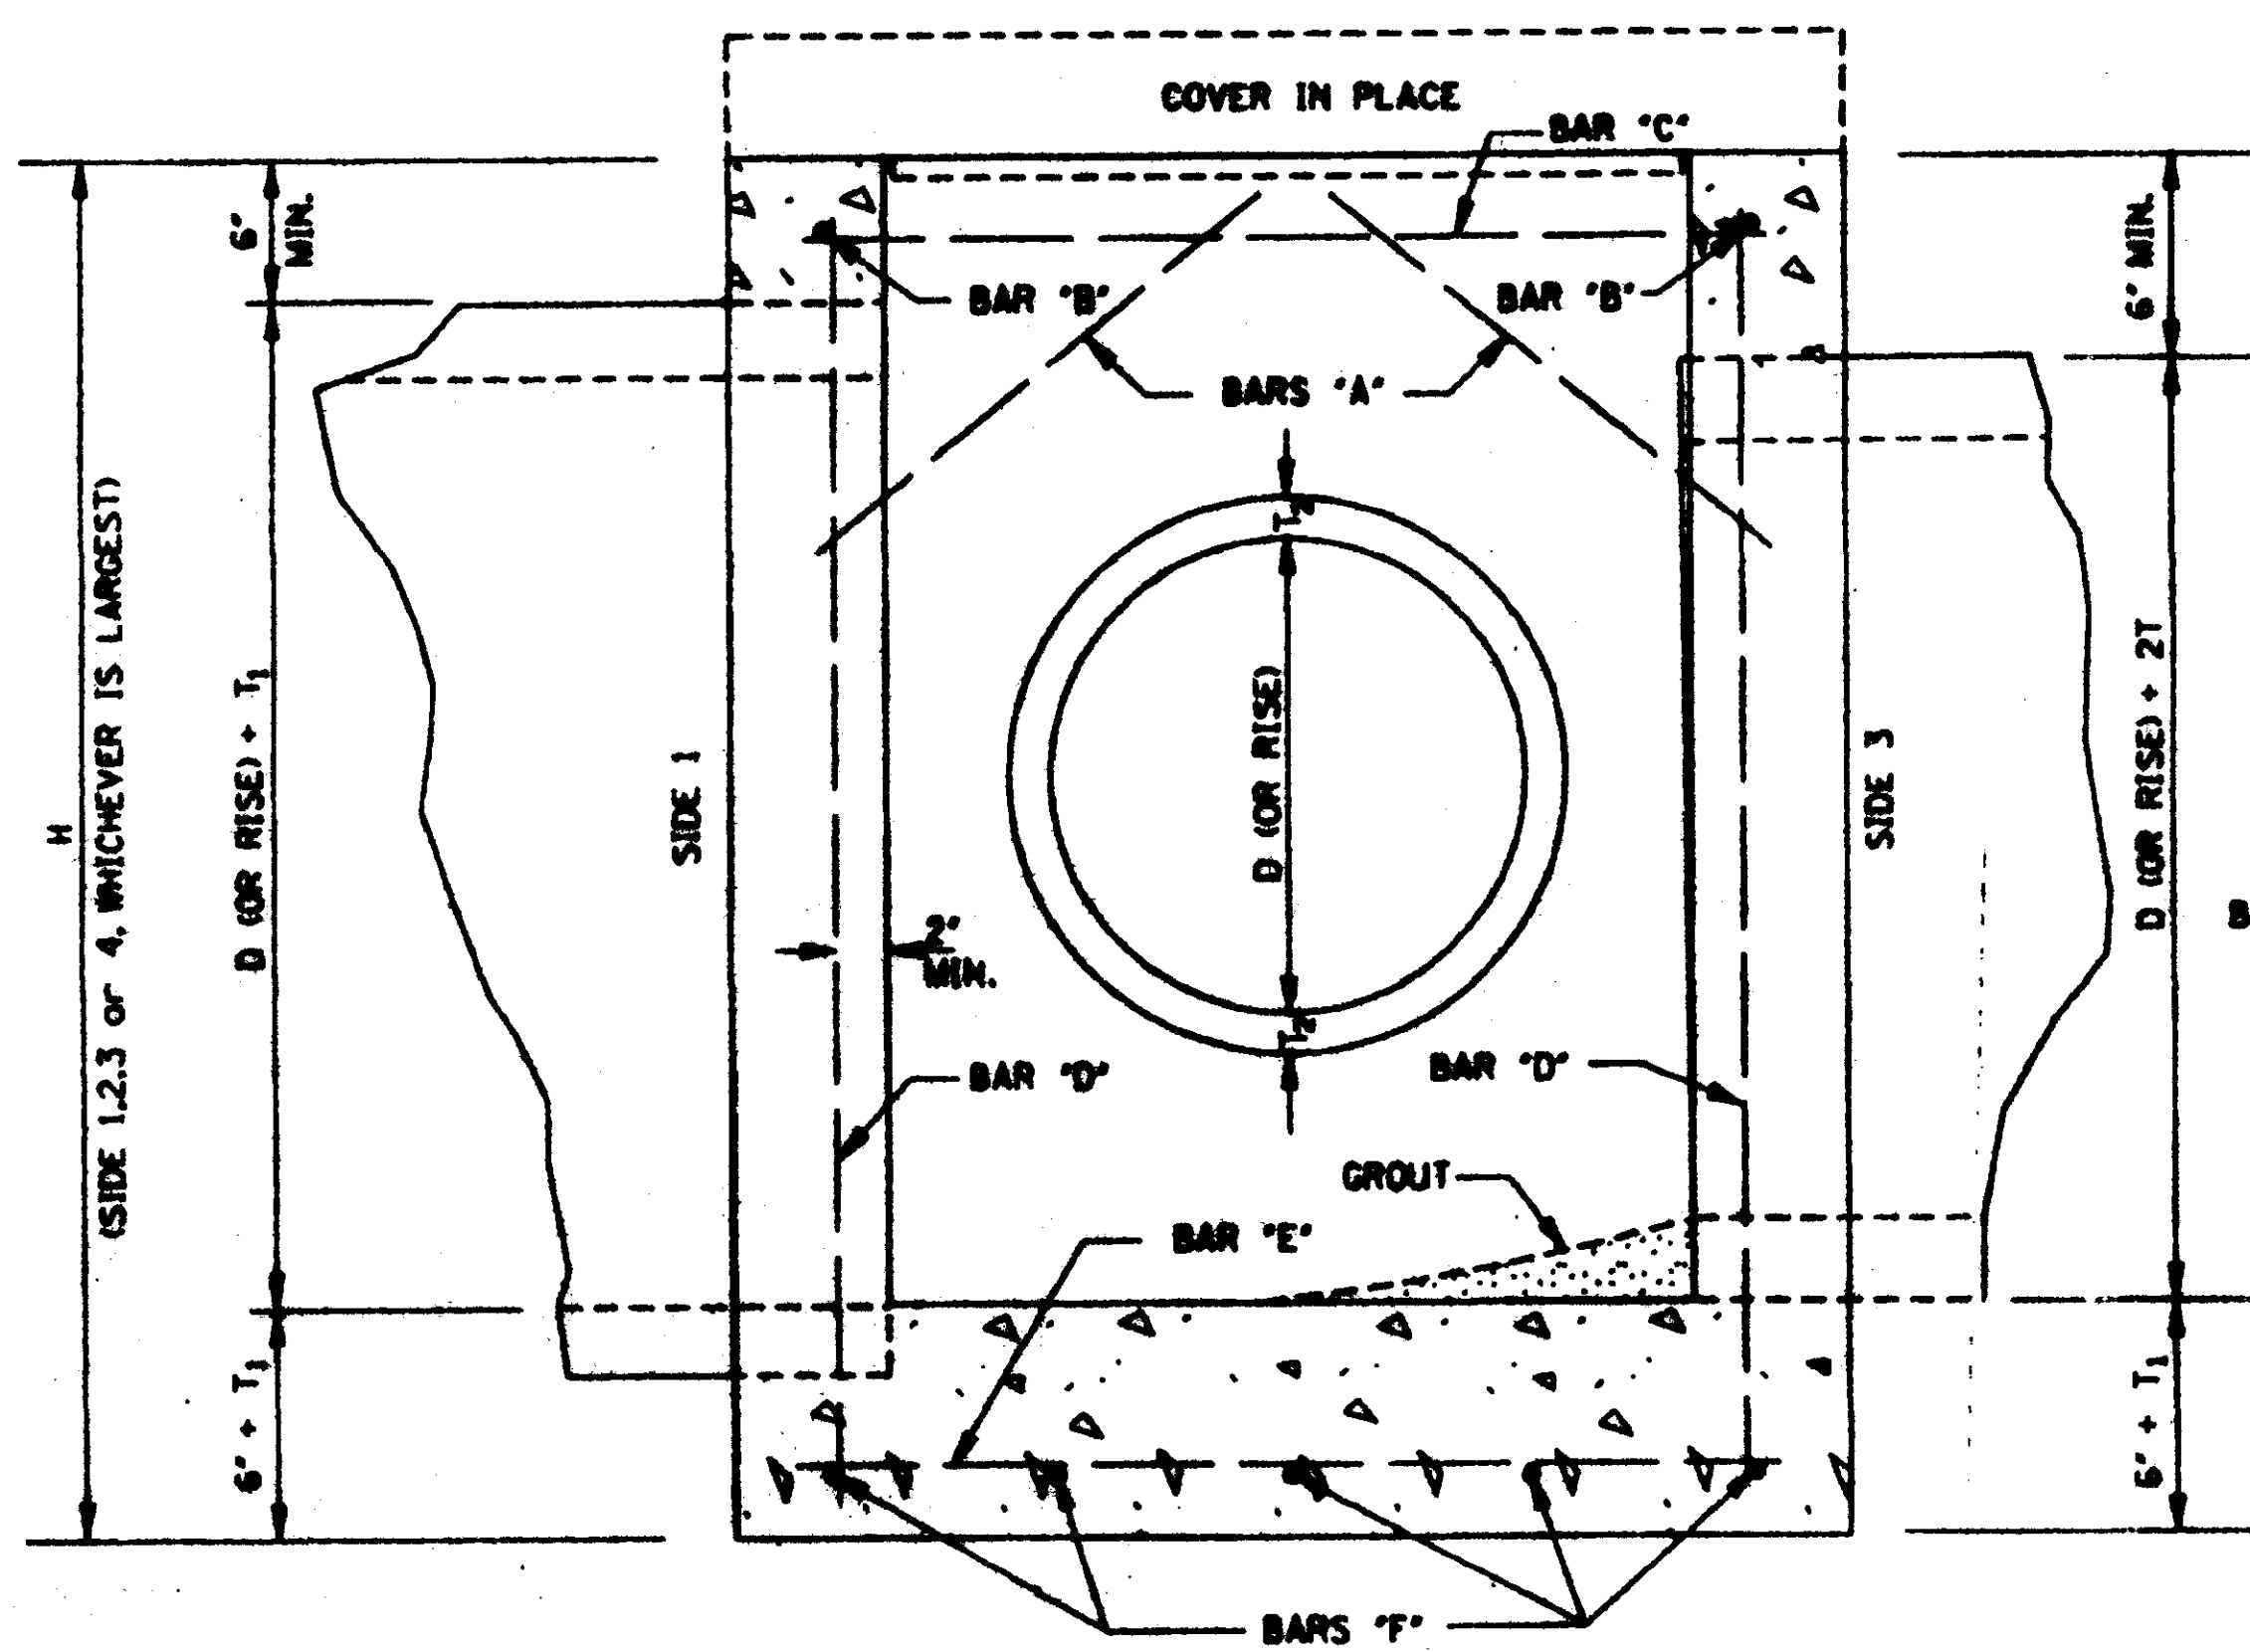

SECTION B-B

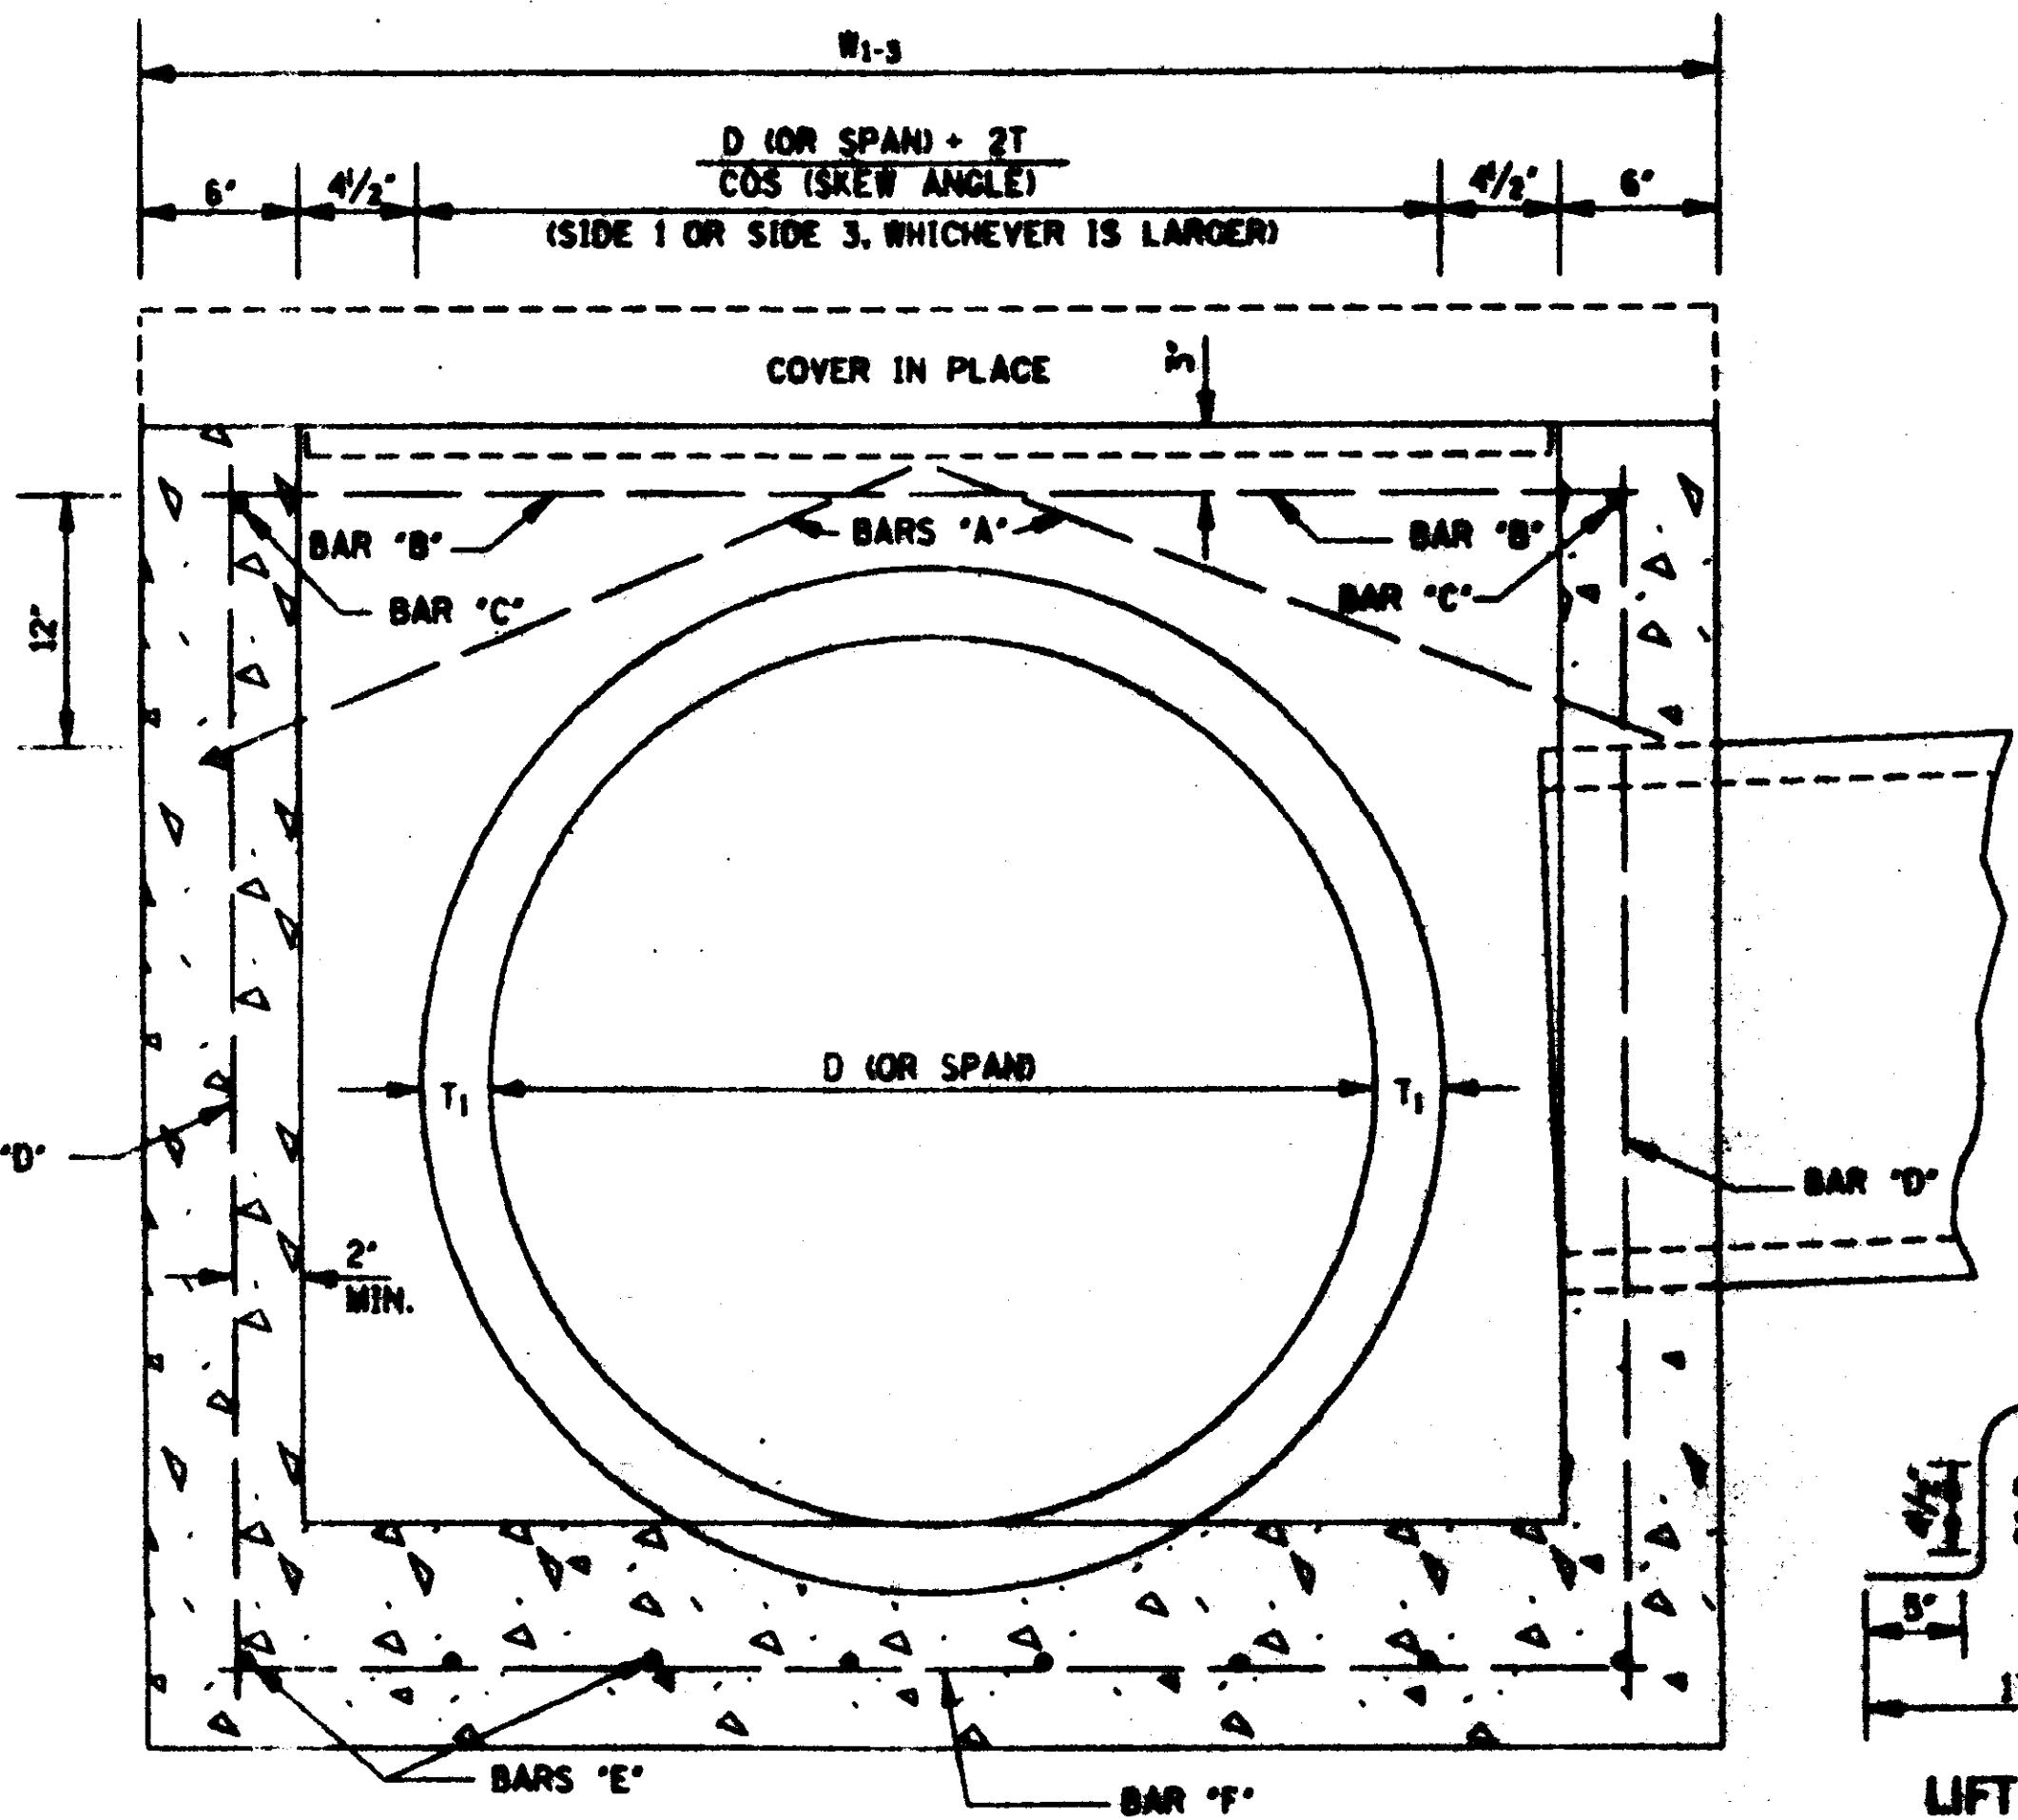

SECTION A-A

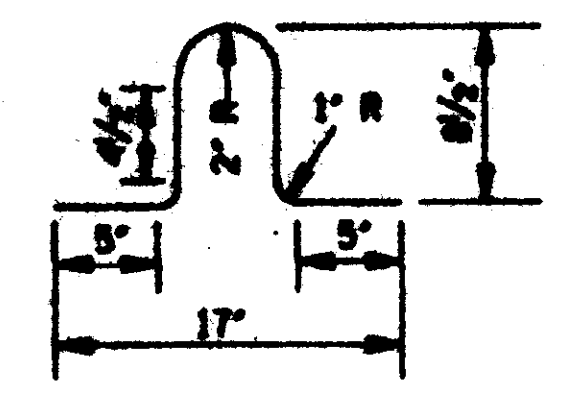


LIFT BAR
 NOTE: LIFT BAR TO BE FABRICATED FROM A #4 BAR 30" LONG. TWO LIFT BARS ARE REQUIRED. REINFORCING STEEL FOR 2 LIFT BARS = 3.3 lbs.

MISSISSIPPI DEPARTMENT OF TRANSPORTATION
 ROADWAY DESIGN DIVISION
 STANDARD PLAN

JUNCTION BOX FOR PIPE CULVERTS


ISSUE DATE: OCTOBER 1, 1998

WORKING NUMBER: JB-1
 SHEET NUMBER: 1

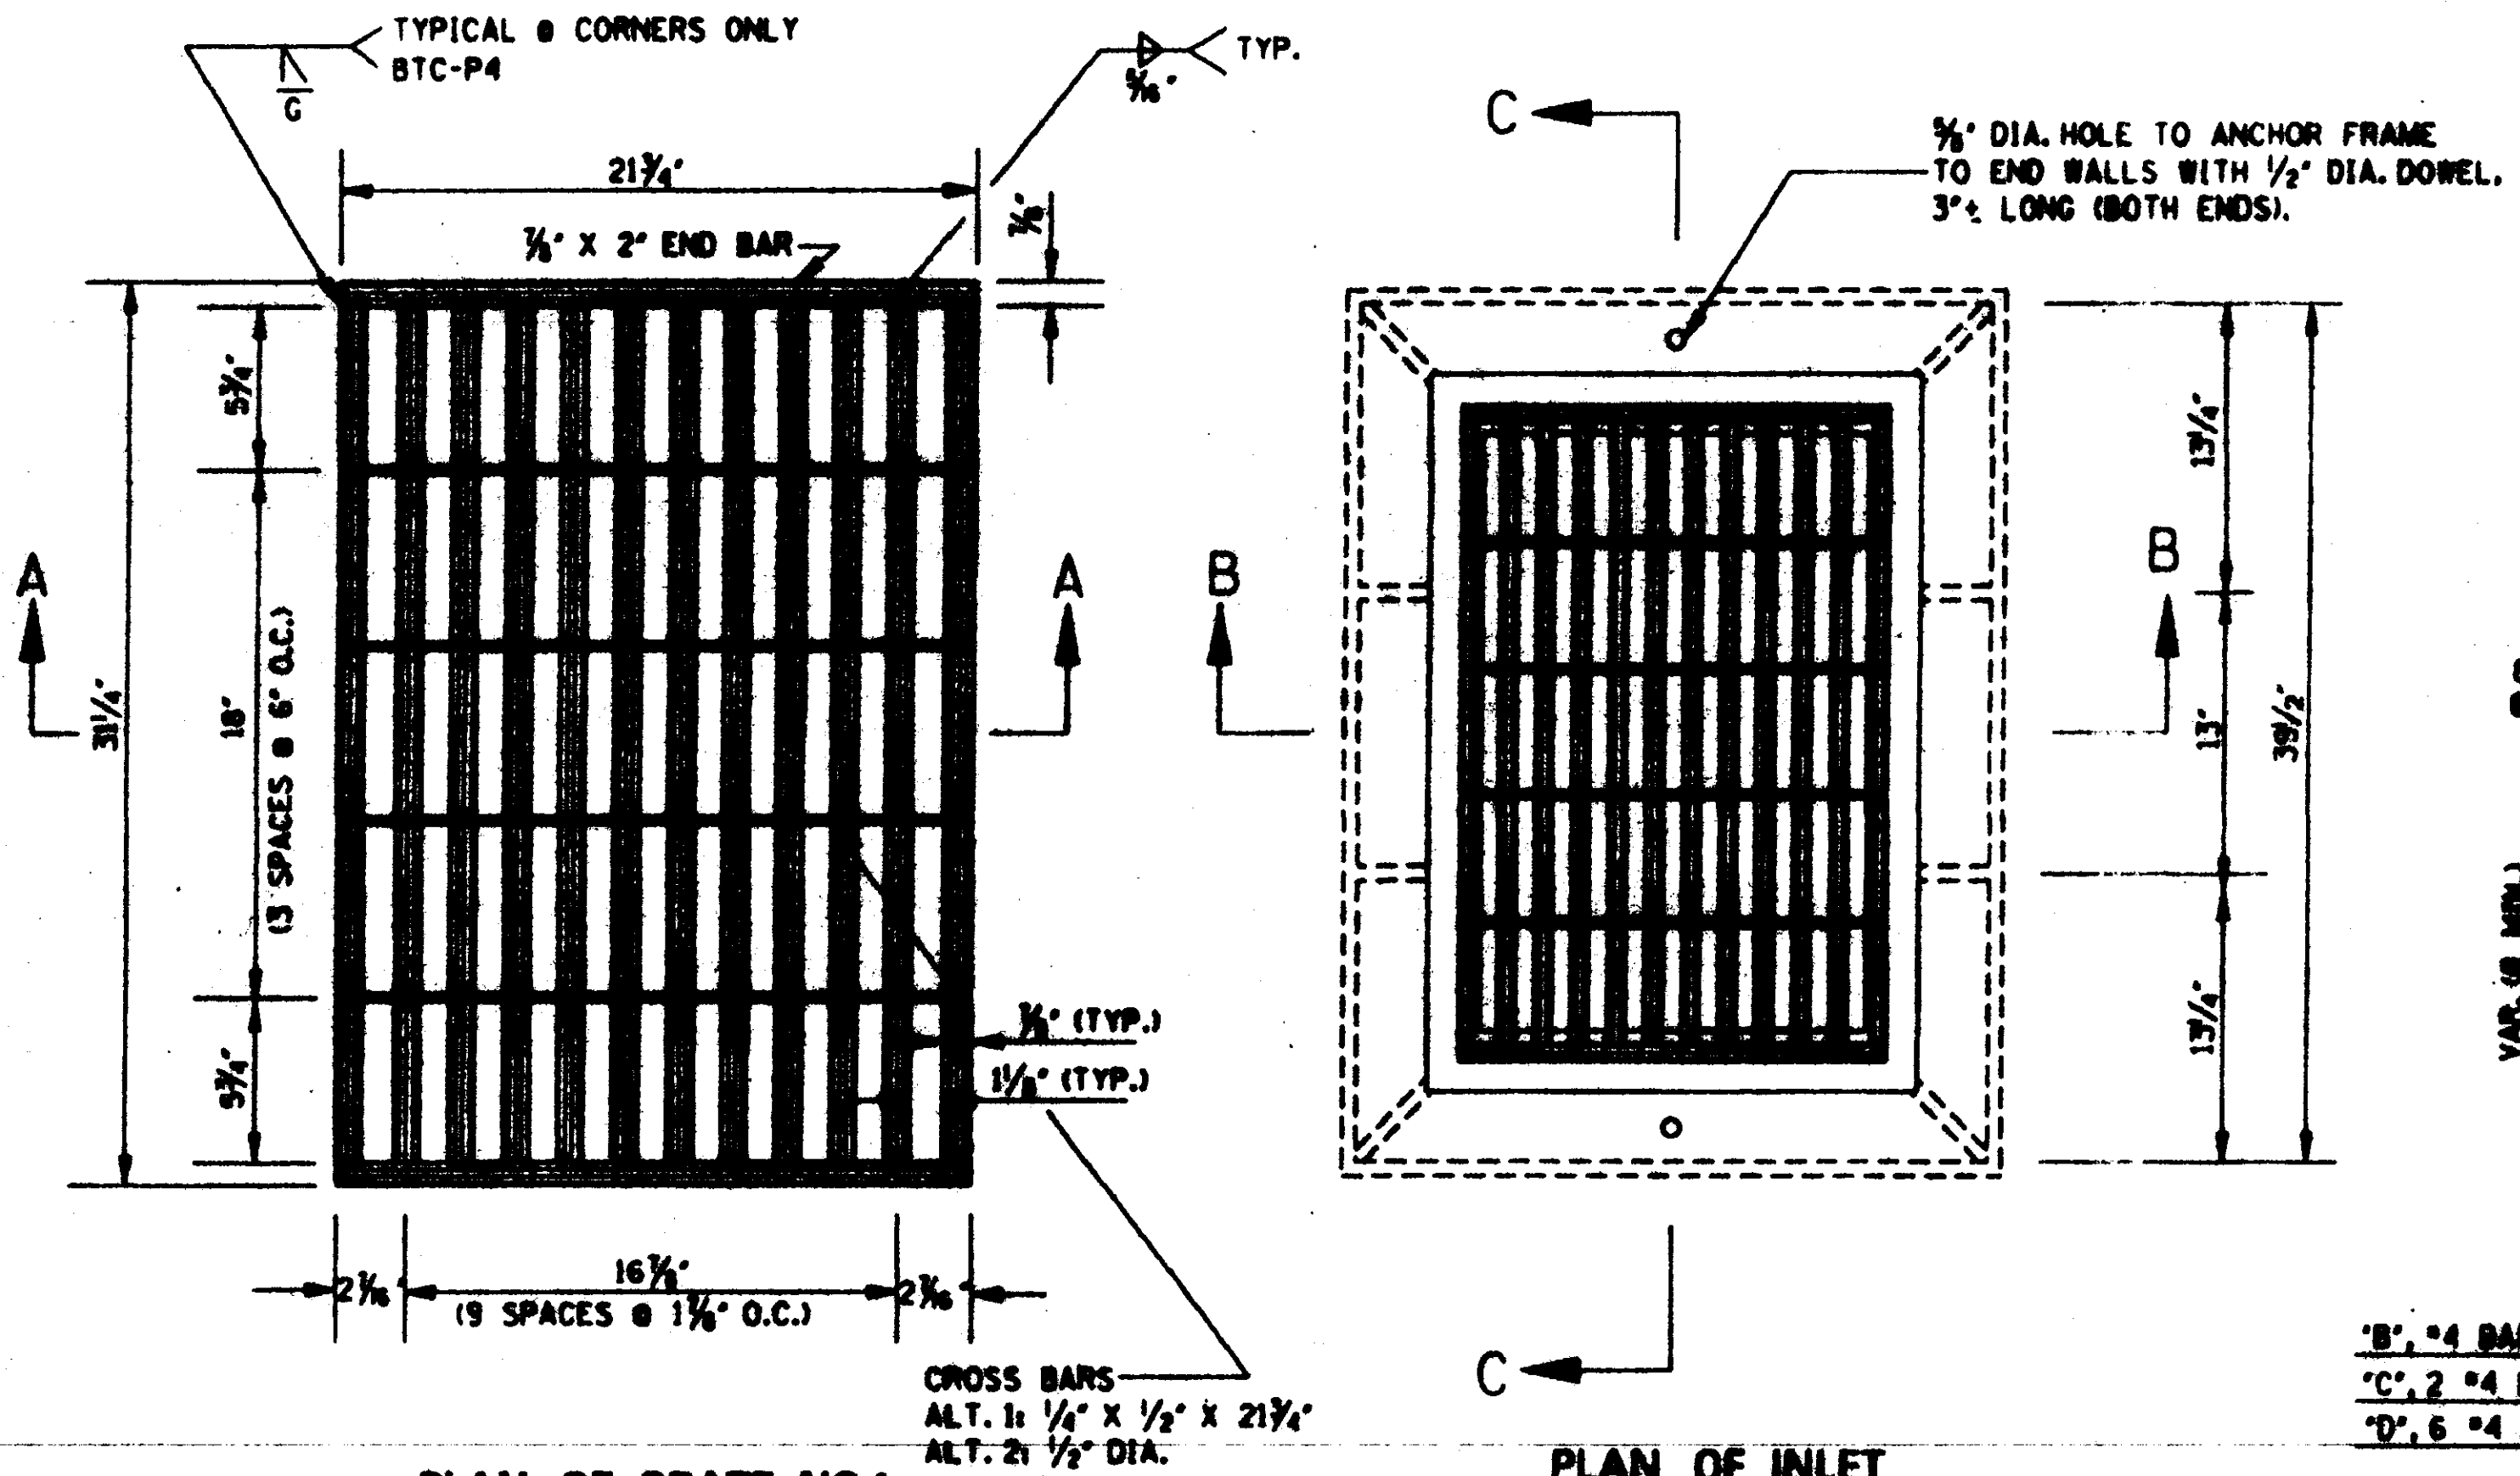

PLAN OF GRATE NO. 1
NOTE: FOR OTHER GRATE DETAILS SEE SHEET IG-2.


PLAN OF INLET

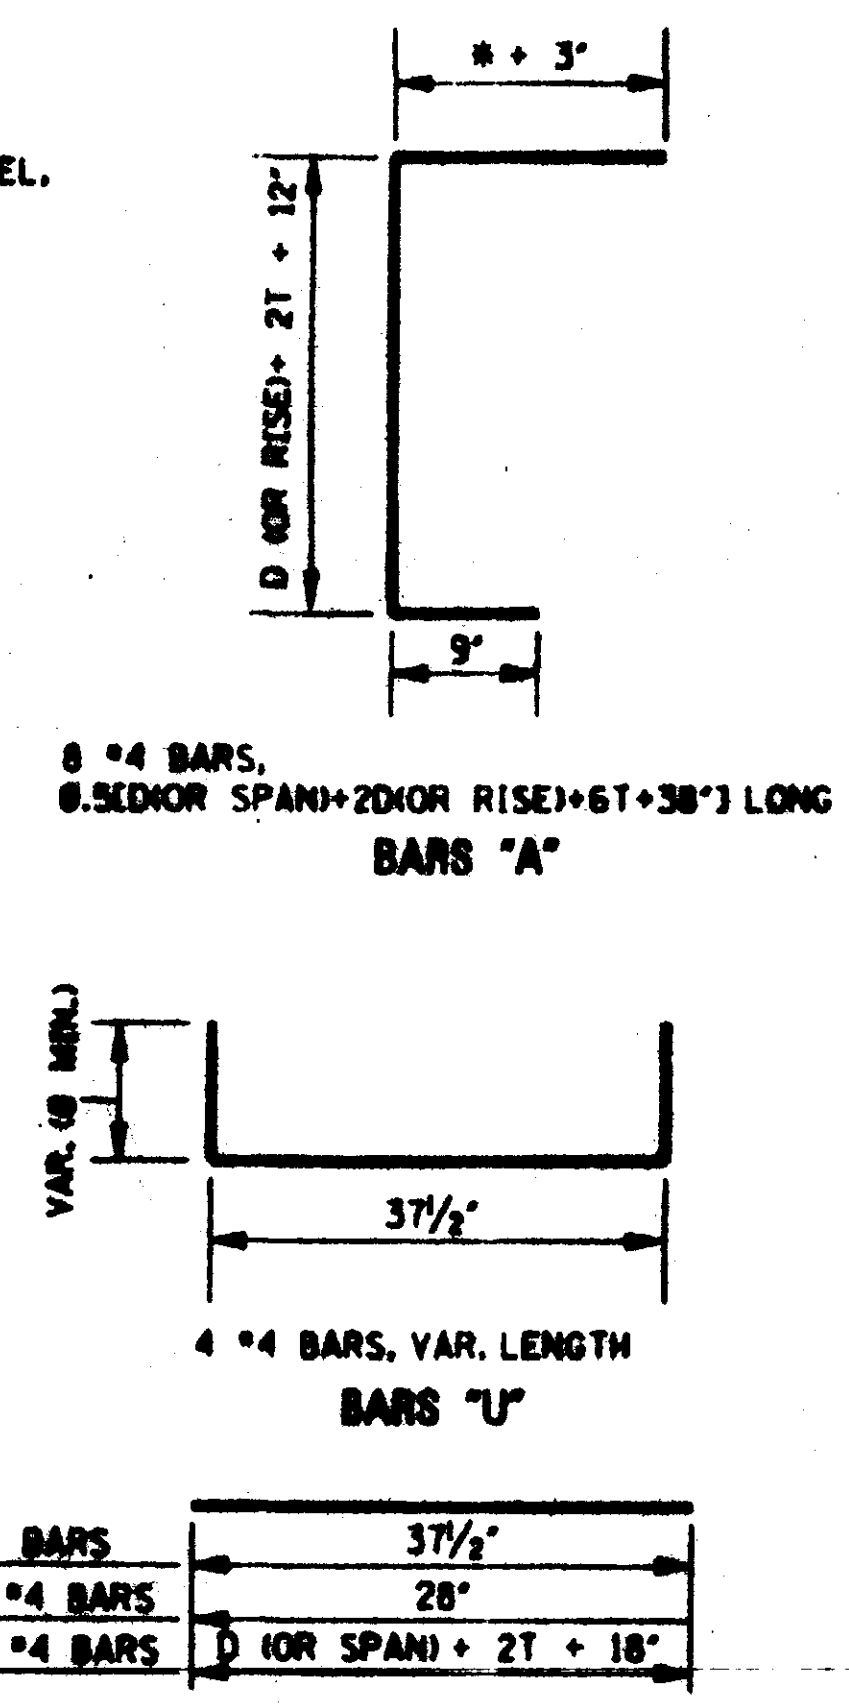


*NOTE:
* $\frac{D \text{ (OR SPAN)} + 2T - 18''}{2}$

PIPE SIZE	MIN. DEPTH TO F.L.	MIN. DEPTH INLET		PIPE OPENING DEDUCTION (yd ³)	T	BARS/SIZES				
		CONC. (yd ³)	STEEL (lbs)			'A'	'B'	'C'	'D'	'U'
						NO. LGTH.	NO. LGTH.	NO. LGTH.	NO. LGTH.	NO. LGTH.
18"	2.752	0.009	76	0.053	2 1/2'	8 @ 4'-3/4"	12 @ 3'-1 1/2"	2 @ 2'-4"	6 @ 3'-5"	4 @ 3'-9/2"
24"	3.234	1.117	87	0.091	3'	8 @ 5'-4"	14 @ 3'-1 1/2"	2 @ 2'-4"	6 @ 4'-0"	4 @ 3'-9/2"
30"	3.676	1.308	94	0.130	3 1/2'	8 @ 6'-2 1/2"	14 @ 3'-1 1/2"	2 @ 2'-4"	6 @ 4'-7"	4 @ 3'-9/2"
36"	4.427	1.671	105	0.196	4'	8 @ 7'-1"	16 @ 3'-1 1/2"	2 @ 2'-4"	6 @ 5'-2"	4 @ 3'-9/2"
42"	4.988	1.978	116	0.263	4 1/2'	8 @ 7'-11 1/2"	18 @ 3'-1 1/2"	2 @ 2'-4"	6 @ 5'-9"	4 @ 3'-9/2"
48"	5.508	2.305	123	0.340	5'	8 @ 8'-10"	18 @ 3'-1 1/2"	2 @ 2'-4"	6 @ 6'-4"	4 @ 3'-9/2"
54"	6.042	2.650	135	0.427	5 1/2'	8 @ 9'-8 1/2"	20 @ 3'-1 1/2"	2 @ 2'-4"	6 @ 6'-11"	4 @ 3'-9/2"
60"	6.583	3.016	146	0.524	6'	8 @ 10'-7"	22 @ 3'-1 1/2"	2 @ 2'-4"	6 @ 7'-6"	4 @ 3'-9/2"
66"	7.125	3.402	153	0.630	6 1/2'	8 @ 11'-5 1/2"	22 @ 3'-1 1/2"	2 @ 2'-4"	6 @ 8'-1"	4 @ 3'-9/2"
72"	7.667	3.806	164	0.747	7'	8 @ 12'-4"	24 @ 3'-1 1/2"	2 @ 2'-4"	6 @ 8'-8"	4 @ 3'-9/2"
22" X 13"	2.417	0.055	76	0.053	2 1/2'	8 @ 4'-3"	12 @ 3'-1 1/2"	2 @ 2'-4"	6 @ 3'-9"	4 @ 3'-9/2"
29" X 18"	2.833	1.005	83	0.067	3'	8 @ 5'-0 1/4"	12 @ 3'-1 1/2"	2 @ 2'-4"	6 @ 4'-4 1/2"	4 @ 3'-9/2"
36" X 23"	3.250	1.350	94	0.129	3 1/2'	8 @ 5'-10"	14 @ 3'-1 1/2"	2 @ 2'-4"	6 @ 5'-1"	4 @ 3'-9/2"
44" X 27"	3.635	1.631	101	0.185	4'	8 @ 6'-7 1/2"	14 @ 3'-1 1/2"	2 @ 2'-4"	6 @ 5'-10"	4 @ 3'-9/2"
51" X 31"	4.060	1.942	113	0.245	4 1/2'	8 @ 7'-5 1/2"	16 @ 3'-1 1/2"	2 @ 2'-4"	6 @ 6'-6"	4 @ 3'-9/2"
58" X 36"	4.500	2.269	120	0.316	5'	8 @ 8'-3"	16 @ 3'-1 1/2"	2 @ 2'-4"	6 @ 7'-2 1/2"	4 @ 3'-9/2"
65" X 40"	4.875	2.675	130	0.394	5 1/2'	8 @ 9'-0"	18 @ 3'-1 1/2"	2 @ 2'-4"	6 @ 7'-10"	4 @ 3'-9/2"
73" X 45"	5.333	2.966	139	0.489	6'	8 @ 9'-10 1/2"	18 @ 3'-1 1/2"	2 @ 2'-4"	6 @ 8'-7"	4 @ 3'-9/2"
80" X 54"	6.167	3.765	156	0.688	7'	8 @ 11'-6"	20 @ 3'-1 1/2"	2 @ 2'-4"	6 @ 10'-0"	4 @ 3'-9/2"


NOTES: 1. ONE (1) PIPE OPENING HAS BEEN DEDUCTED FROM THE STRUCTURE.
2. FOR EACH ADDITIONAL FOOT OF INLET HEIGHT, ADD 0.104 yd³ CLASS 'B' CONCRETE AND 17 lbs REINFORCING STEEL.
3. 4 BARS 'B' AND 2 BARS 'C' REQUIRED PER EACH ADDITIONAL FOOT OF INLET HEIGHT.
4. WEIGHT OF FRAME CASTING = 244 lbs.
WEIGHT OF GRATE = SEE SHEET IG-2.

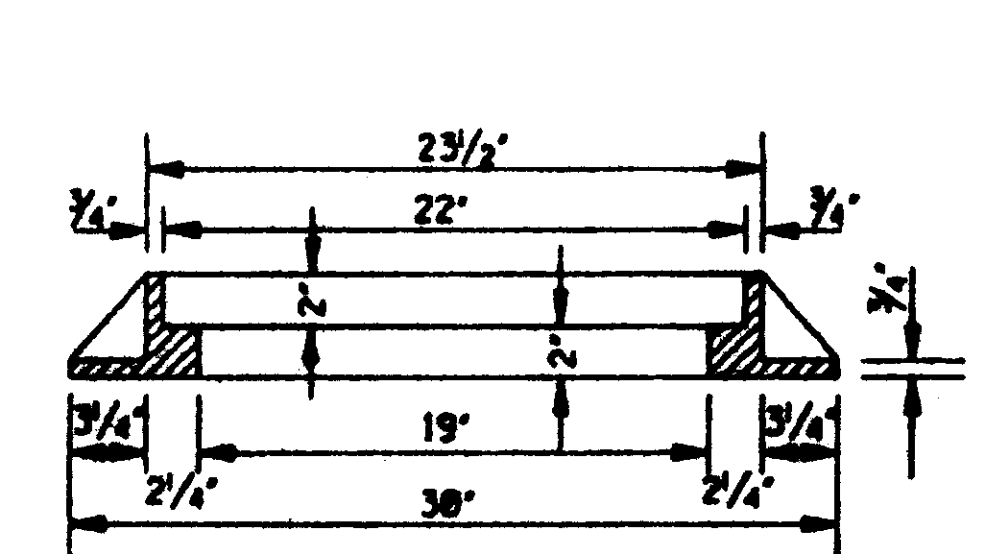


SECTION B-B (FRAME)

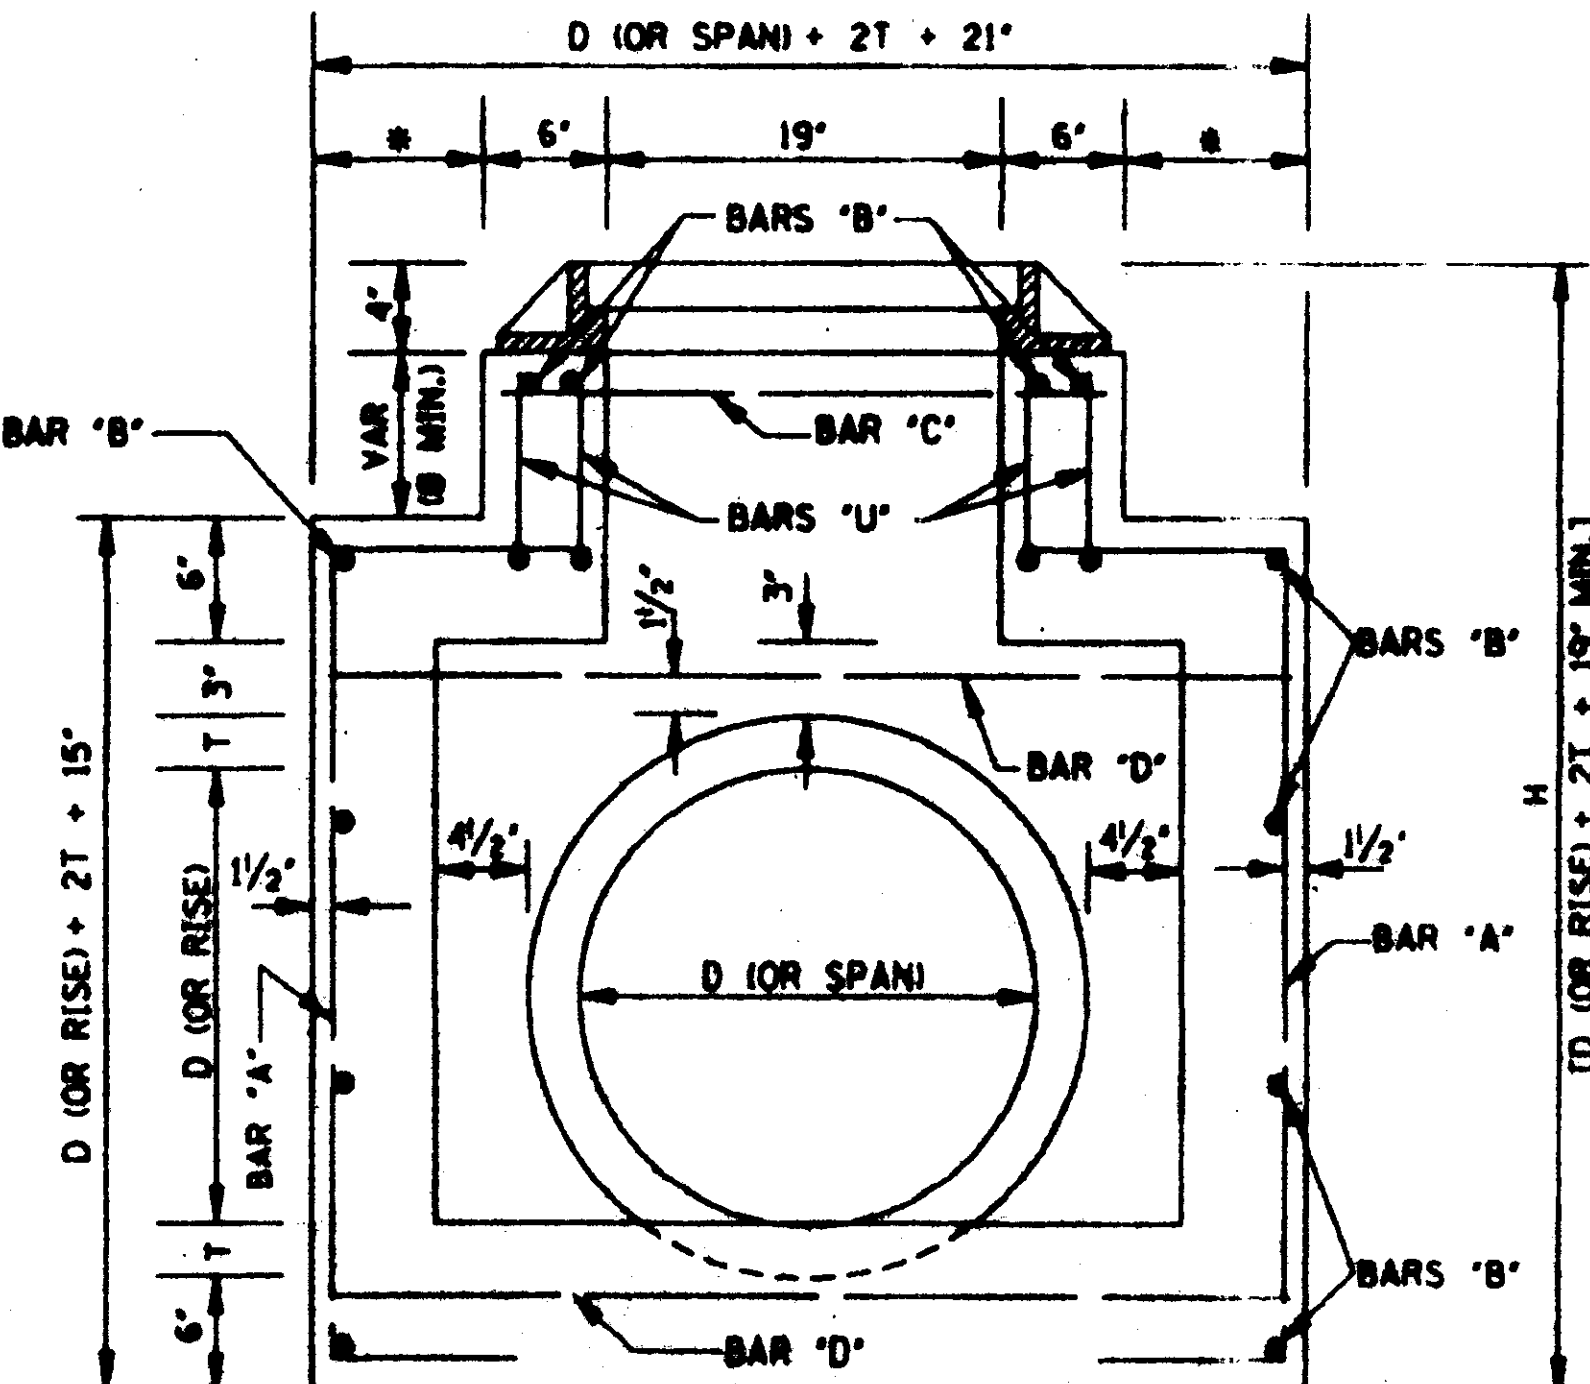

SECTION B-B

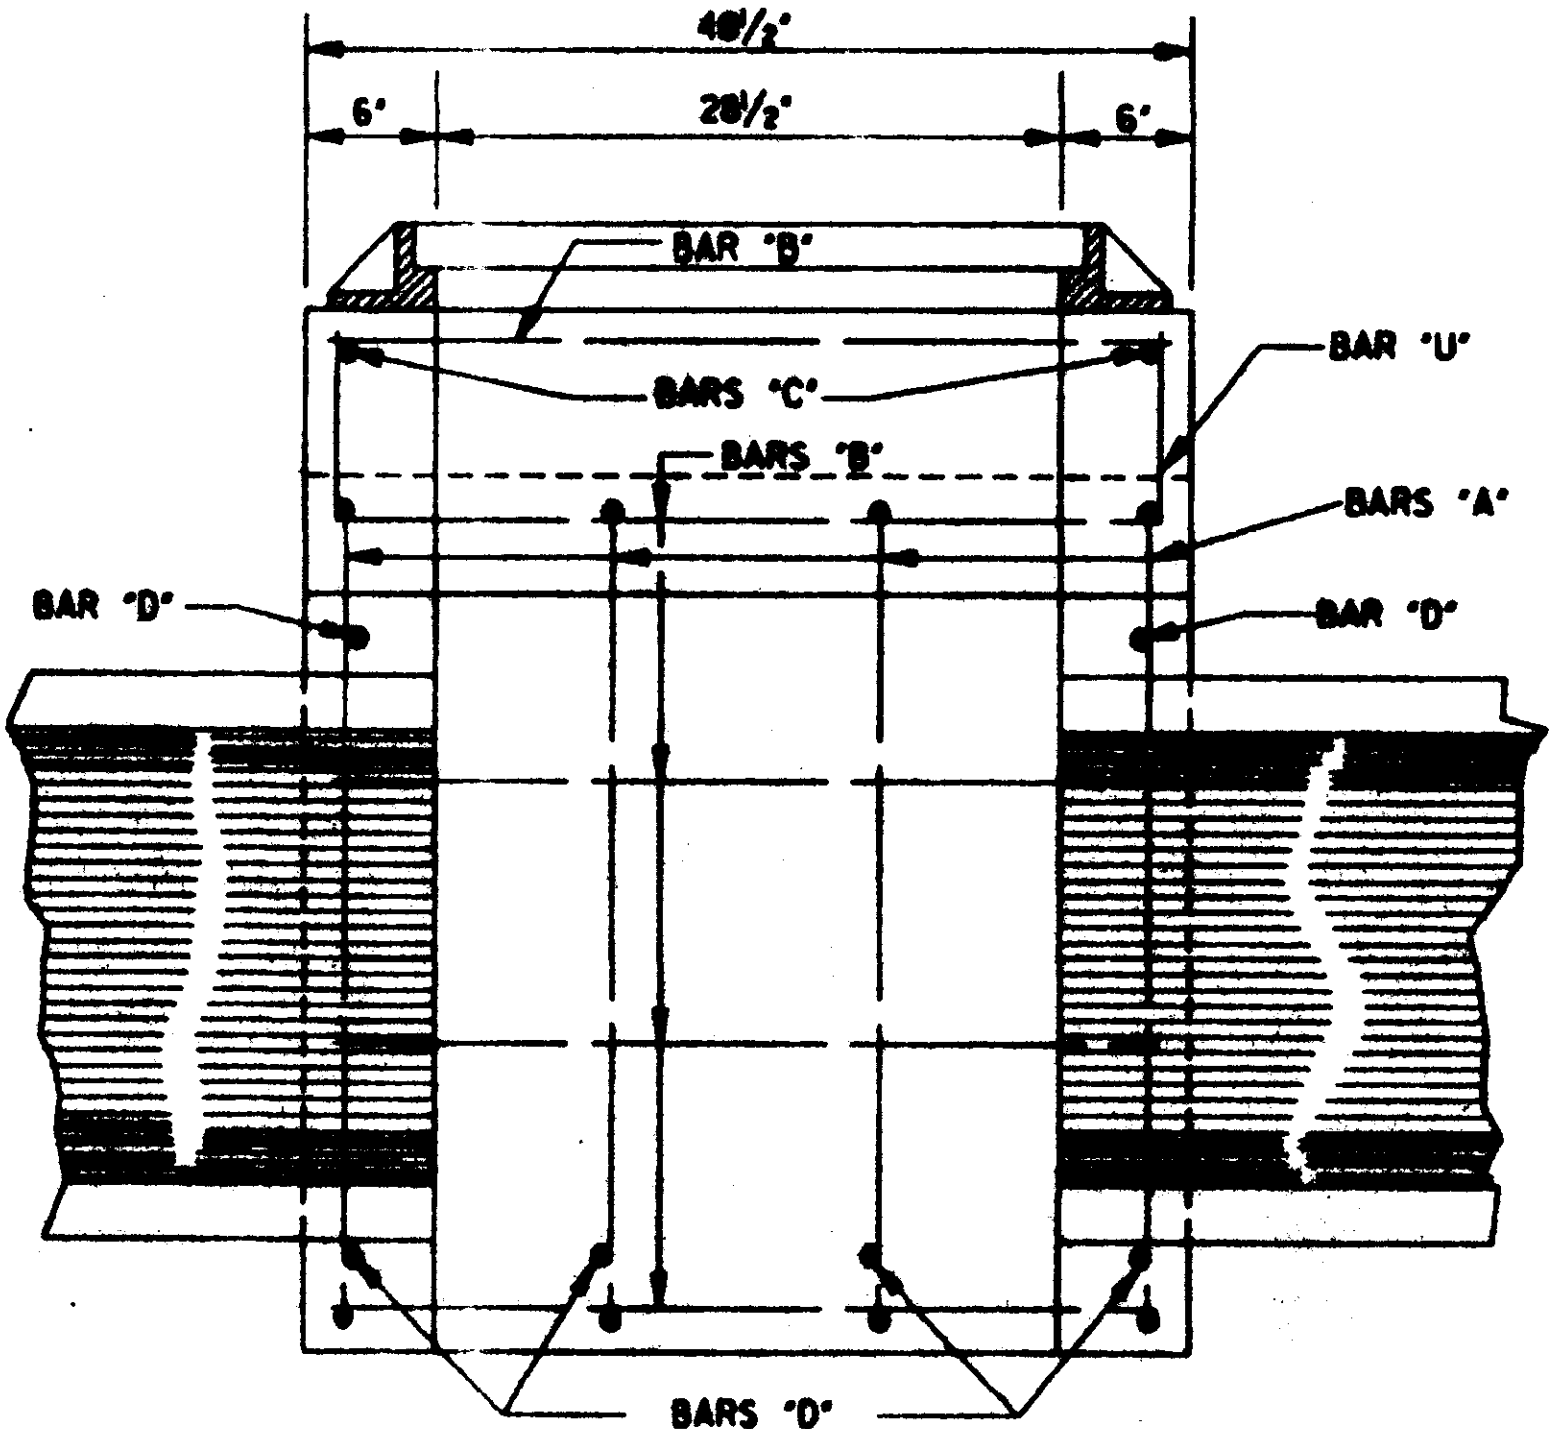

SECTION C-C

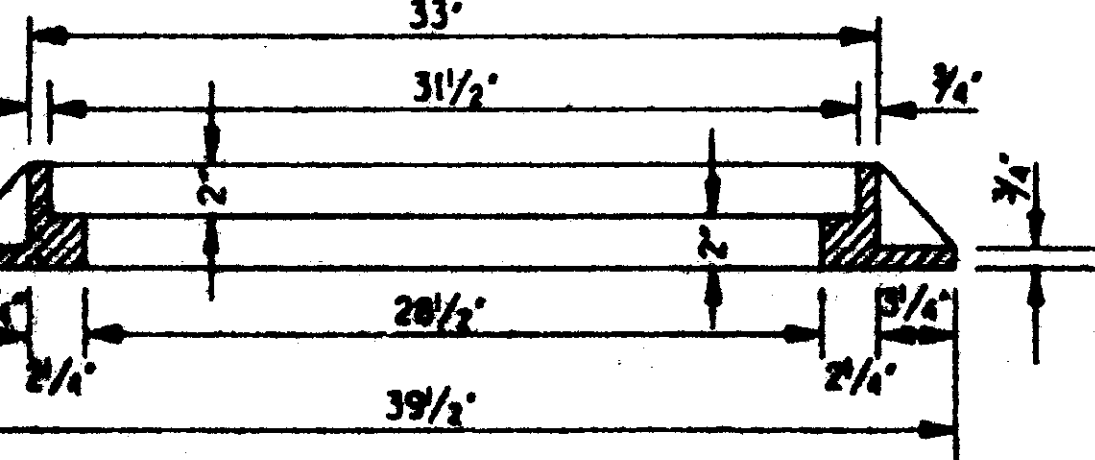

SECTION C-C (FRAME)

- GENERAL NOTES:
- QUANTITIES SHOWN WILL BE THE BASIS OF PAYMENT UNLESS AUTHORIZED MODIFICATIONS ARE MADE.
 - CONCRETE SHALL BE CLASS 'B' CONCRETE AND REINFORCING STEEL SHALL BE DEFORMED BARS.
 - THE CONTRACTOR HAS THE OPTION TO PROVIDE GRATE NO. 1 OR GRATE NO. 2 AS SHOWN ON SHEET IG-2.
 - FRAME TO BE GRAY IRON CASTING, (AASHTO M 105, CLASS 30).

MISSISSIPPI DEPARTMENT OF TRANSPORTATION
ROADWAY DESIGN DIVISION
STANDARD PLAN

**STORM SEWER INLET
TYPE SS-3**

ISSUE DATE: OCTOBER 1, 1998

WORKING NUMBER: SS-3
SHEET NUMBER: 12

DRAIN BASIN NOTES:

GENERAL

PVC surface drainage inlets shall include the inline drains and drain basin as indicated on the central drawings. The cast iron grates for each of these fittings are to be considered an integral part of the surface drainage inlet and shall be furnished by the same manufacturer. The surface drainage inlets shall be as manufactured by Hygeplast, or prior approved equal.

MATERIALS



The inline drains and drain basins required by this contract shall be manufactured from PVC pipe stock. The drainage pipe connection shall be manufactured from PVC pipe stock and formed to provide a gasketed connection with the piping system specified. The joint tightness shall conform to ASTM D2321.

Surface drainage products shall meet the mechanical strength requirements for materials specified in ASTM F196, F246, and F1336.


The grates furnished for all surface drainage inlets shall be cast or ductile iron and shall be made specifically for tight fitting. Grates for 12" and larger drain basins and inline drain basins shall be capable of supporting H-10 wheel loading for pedestrian grates and solid cover. Grates for drain basins and inline drain inlets smaller than 12" shall be capable of supporting light wheel load traffic. Metal used in the manufacture of the castings shall conform to ASTM A-82-83 Class 302 for cast iron or A536 grade 70-30-05 for ductile iron. The castings shall be furnished with a black paint.

INSTALLATION



The specified PVC surface drainage inlets shall be installed using conventional flexible pipe bedding materials and procedures. For traffic joint installations H-20 or H-50, the inline drain or drain basin shall be installed conforming to the manufacturer's installation guidelines for traffic rated (H-20 or H-18) installations. The bedding material shall be crushed stone or other granular material meeting the requirements of class 1 or 2 material as defined in ASTM D2521. The surface drainage inlets shall be bedded and backfilled uniformly in accordance with ASTM D2321.

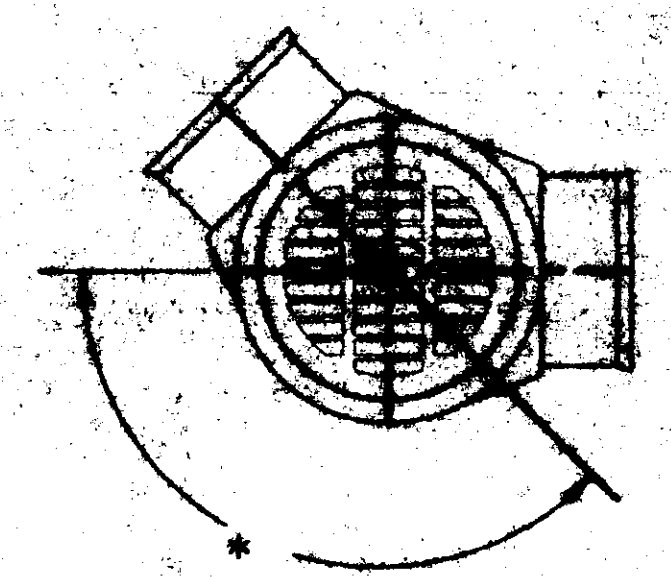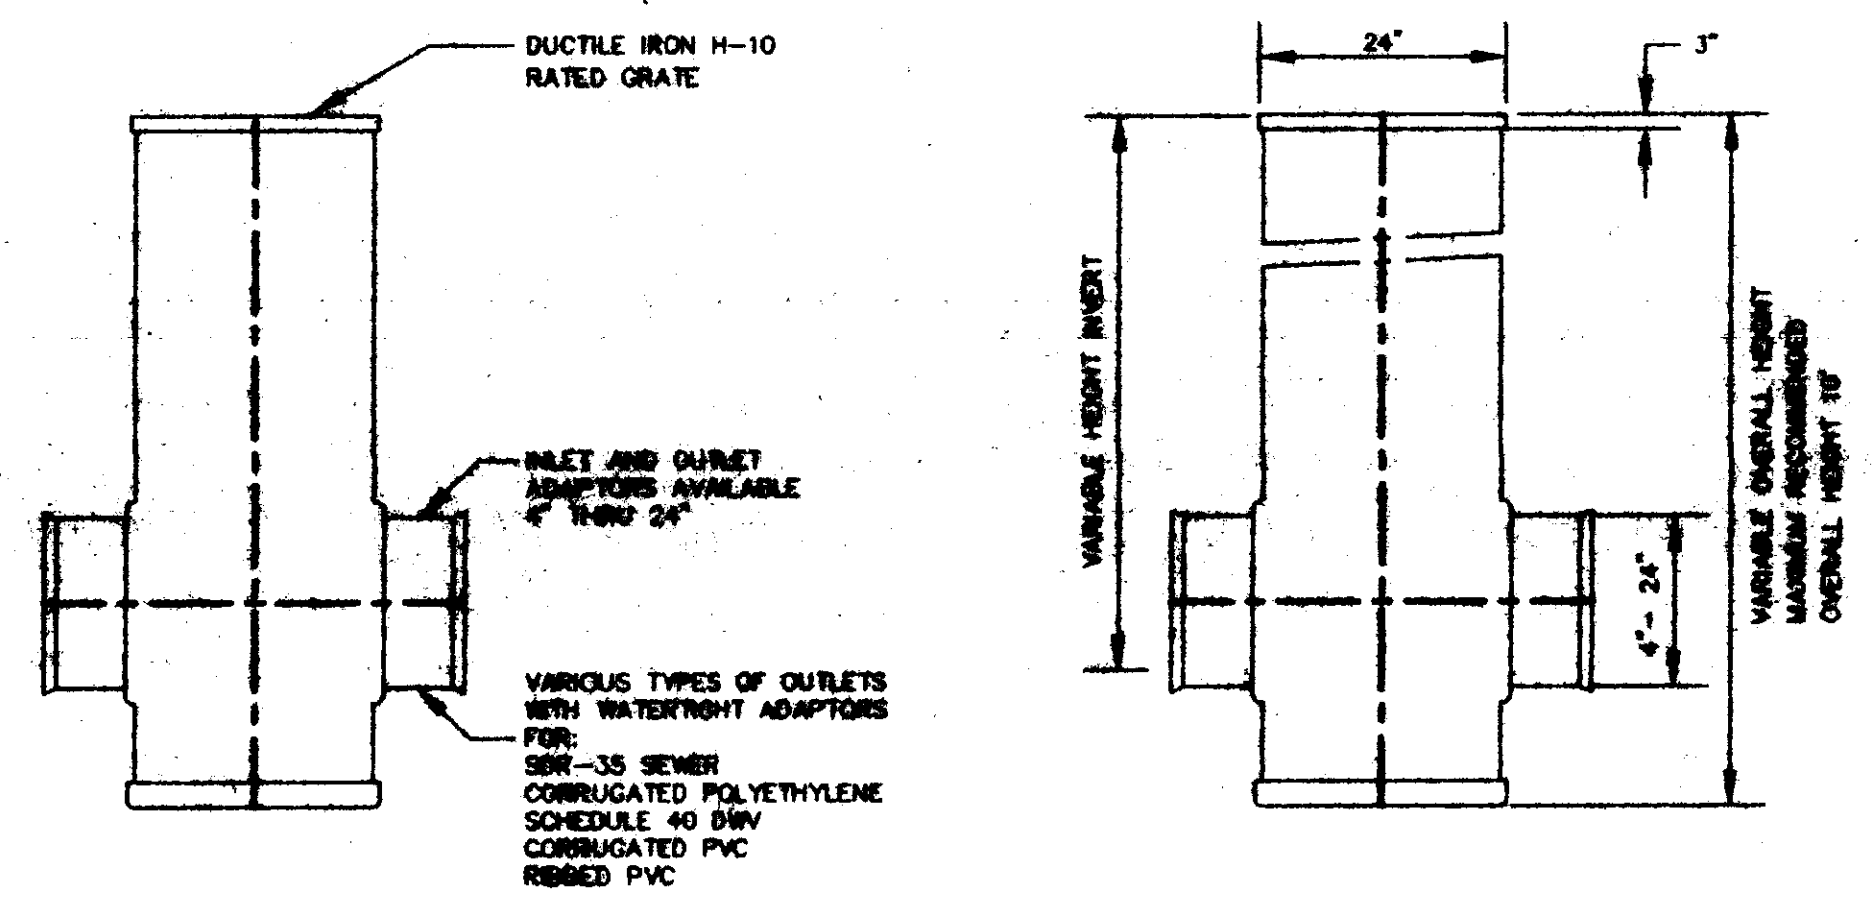


DRAIN BASIN

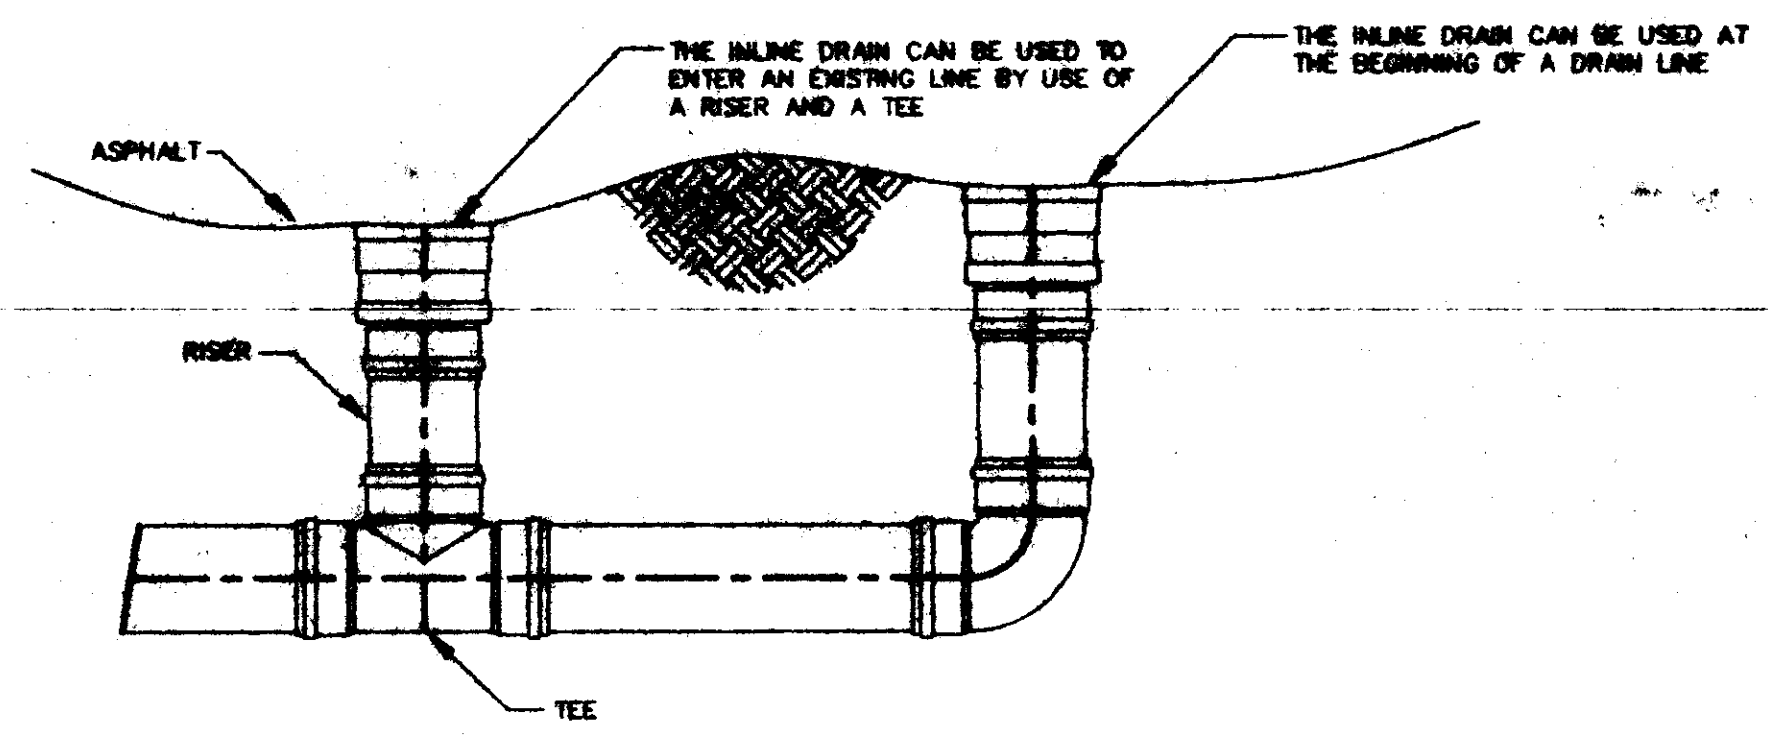

DRAIN BASIN CONNECTION

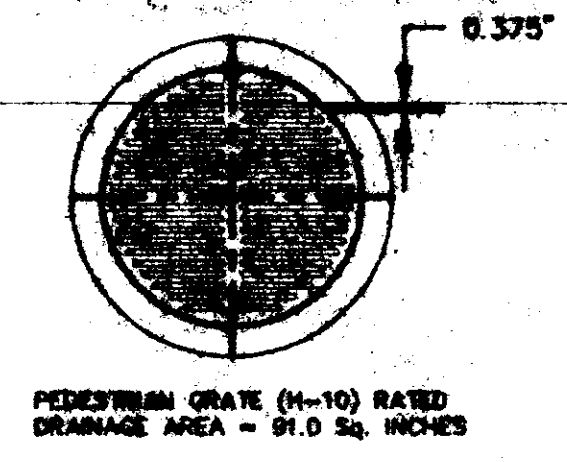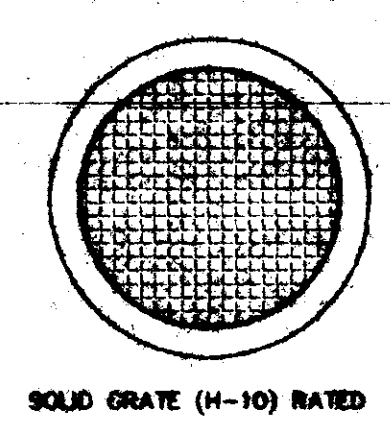

DUCTILE IRON GRATE

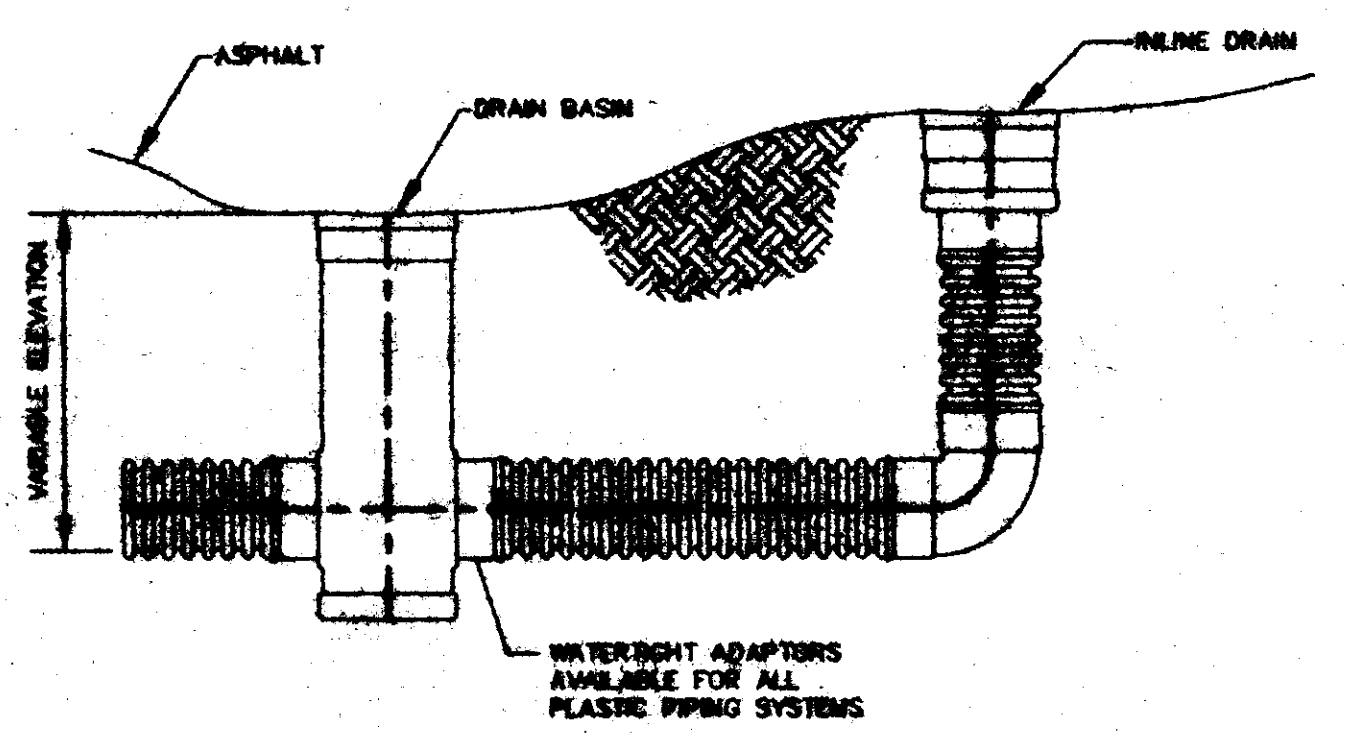


INSTALLATION

DESIGNED BY RICHARD SCHERS	APPROVED BY PAT GUEST	REVISIONS
DATE: 10-21-87	FILE NO: 9-2738	
SHEET NO. 2738-MISC-DETAILS		


Geest Consultants, Inc.
CONSULTING ENGINEERS • LAND SURVEYORS
TWENTY SIX EASTGATE DRIVE • P.O. BOX 1225 • BRANDON, MS 39043
TELEPHONE (601) 825-8341 FAX (601) 825-3032

PROJECT: **THE COMMONS, PHASE 1**


SHEET NAME: **MISCELLANEOUS DETAILS**

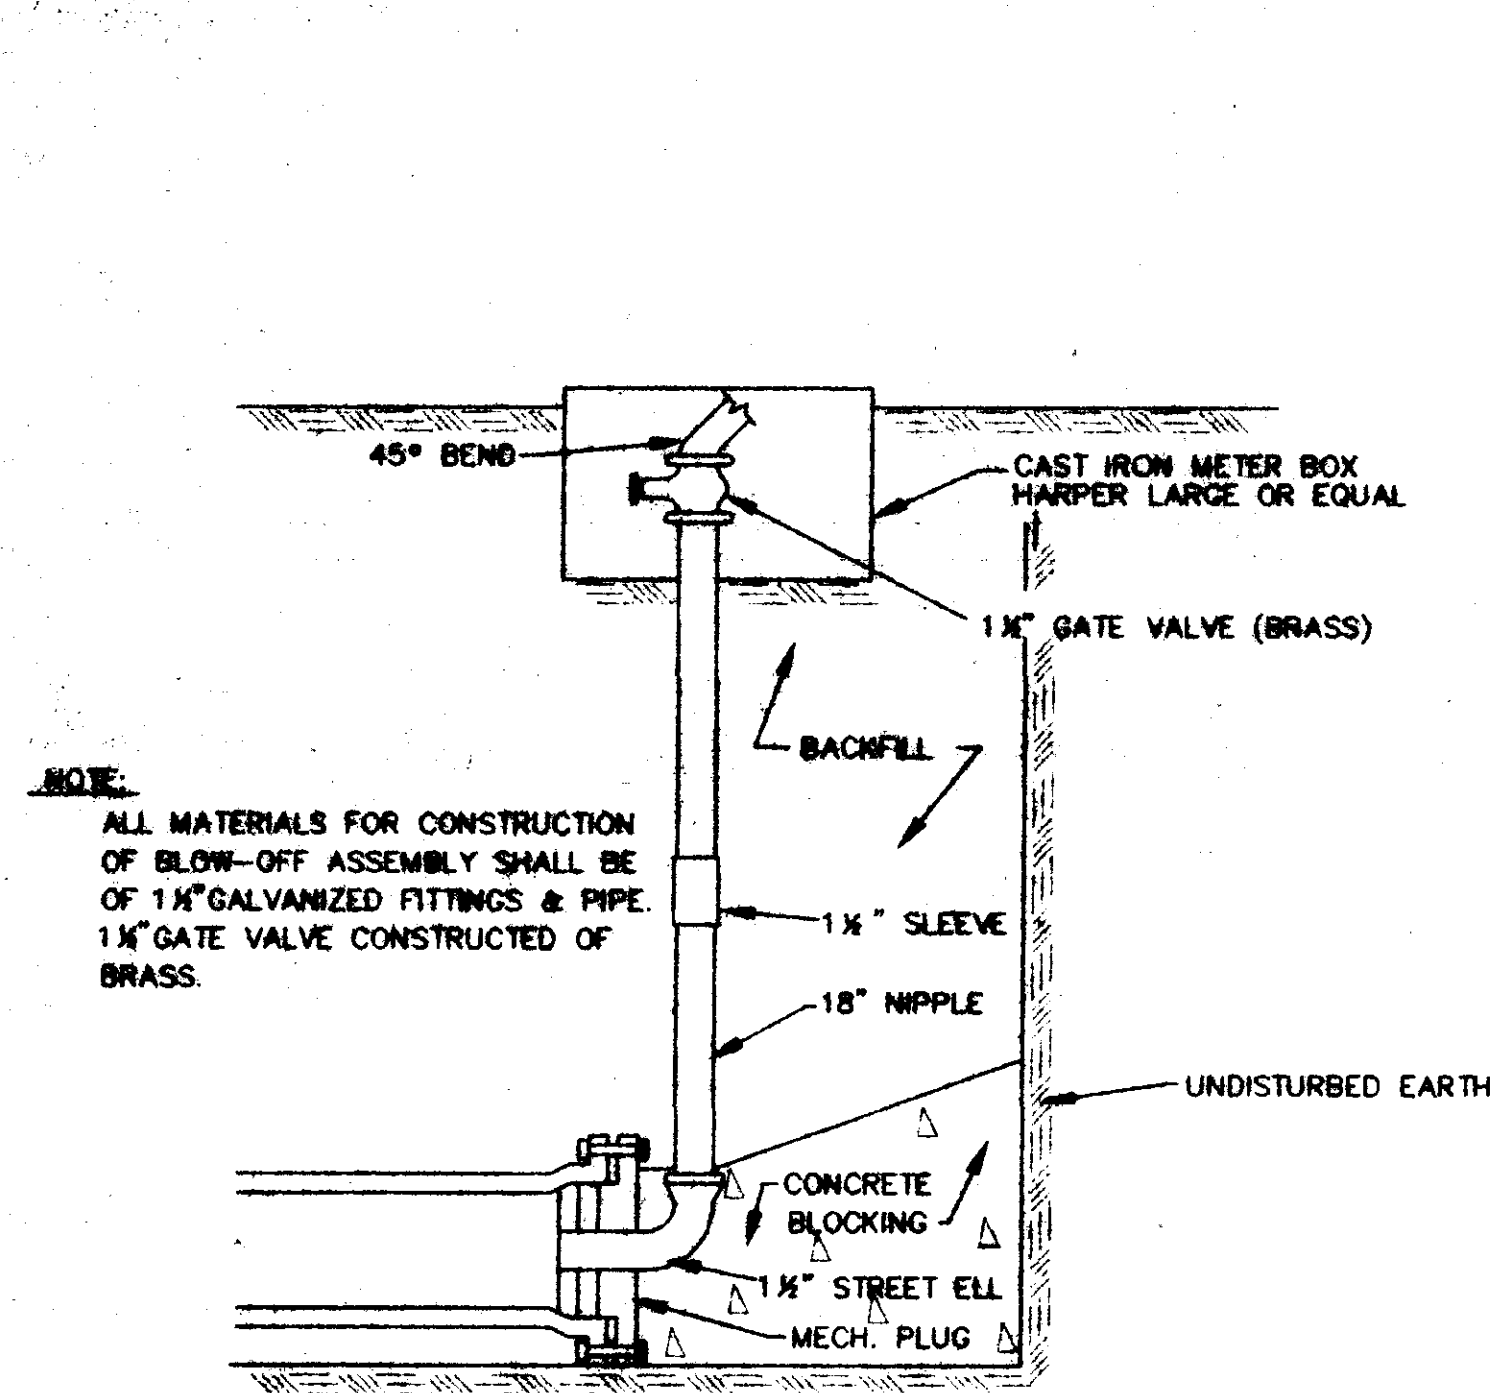


TYPICAL BLOW-OFF ASSEMBLY
N.T.S.

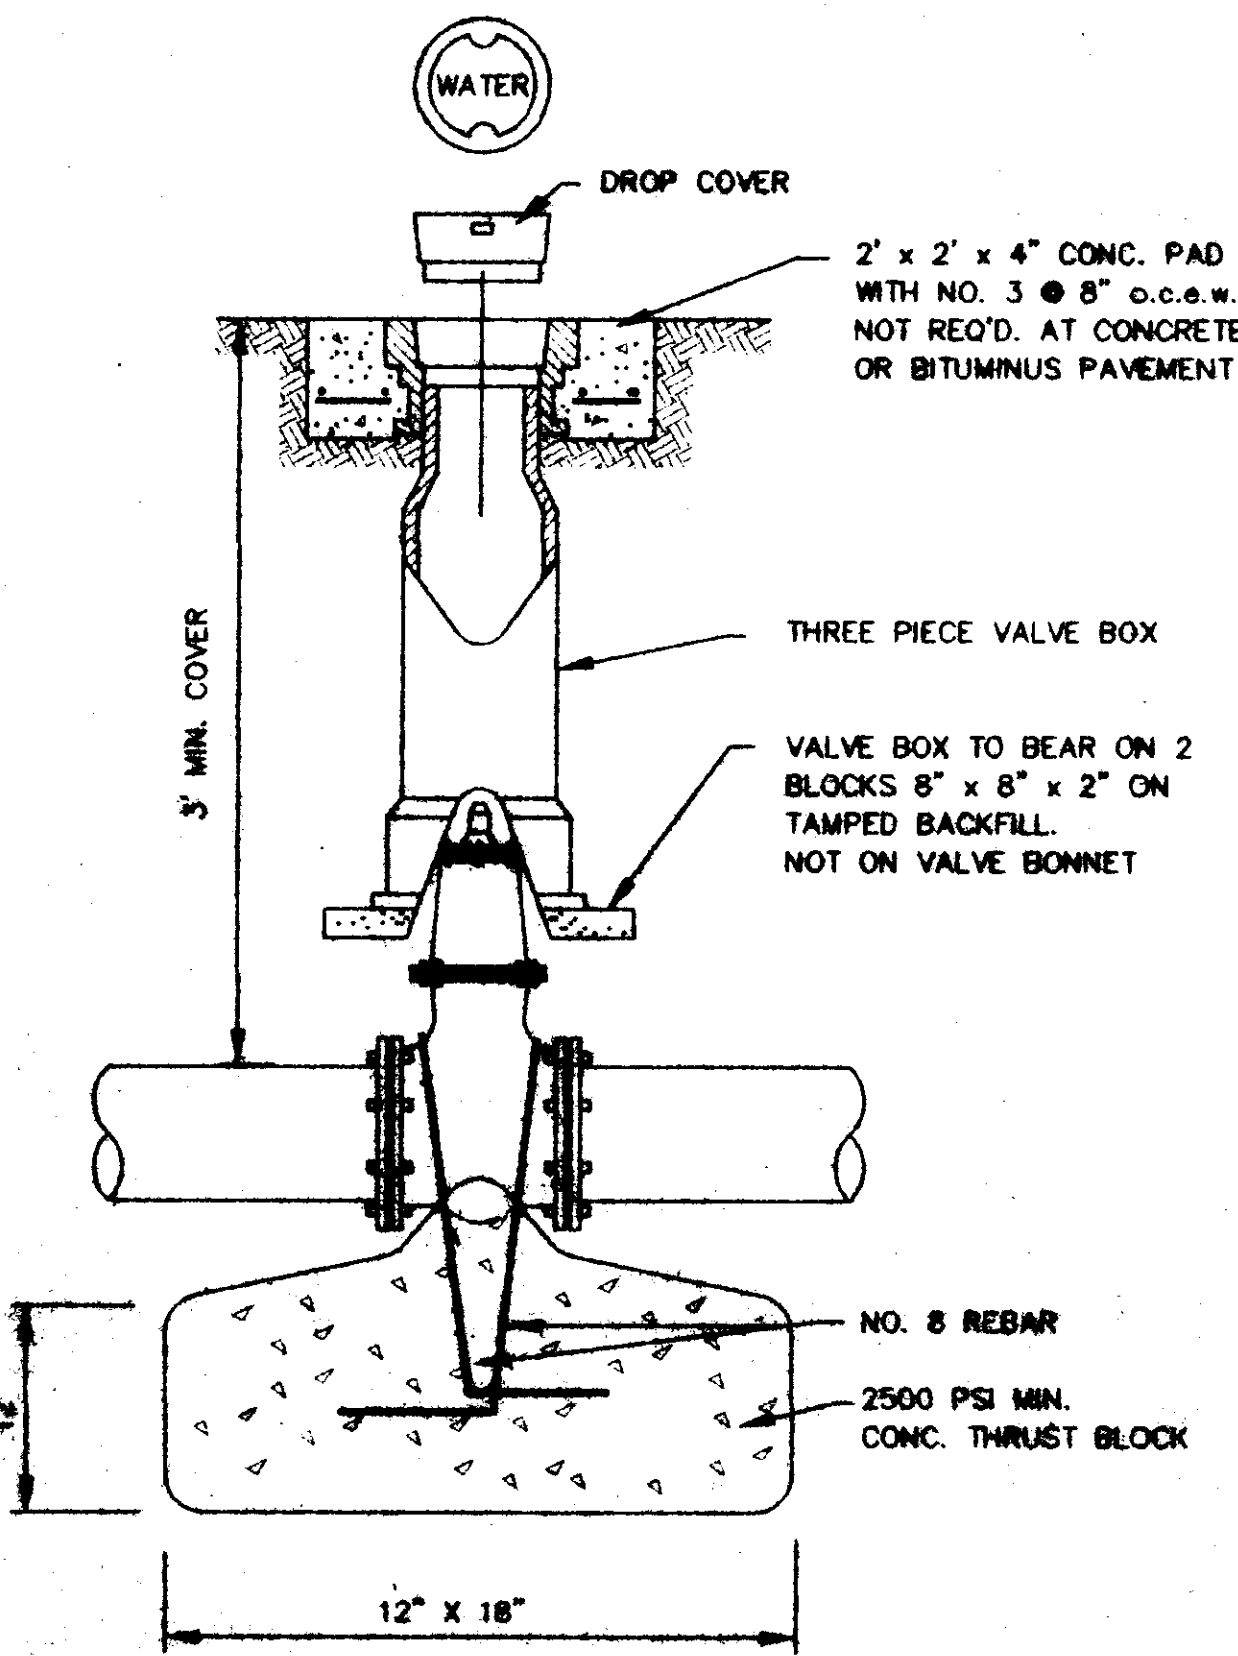


GATE VALVE DETAIL
N.T.S.

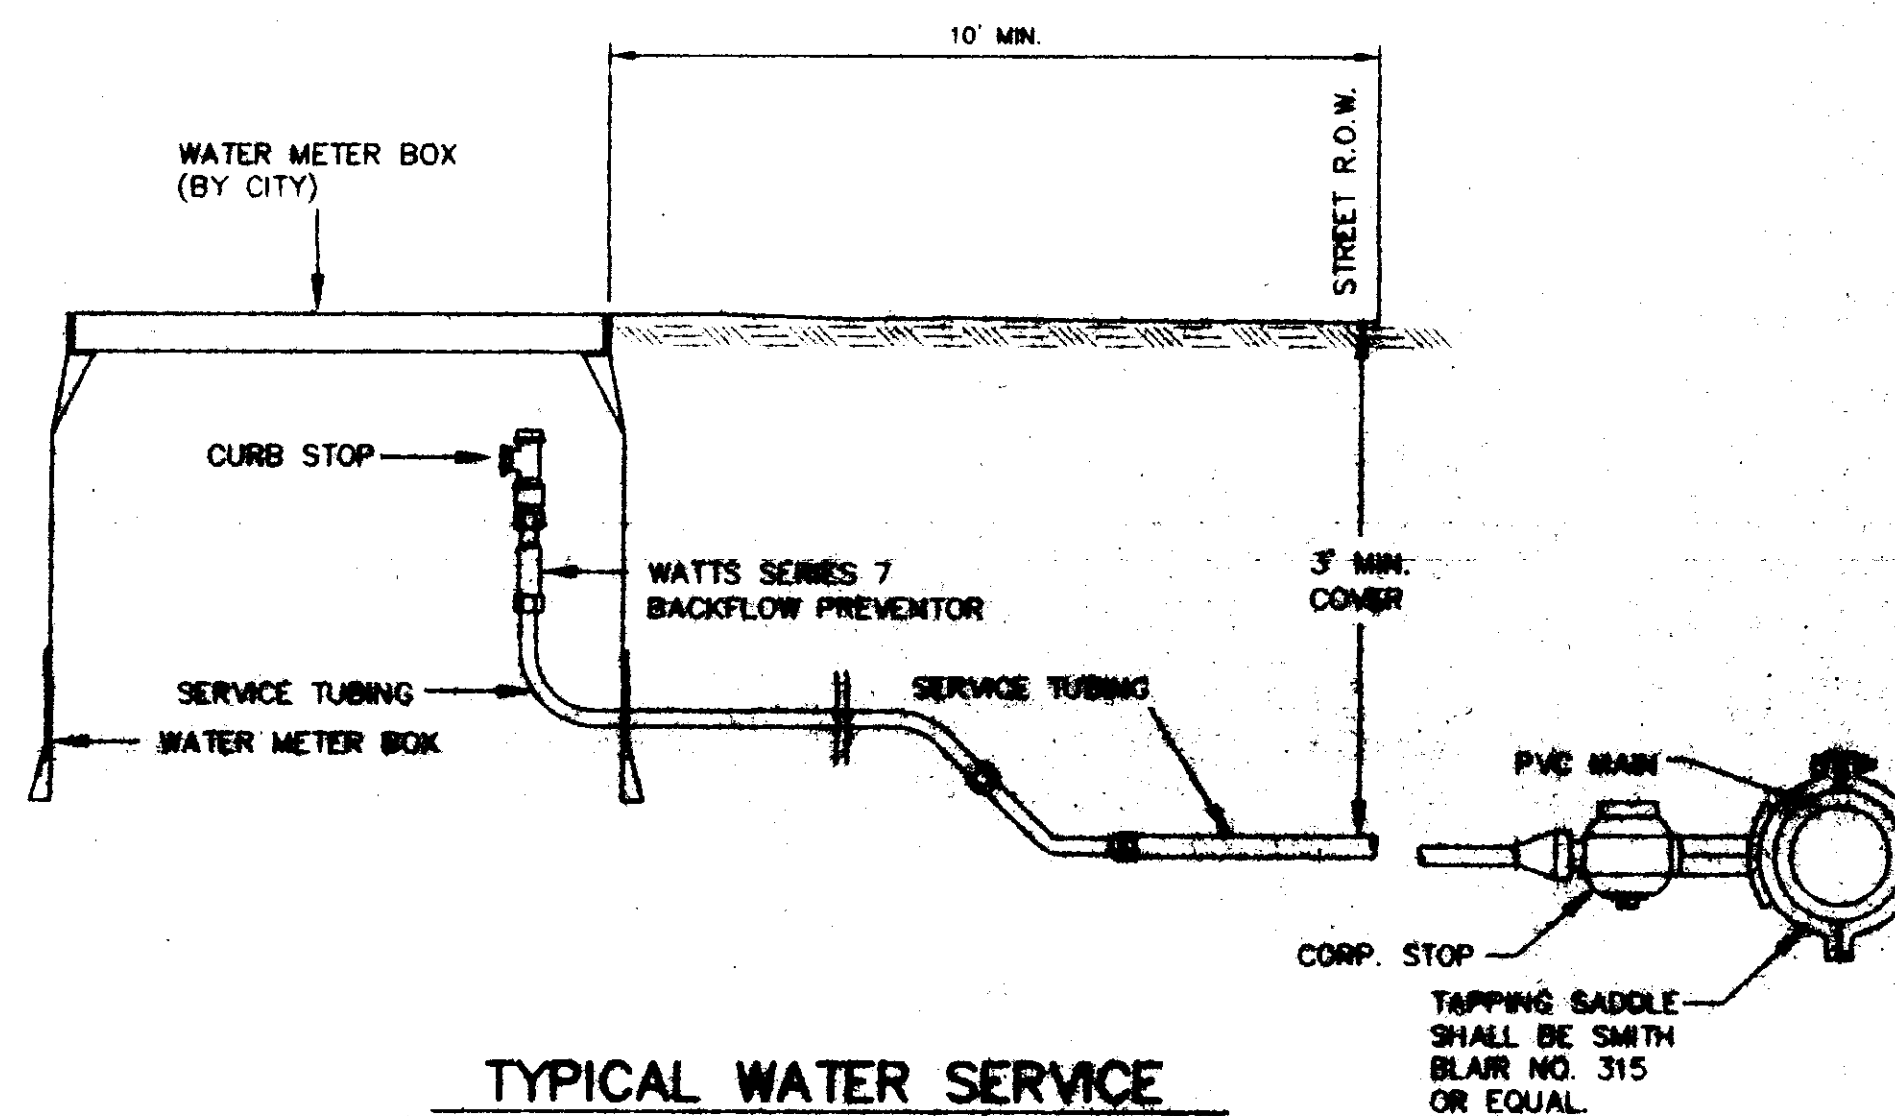


TYPICAL WATER SERVICE
N.T.S.

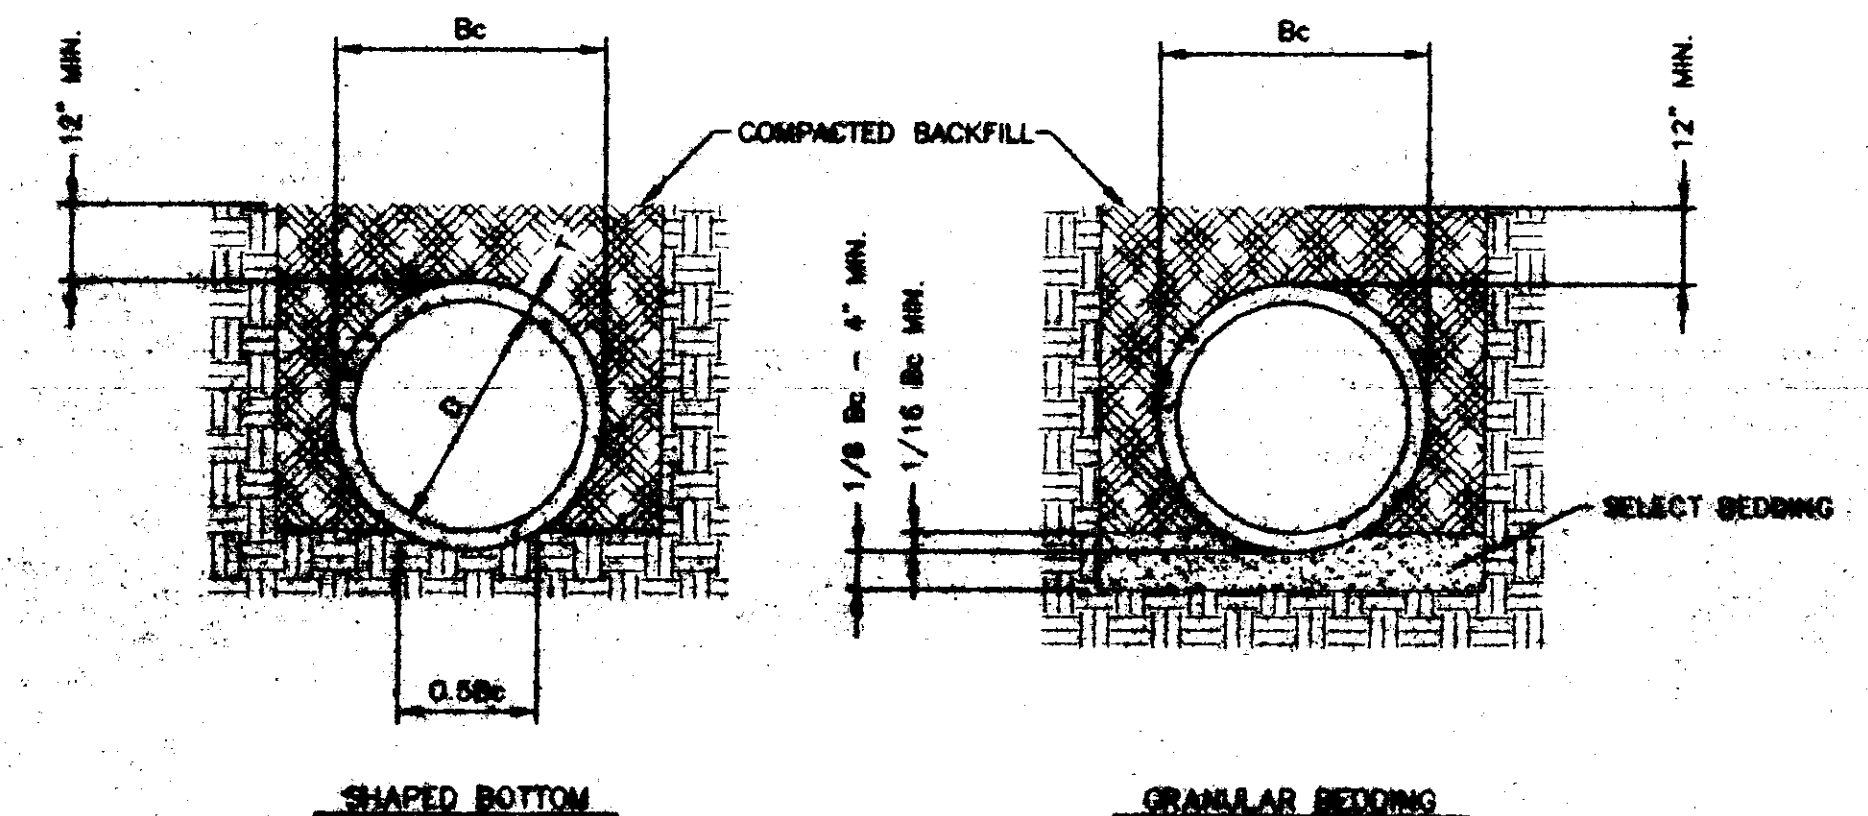

TYPICAL TRENCH DETAILS
CLASS "C"
N.T.S.

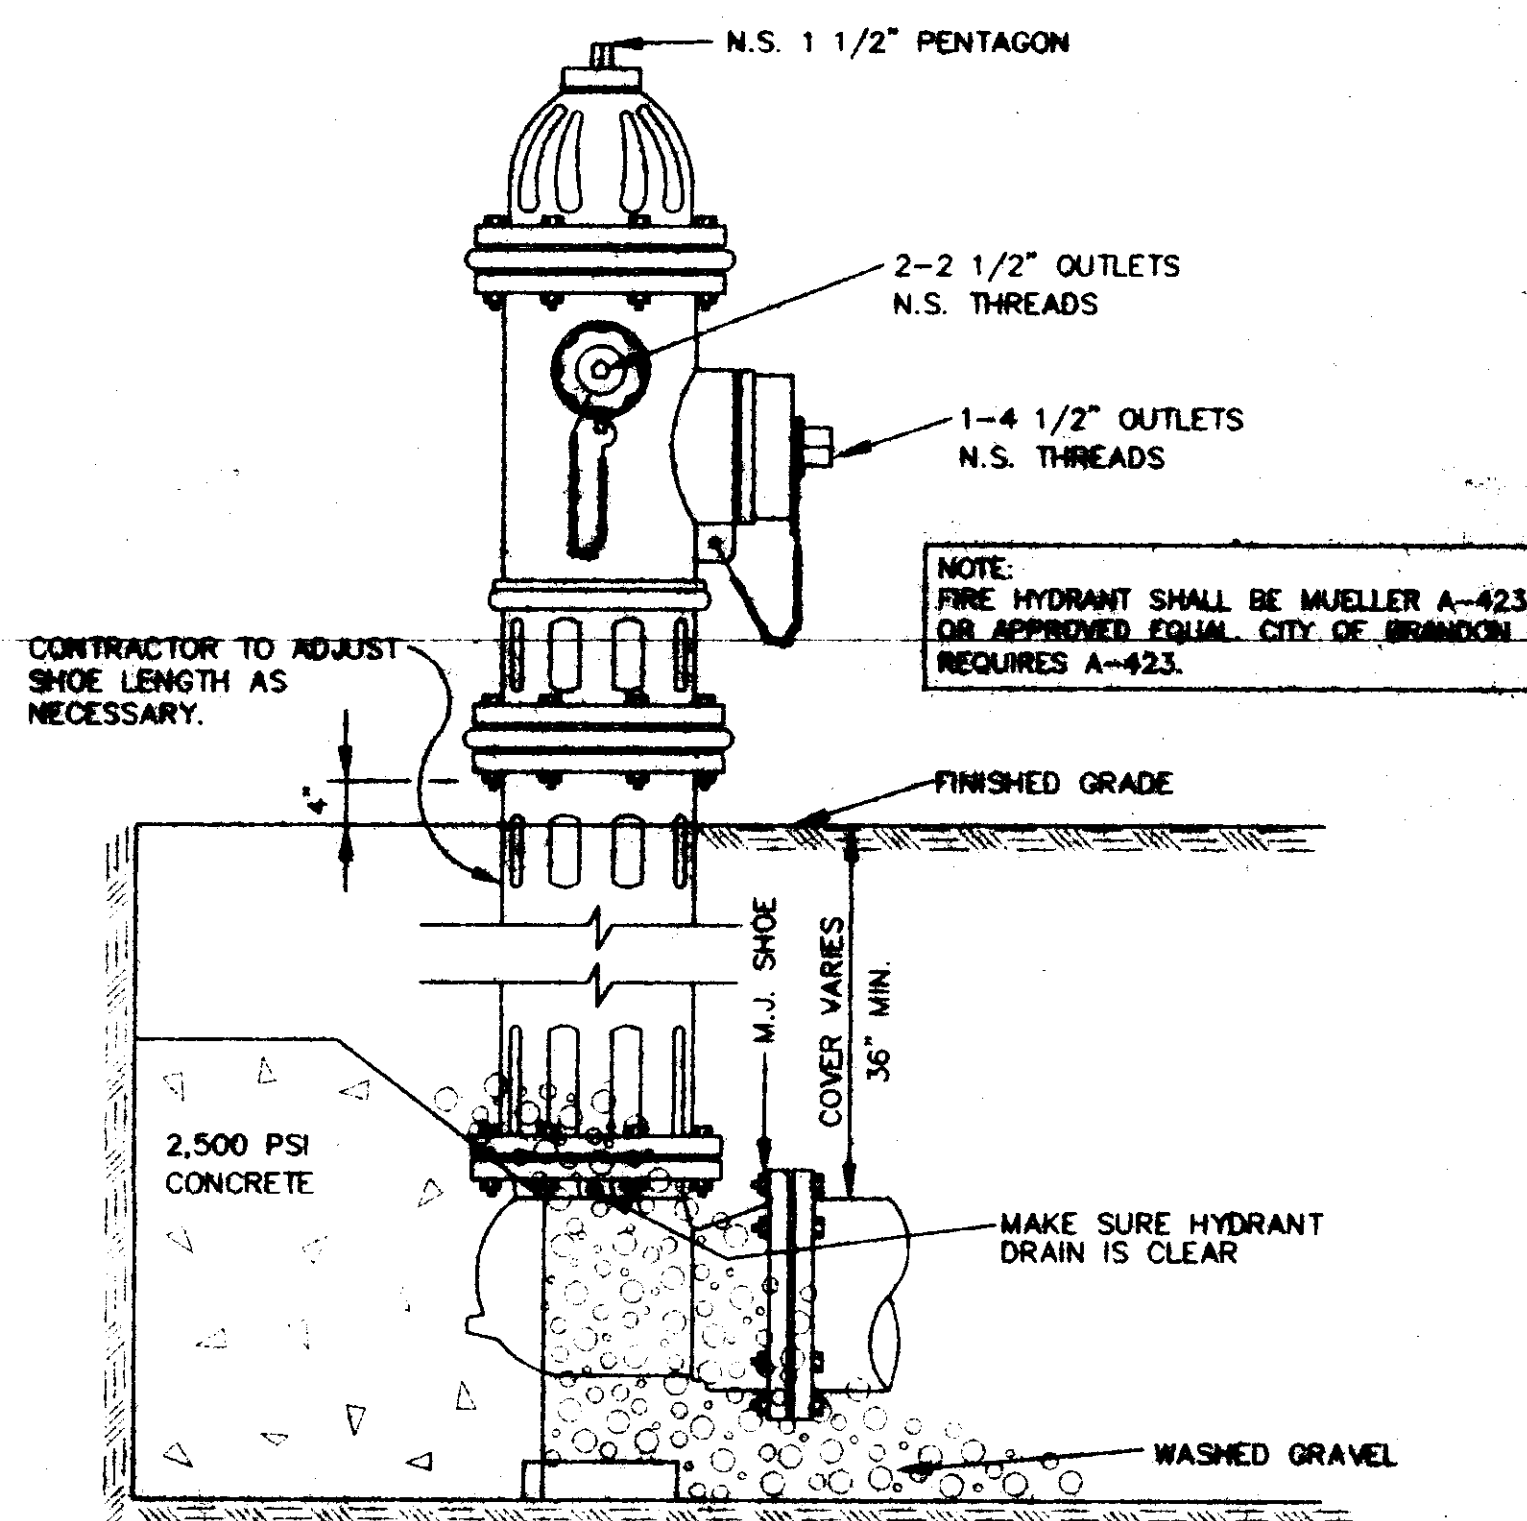


ELEVATION

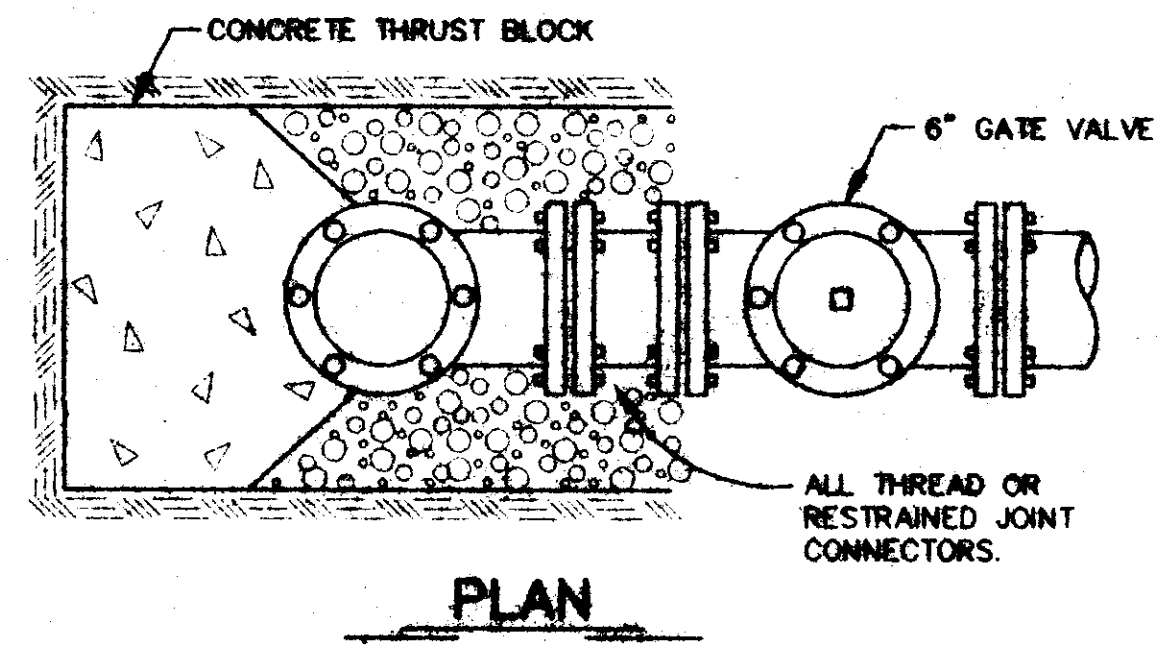


PLAN


TYPICAL FIRE HYDRANT INSTALLATION
N.T.S.

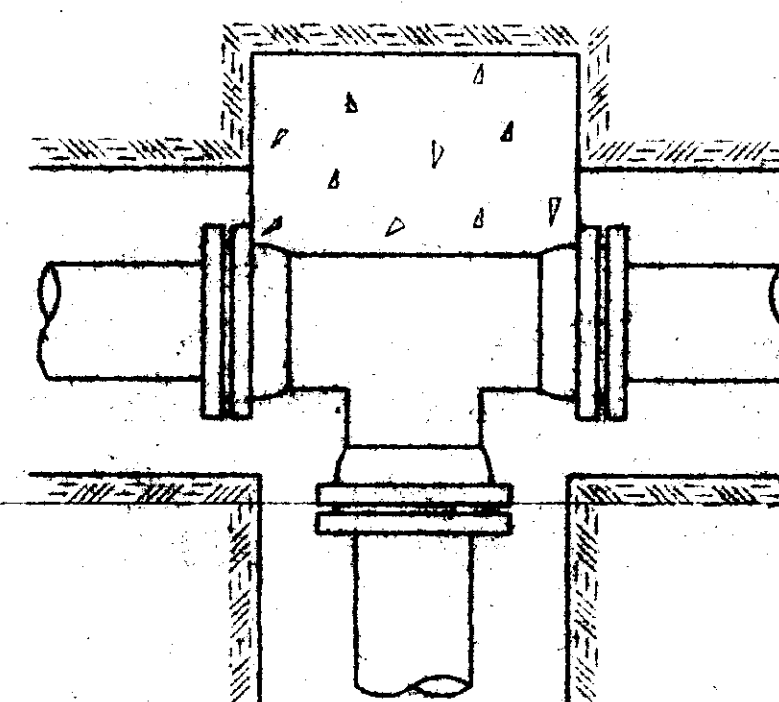


TEE

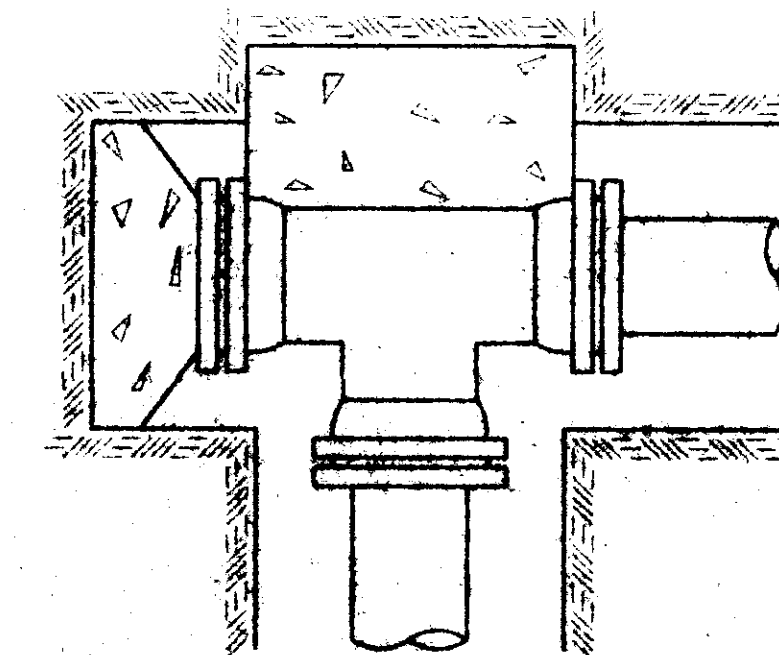


PLUGGED TEE

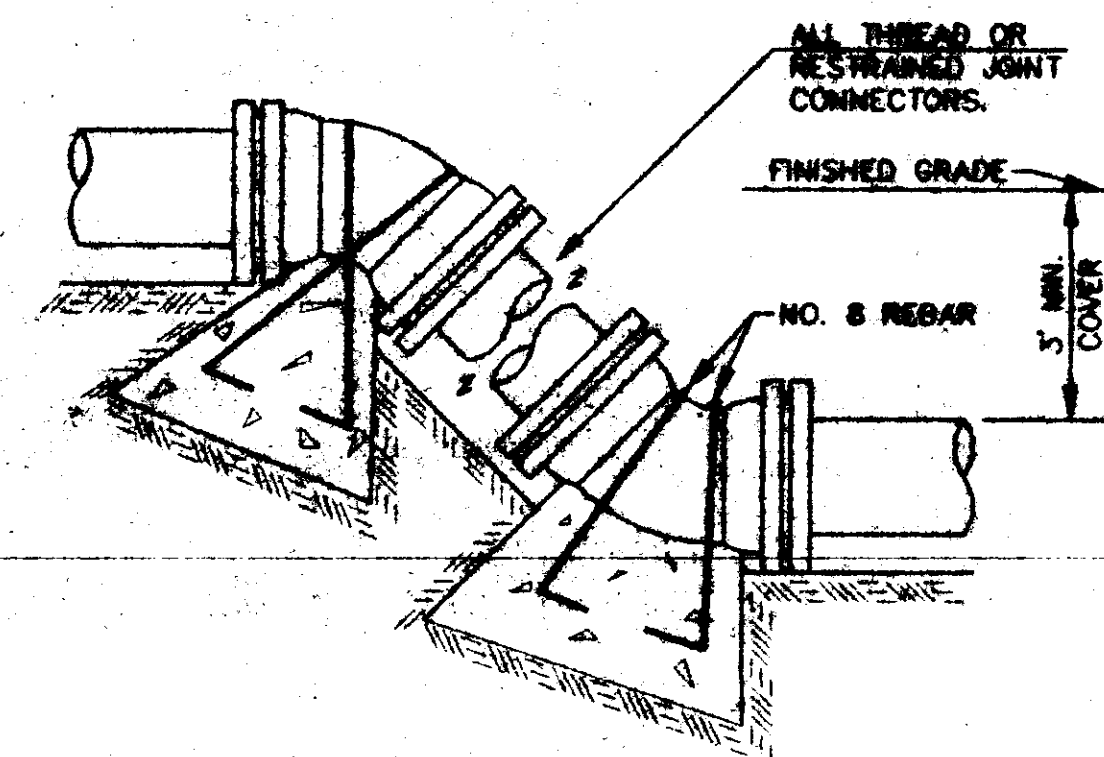

VERTICAL BENDS

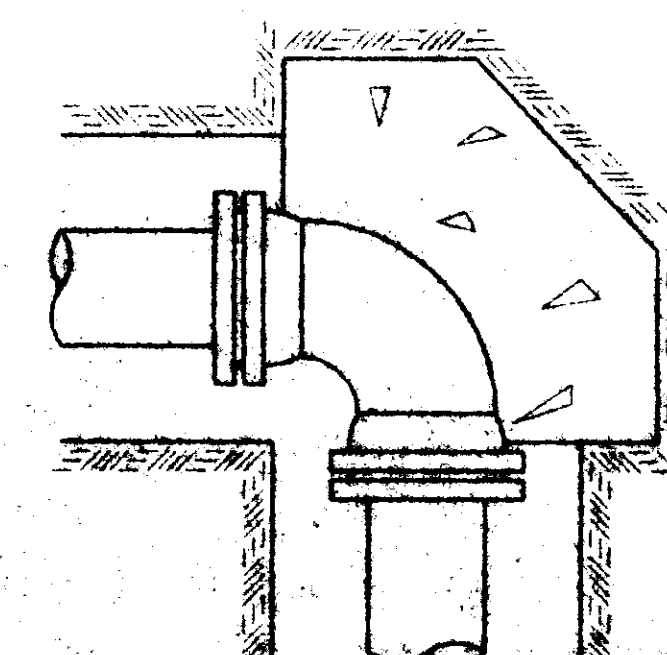

90° BEND

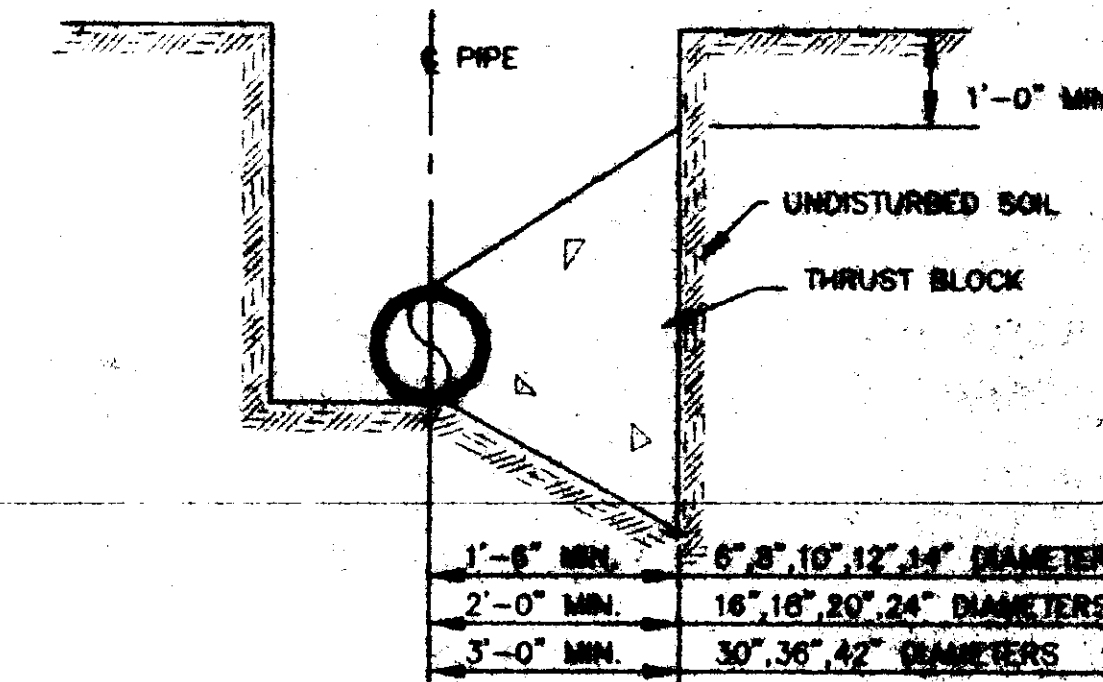

TYPICAL CROSS SECTION

BEARING AREA IN SQ. FT.

NORMAL PIPE DIAMETER (IN.)	DEAD-END OR TEE	90° BEND	45° BEND	22 1/2° BEND	11 1/4° BEND
2					
4	2.0	2.0	2.0	2.0	2.0
6	2.0	2.0	2.0	2.0	2.0
8	3.0	3.0	2.0	2.0	2.0
10					
12	5.0	6.0	4.0	3.0	3.0
14					
16	8.0	12.0	6.0	4.0	4.0

VERTICAL BENDS

NORMAL PIPE DIAMETER (IN.)	DEAD-END OR TEE	90° BEND	45° BEND	22 1/2° BEND	11 1/4° BEND
2					
4			1.0 (1.5)	1.0 (1.5)	1.0 (1.5)
6			1.0 (1.5)	1.0 (1.5)	1.0 (1.5)
8			1.0 (1.5)	1.0 (1.5)	1.0 (1.5)
10					
12			1.0 (1.5)	1.0 (1.5)	1.0 (1.5)
14					
16			1.0 (1.5)	1.0 (1.5)	1.0 (1.5)

VOLUME OF BLOCKS INCLUDING SOIL LOAD (CU. FT.) (SEE 105)

NOTE: ALL THRUST BLOCKS SHALL BE 2500 PSI CONCRETE AGAINST UNDISTURBED EARTH.

TYPICAL THRUST BLOCKING IN WATER MAINS

N.T.S.

DESIGNED BY: RICHARD SOMERS
DATE: 05-26-00
JOB NO.: 2736-WR-WR-DETAILS

APPROVED BY: PAT QUEST
JOB NO.: G-2736

REVISIONS:

Quest Consultants, Inc.
CONSULTING ENGINEERS • LAND SURVEYORS
TWENTY SIX EASTGATE DRIVE • P.O. BOX 1225 • BRANDON, MS 39043
TELEPHONE (601) 825-8341 FAX (601) 825-3032

PROJECT:

THE COMMONS, PHASE 1

SHT. NAME:

WATER DETAILS

SHT. NO.:

14

