

WEST WATER LINES PHASE 2

MAYOR:


GENE F. MCGEE

ALDERMEN:

KEN HEARD
MIKE CROOK
CHUCK GAUTIER
LARRY ROBERTS
SCOTT JONES
LINDA TRUNZLER
GERALD STEEN

WS-99-01

THE CITY OF

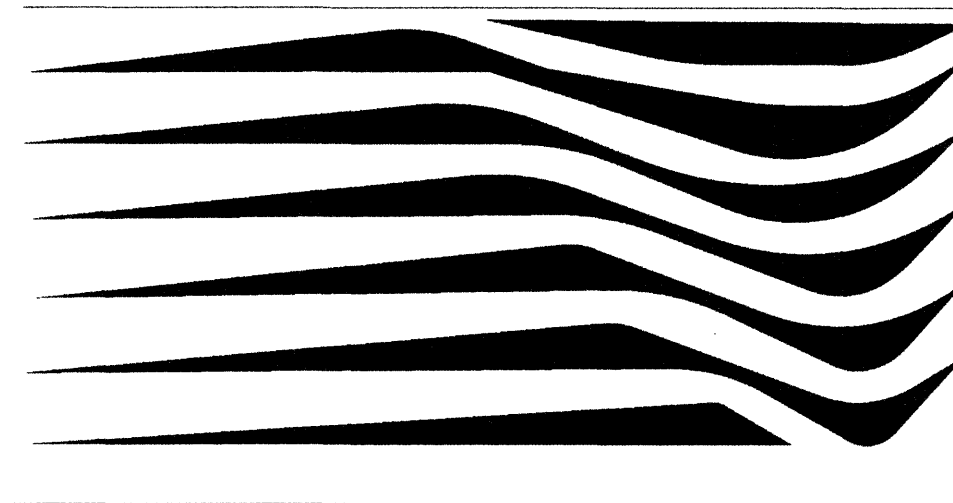

RIDGELAND

CITY STAFF:

PUBLIC WORKS
DIRECTOR:
MIKE McCOLLUM

ASST. DIRECTOR:
BEN MAYS

AS-BUILTS

JUNE 2005

PWP-05045

