


WHEATLEY PLACE III

CITY OF RIDGELAND ,

MISSISSIPPI

PWP 05007

PWP-05010

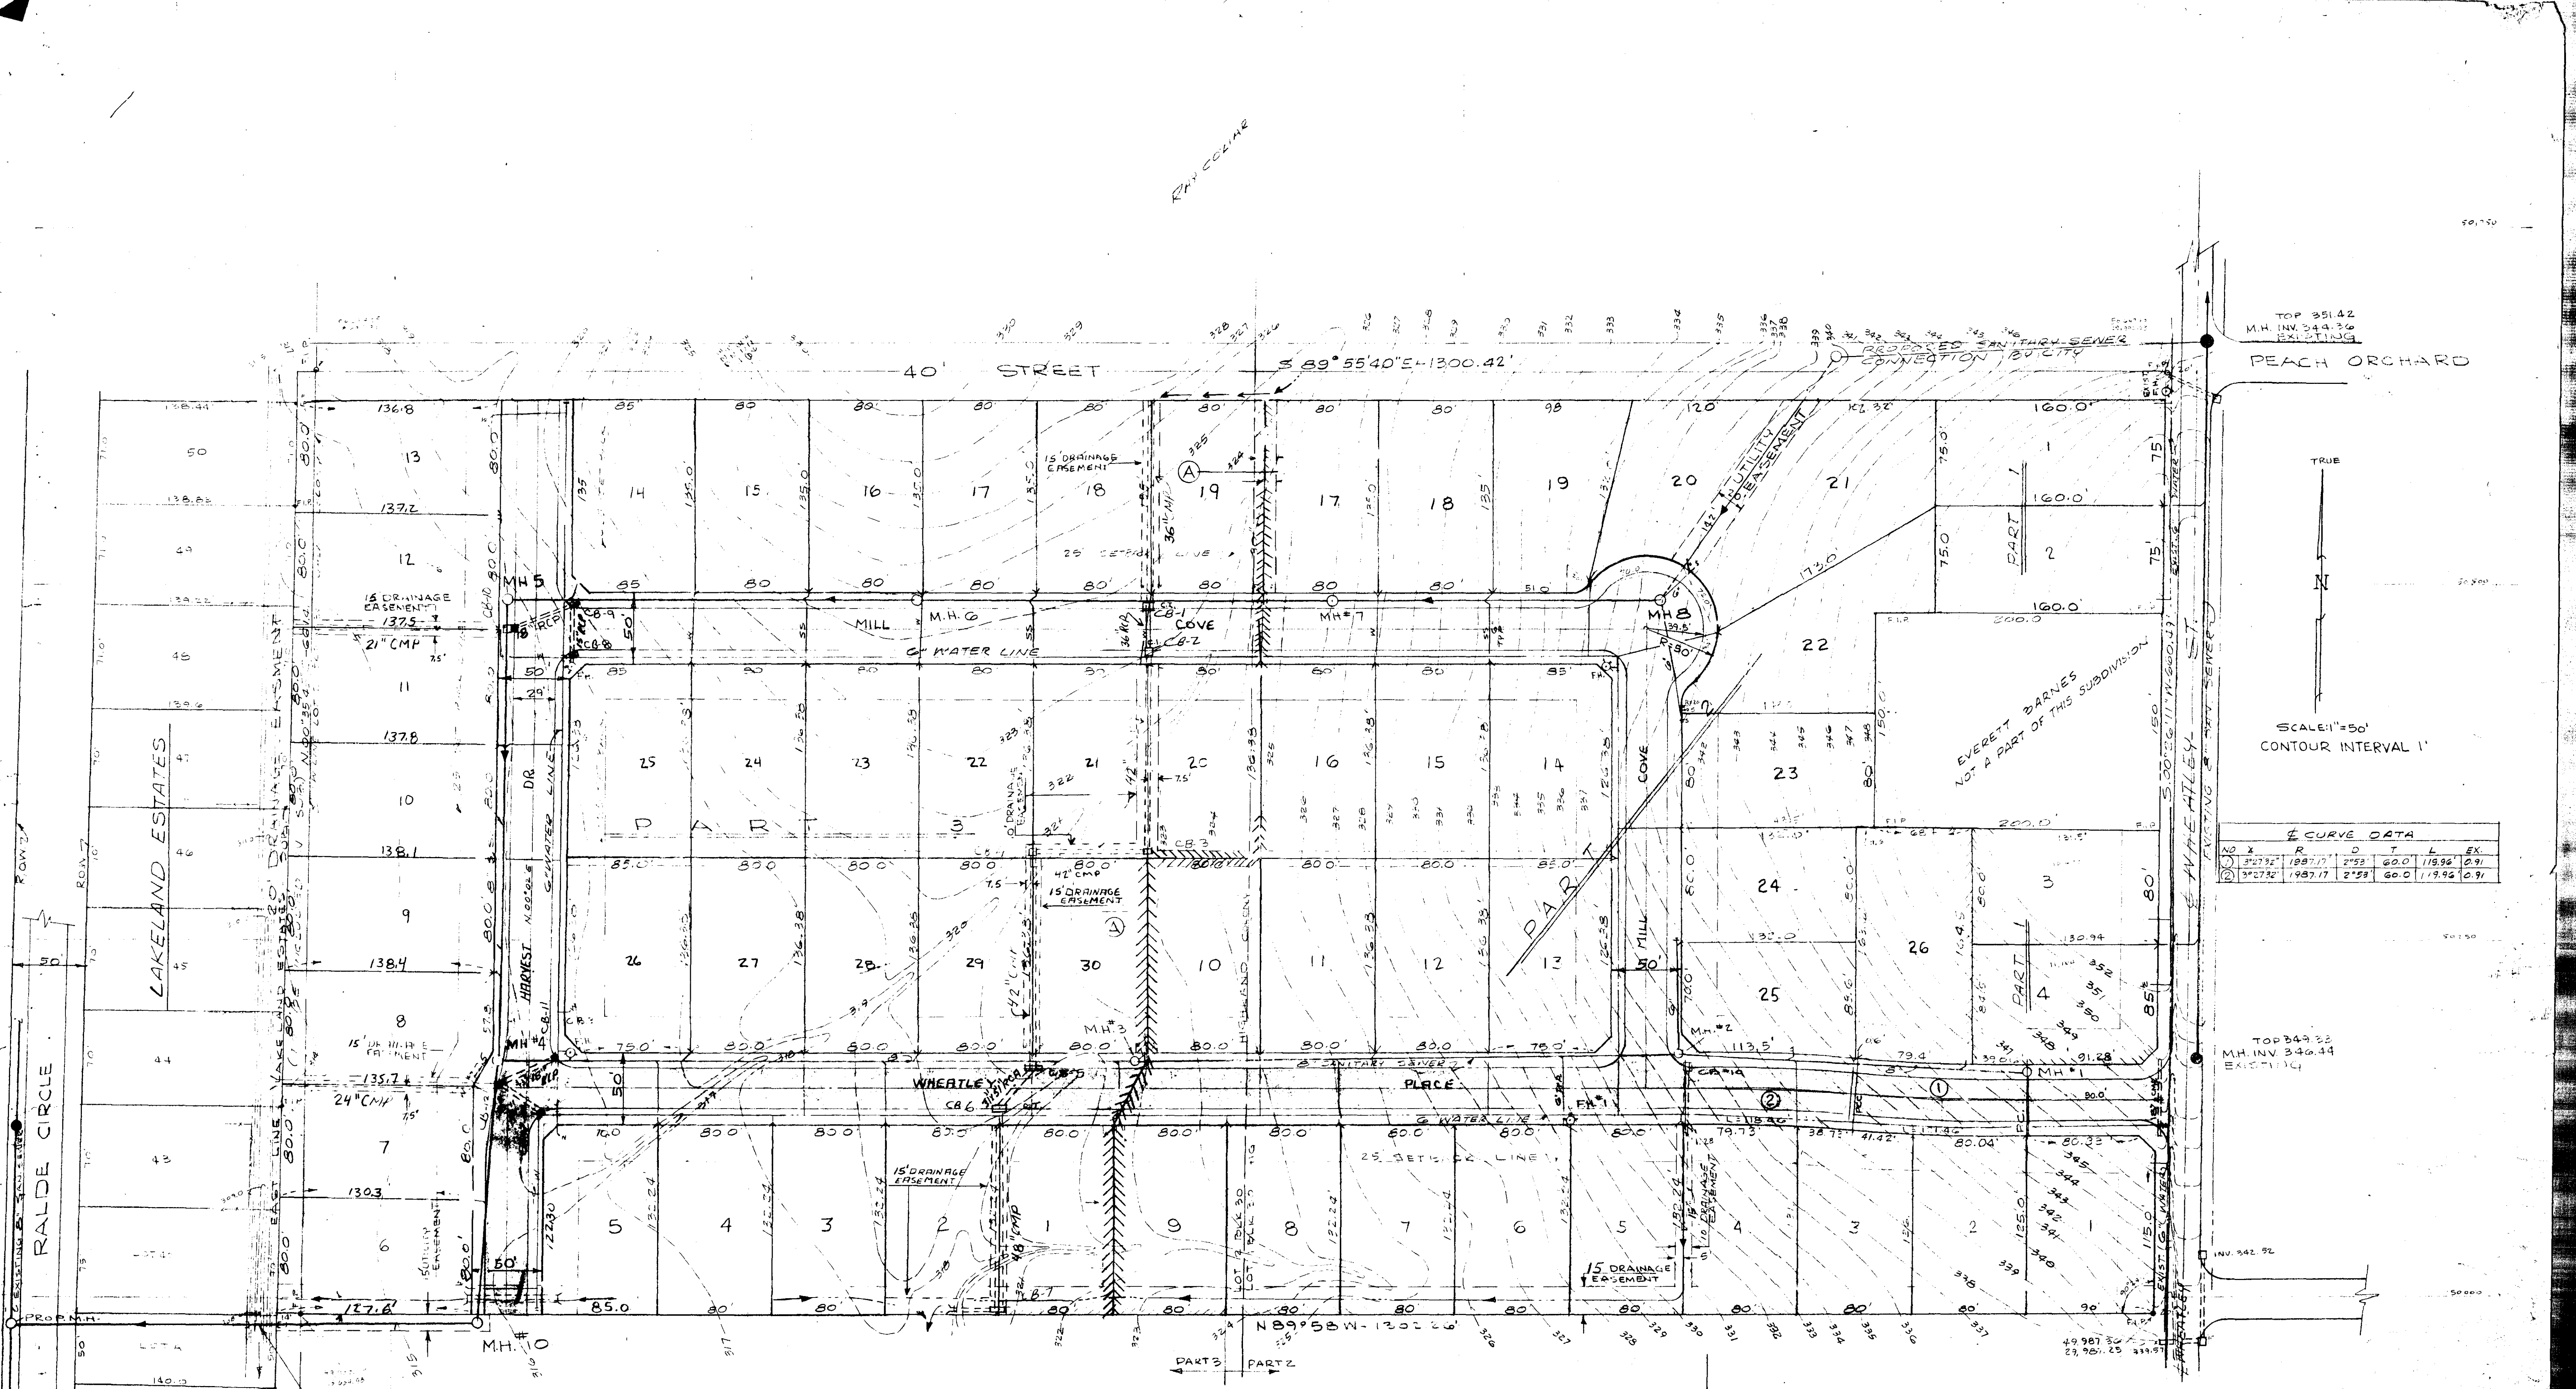

TOP 351.42
 M.H. INV. 344.36
 EXISTING


TRUE
 N
 SCALE: 1"=50'
 CONTOUR INTERVAL 1'

CURVE DATA

| NO. | X | R | D | T | L | EX. |
|-----|--------|---------|-------|-------|---------|------|
| 1 | 342.32 | 1987.17 | 2°53' | 60.0' | 119.96' | 2.91 |
| 2 | 342.32 | 1987.17 | 2°53' | 60.0' | 119.96' | 2.91 |

TOP 349.32
 M.H. INV. 346.44
 EXISTING


NOTE
 CAST IRON PIPE (30")
 DITCHES TO HAVE EROSION CONTROL
 PER REG
 SOD ALL AREAS OF SWALE
 WHERE SLOPE IS MORE THAN

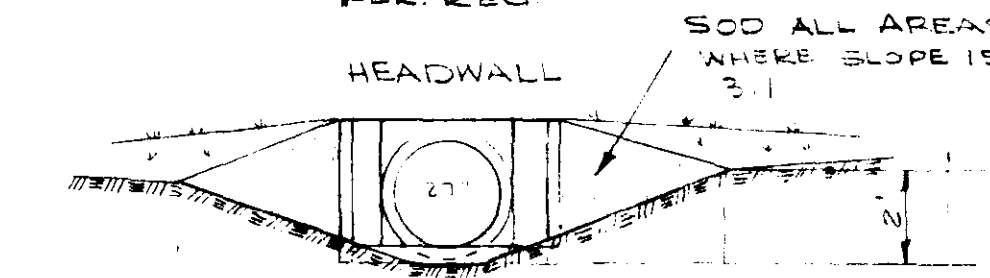

WHEATLEY PLACE
 REV. 2/19/79 KPL


BUILDING SET BACK
 (MIN. YARD)
 FRONT 25'
 SIDE 7.5'
 REAR 25'

ZONED R-2 (MIN. LOT SIZE 10,000)
 DATE OCT. 15, 1977
 19.9 Acs.

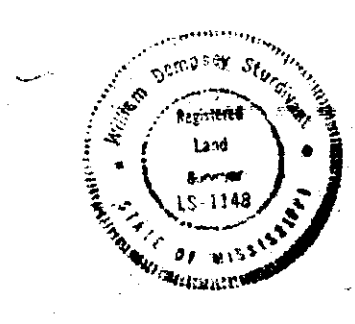


| | |
|-----------|--|
| DATE | |
| BY | |
| CHKD | |
| APPROVED | |
| NOTED | |
| NOTE BOOK | |
| NO. | |

| | |
|-----------|--|
| DATE | |
| BY | |
| CHKD | |
| APPROVED | |
| NOTED | |
| NOTE BOOK | |
| NO. | |

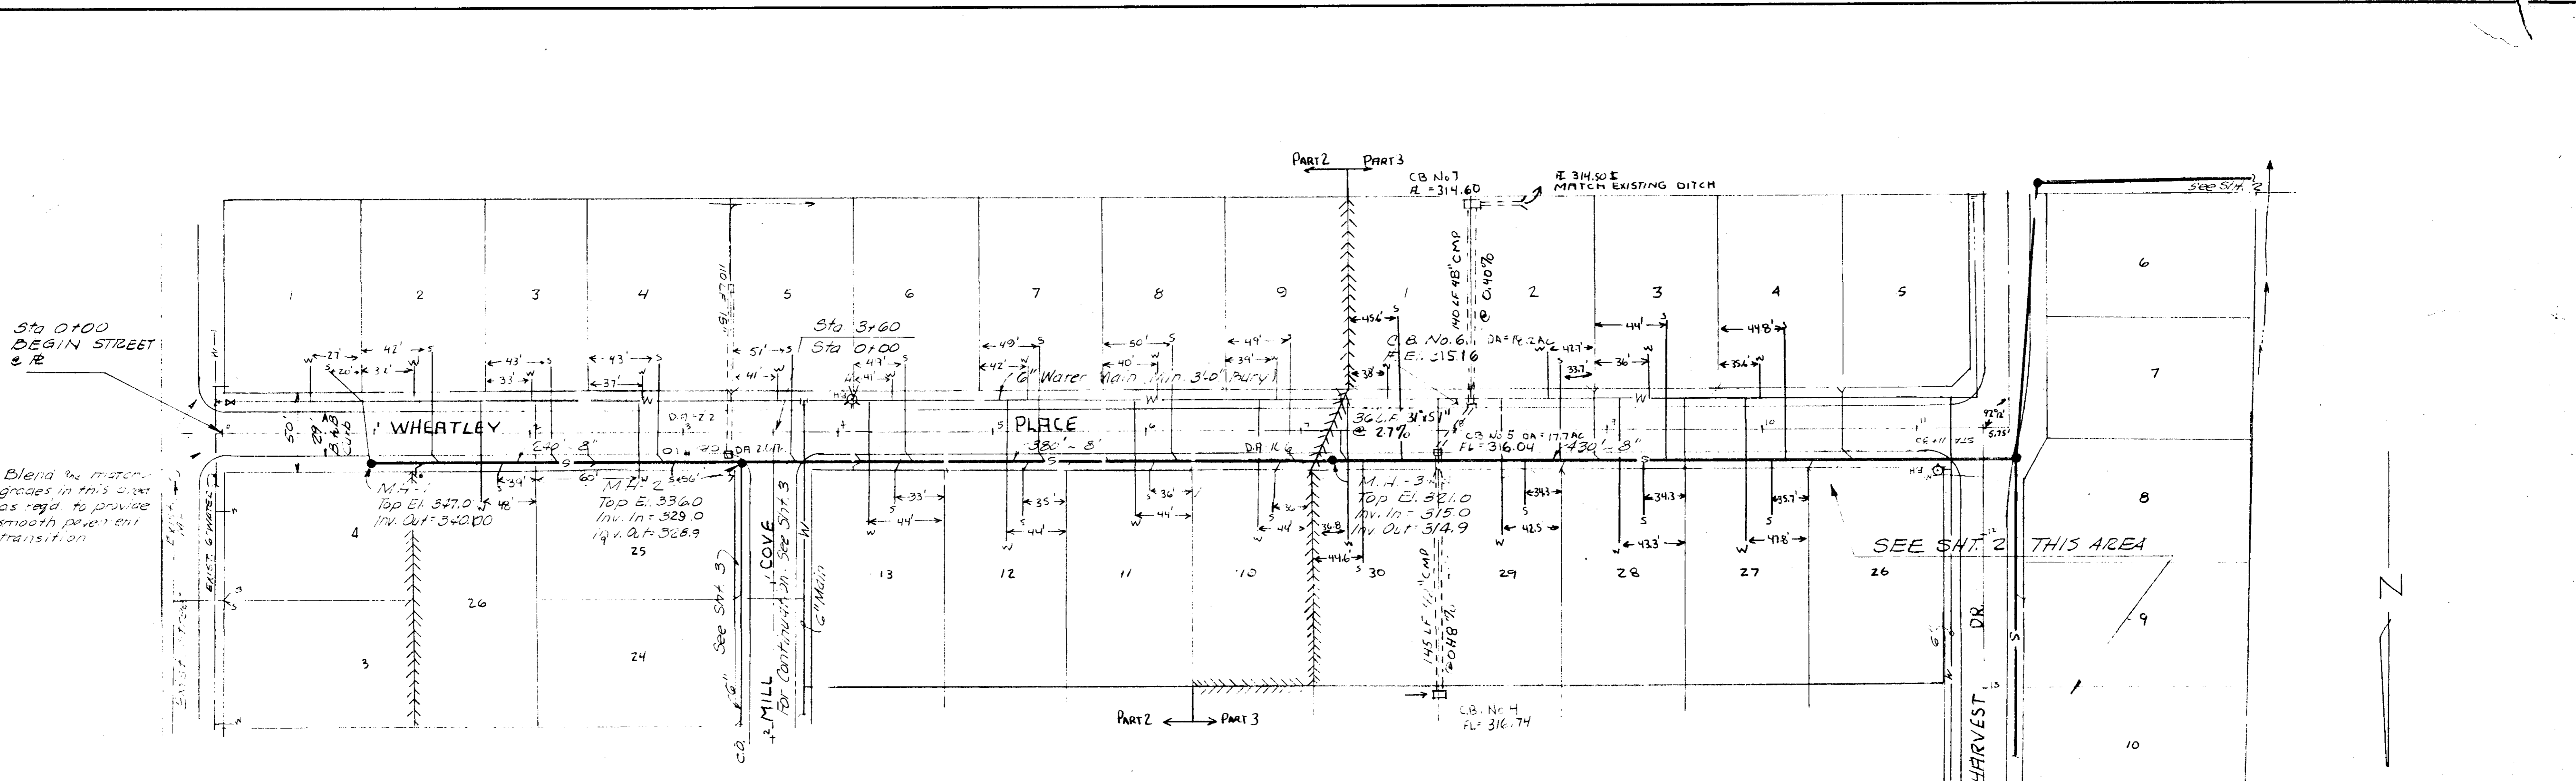

PLAN - SCALE: 1"=50'

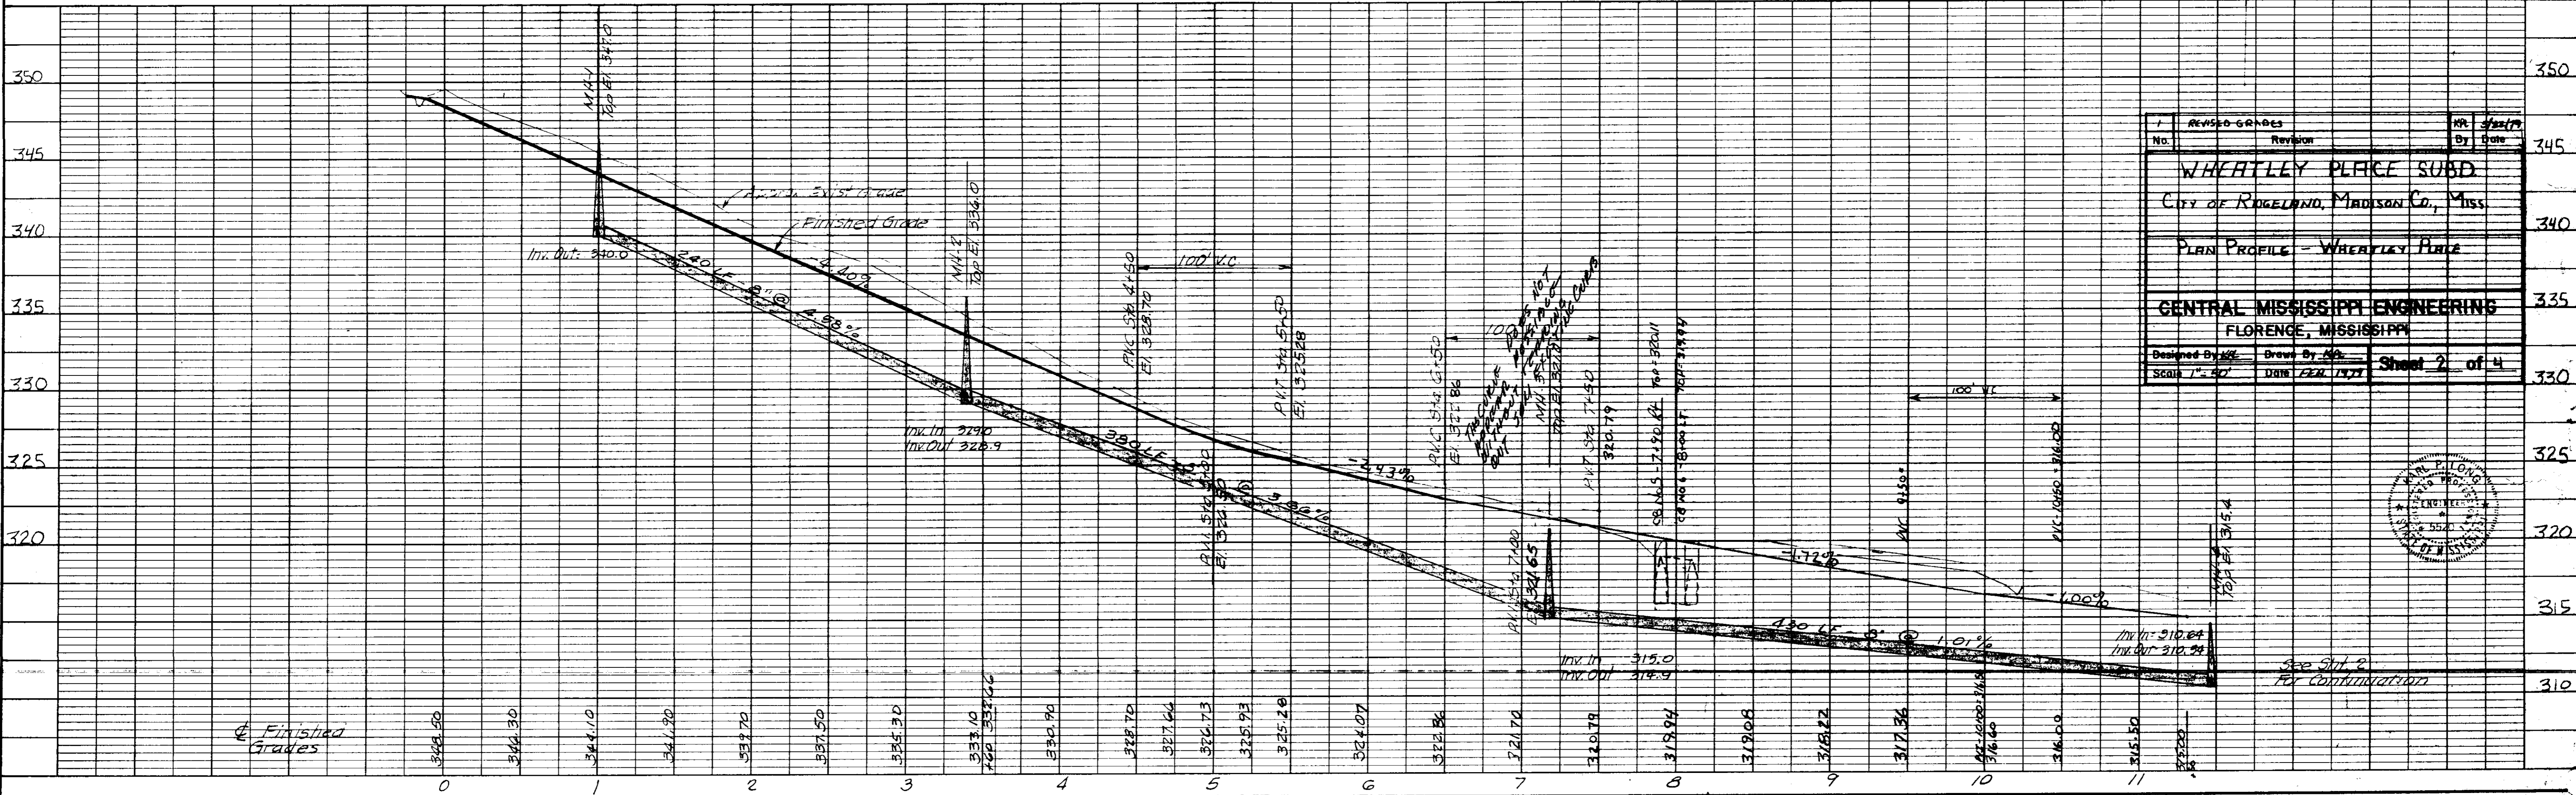

| | | |
|--|----------------|-----------------|
| 1 | REVISED GRADES | MR. [Signature] |
| No. | Revision | By Date |
| WHEATLEY PLACE SUBD. | | |
| CITY OF ROGELAND, MISSISSIPPI | | |
| PLAN PROFILE - WHEATLEY PLACE | | |
| GENERAL MISSISSIPPI ENGINEERING | | |
| FLORENCE, MISSISSIPPI | | |
| Designed By | Drawn By | Sheet 2 of 4 |
| Scale 1"=40' | Date FEB 1977 | |

