



**NATCHEZ TRACE SOUTH AREA**  
T-7-N, R-1-E

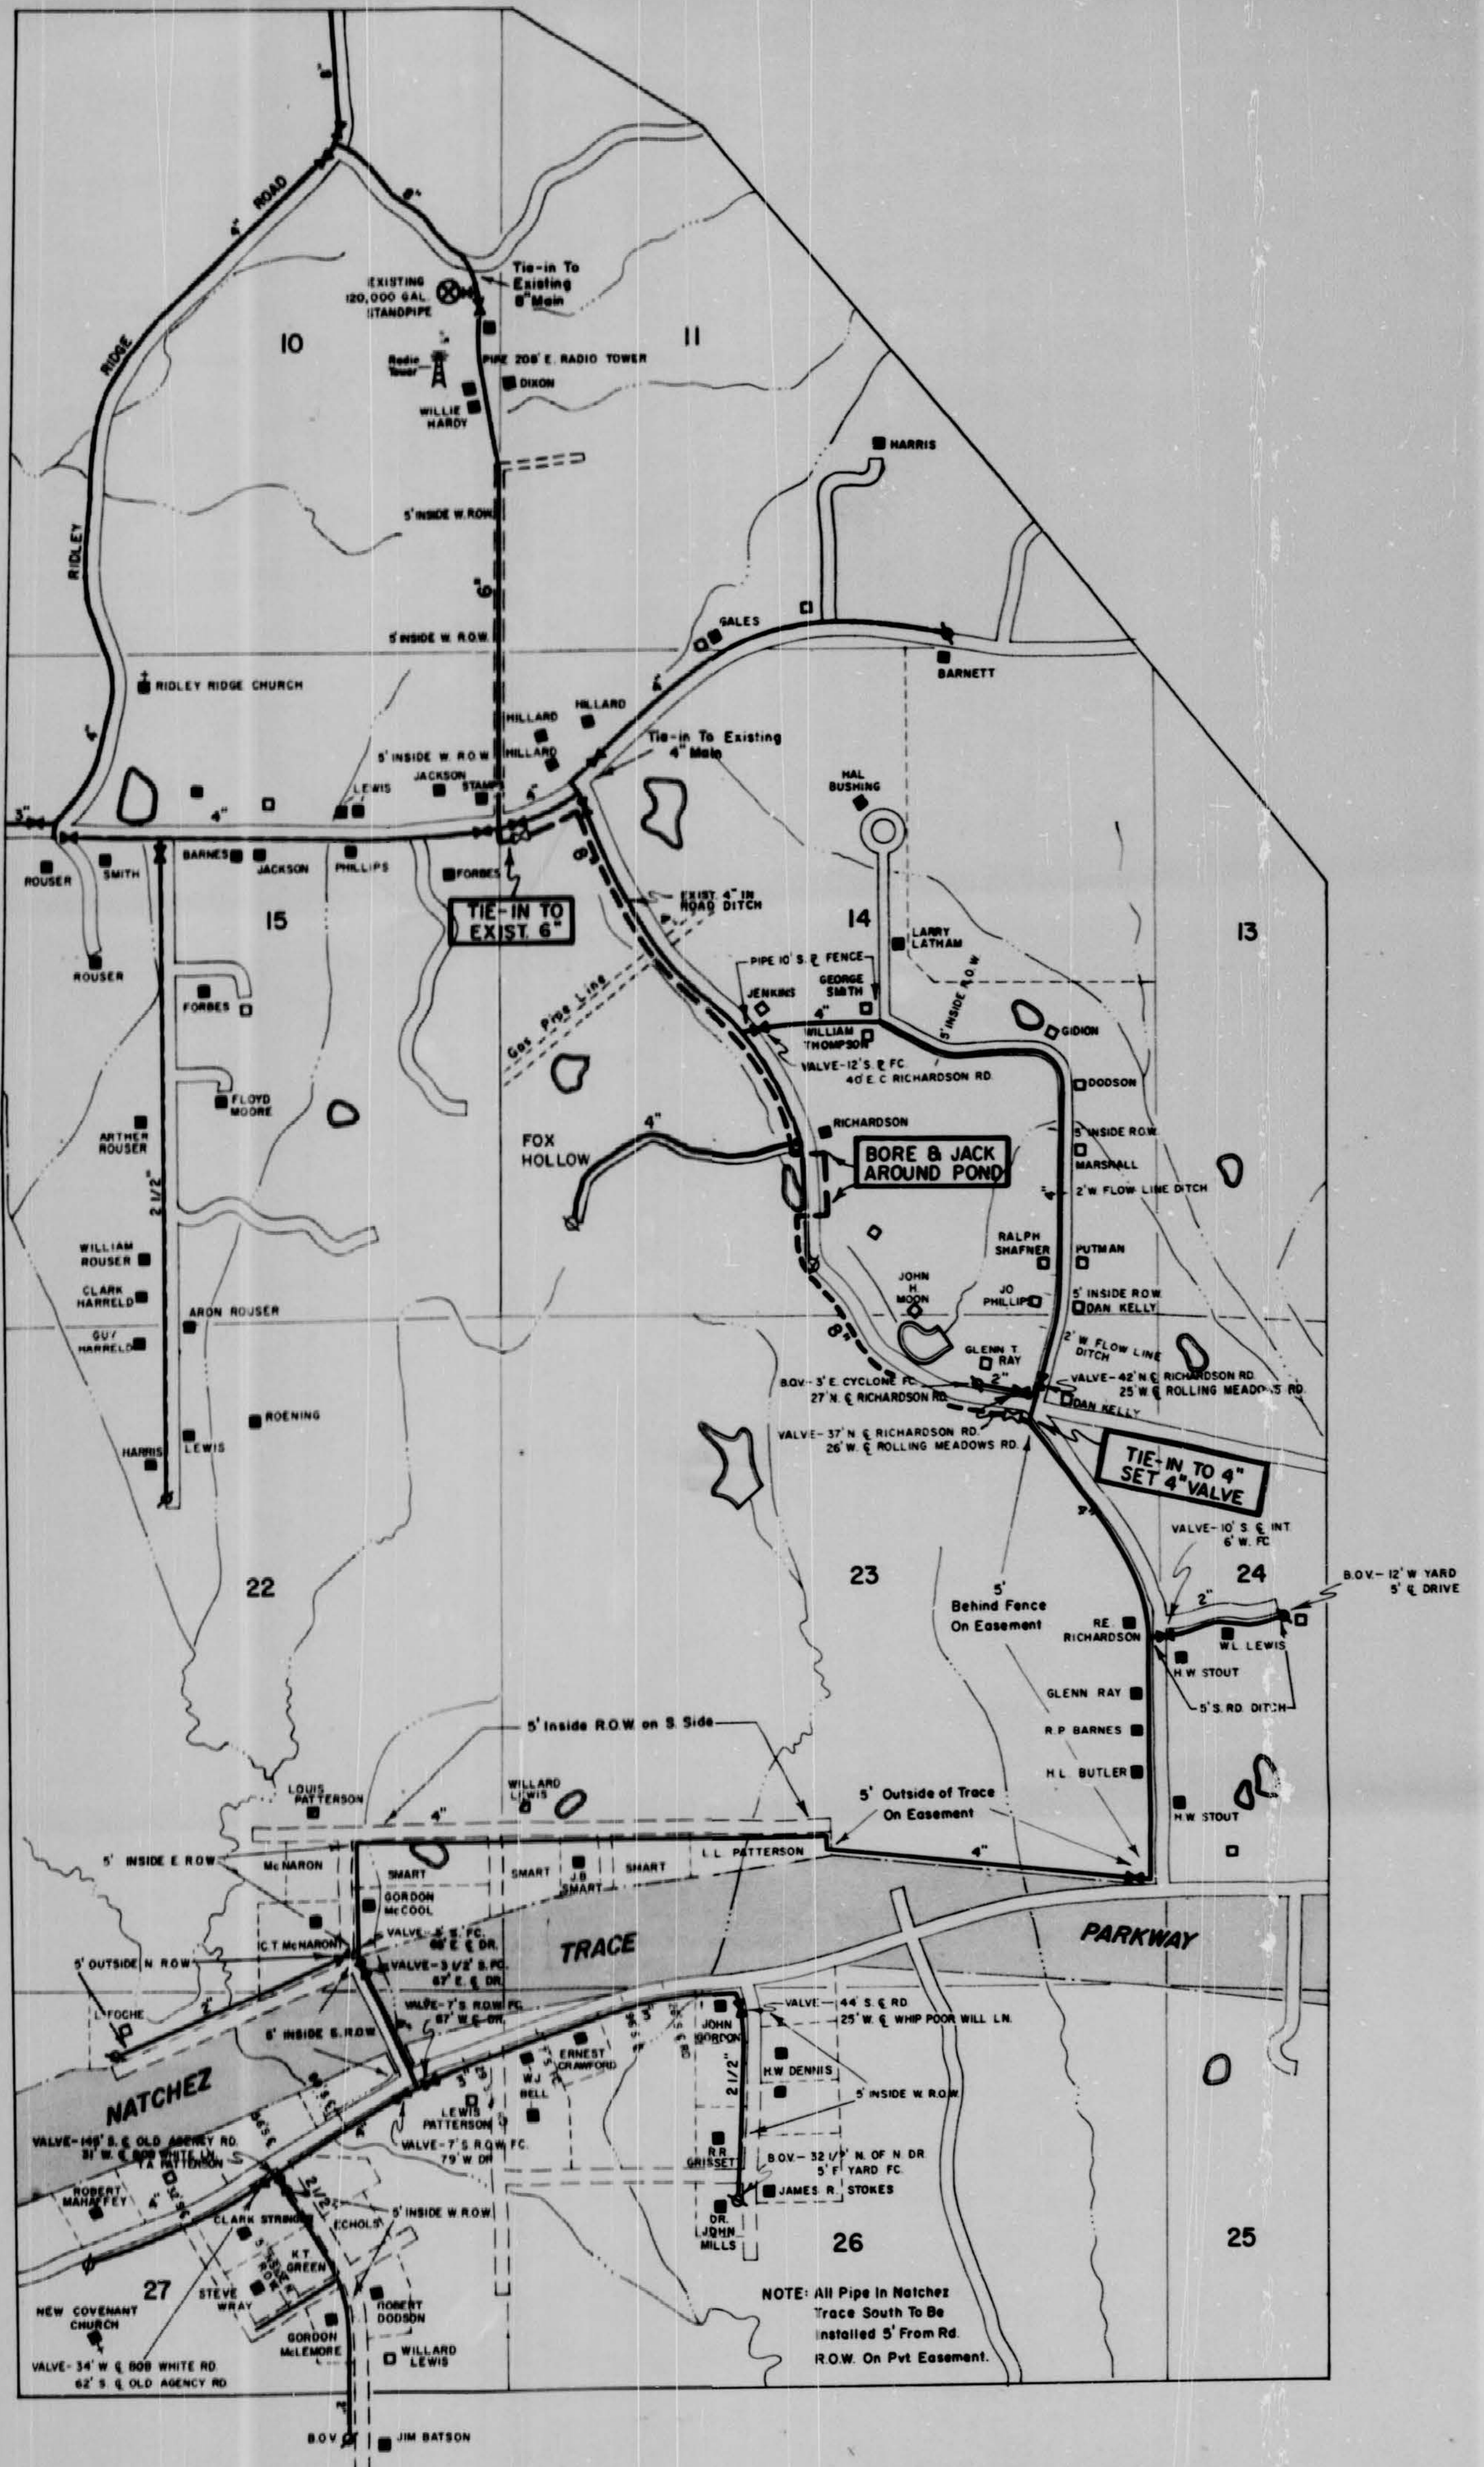

NOTE: All Pipe in Natchez Trace South To Be installed 5' From Rd. ROW. On Pvt Easement.

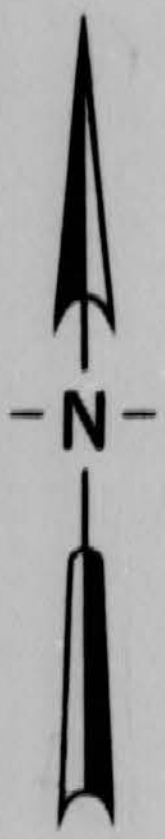

REVISIONS	
NO.	DATE
1	12/87 JAE
2	
3	
4	
5	
6	
7	
8	
9	
10	

DESIGNER		CHECKER	
NAME	DATE	NAME	DATE
J.R.M.	4/78	J.A.E.	
J.M.		J.M.	
J.A.E.		J.A.E.	

PROJECT	
NO.	DESCRIPTION
2	BEAR CREEK EXTENSION NUMBER 2 DISTRIBUTION SYSTEM