TIE M-No.1 - SEE BOOK 1513 PAGE 26
COTTON P. SPIKE IN WEST POLE
STR. No. 115 EL. 336.91

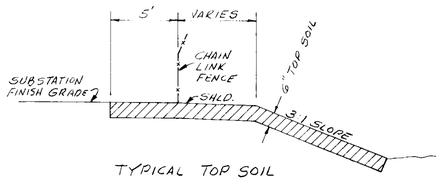

TYPICAL TOP SOIL PLACEMENT AREA (ENTIRE PERIMETER) N.T.S.

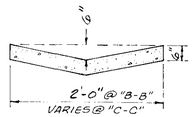

SECTION "B-B"/"C-C"

TYPICAL PAVED DITCH
~NTS~

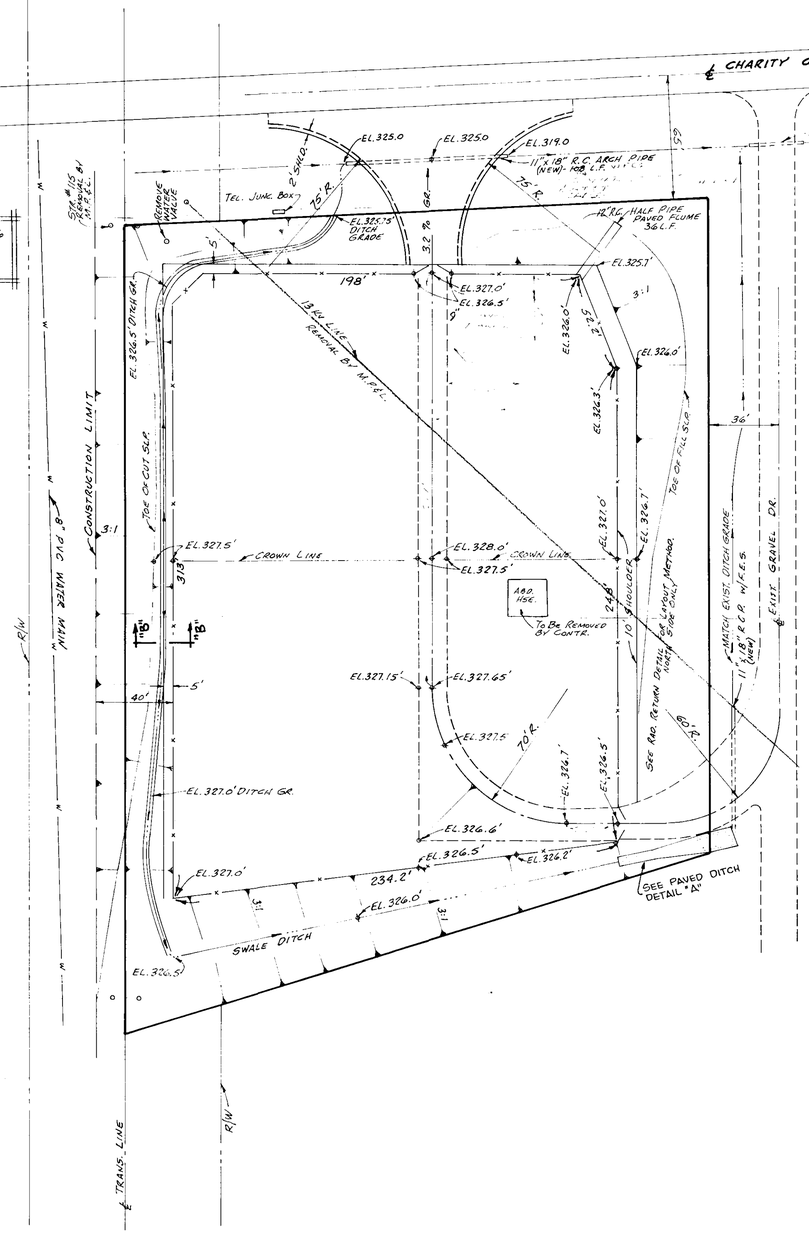

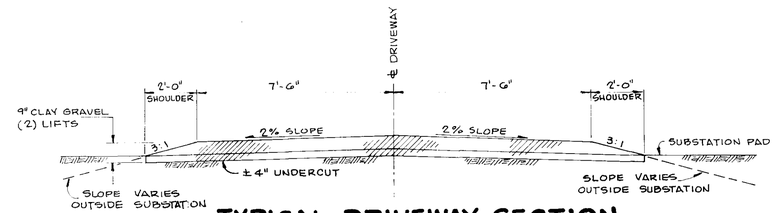

TYPICAL DRIVEWAY SECTION
~NTS~

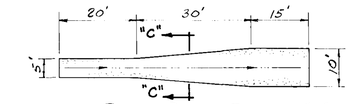

PAVED DITCH DETAIL "A"
N.T.S.
(NEAR SE CORNER PROPERTY)

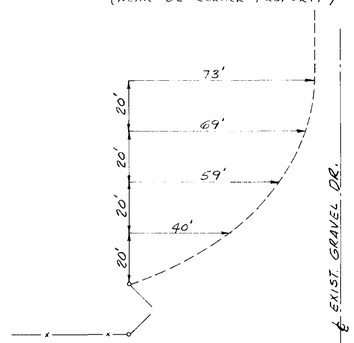

NORTH SIDE RAD. RET.
USE FOR LAYOUT PROCEDURE
N.T.S.

GRADING & DRAINAGE PLAN
CHARITY CHURCH ROAD 115KV SUBSTATION
MISSISSIPPI POWER & LIGHT COMPANY
JACKSON, MISSISSIPPI

DATE: 3-30-87 SCALE: 1"=40' MS-D-7488

PWP-00302

NO	DATE	REVISION	BY	CH.	GRPH.	CORR.	APP.

DRAWN BY W.K.M.
TRACED BY J.H.C.
CHECKED BY
GRAPHICS CH.
CORRECT
APPROVED

AUG. 1984