



NO MAP

81

4

3

111

97

MADISON COUNTY T1N-R1E 33 34  
HINDS COUNTY T6N-R1E

CITY LIMITS 1971

CITY LIMITS 1971

NOTE: SEWER MAINLINE  
LOCATIONS APPROXIMATE  
SEE P. 9-901



97-B

59.0 AC.

61.0 AC

101.2 AC

58 AC

70.0 AC

33

34

81-A

111-A

97-A

97

LIVINGSTON ROAD

M.P. & L. 150' EASEMENT

33 34

MISS. POWER AND LIGHT COMPANY 150' EASEMENT

COSTAS LAKE

HIGHLAND COLONY PARKWAY

MADISON JACKSON

CORPORATE

COUNTY

33 34

COUNTY

LINE

ROAD

HINDS

COUNTY

HANGING MOSS RD.

INTERSTATE 220

2001 M 1471 GIRL SCOUTS OFFICE

DODWOOD PARK OF LAKE OVER


100 GPM PUMP AND STA. 40' EASEMENT QM-16/13(S)

3.4 AC. QM-16/13(S)

Q-1656(S) Q-1656(S)

Q-1656(S)

Q-1656(S)

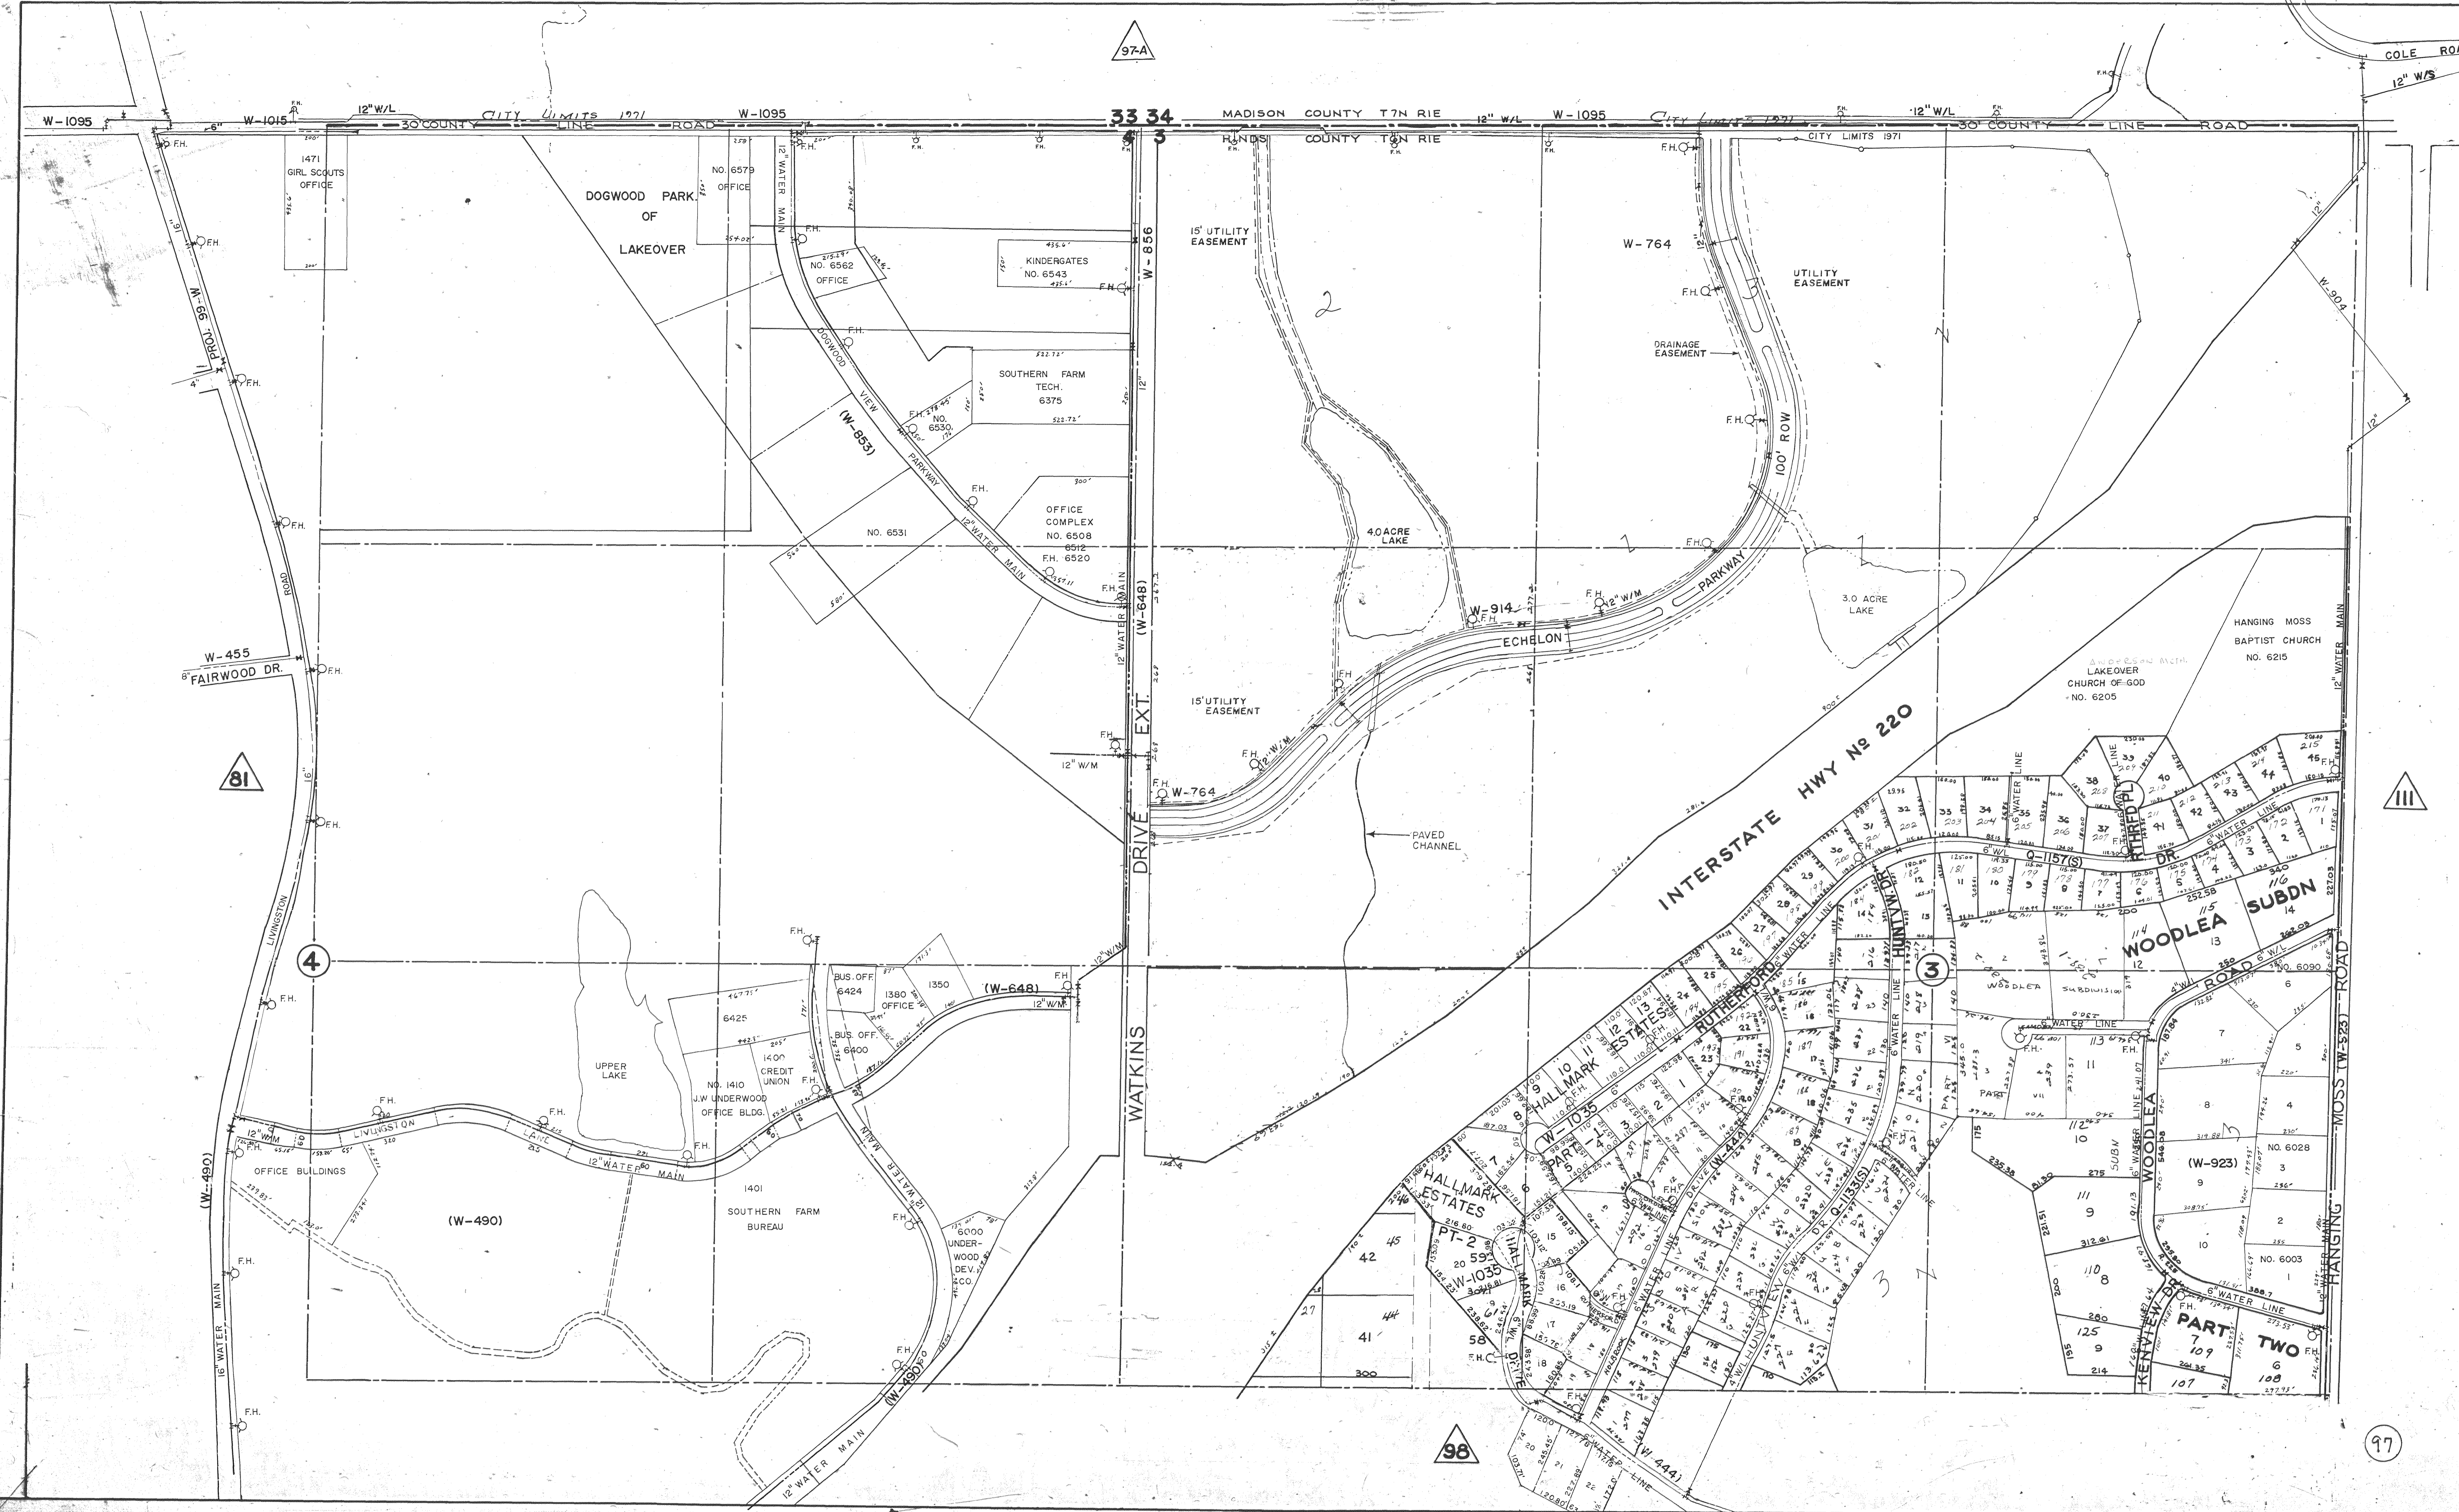

97-A

33 34

81

4

98

97

INTERSTATE HWY No 220

WOODLEA SUBDN

HALLMARK ESTATES

RUTHERFORD

W-923

PART TWO

1471 GIRL SCOUTS OFFICE

DOGWOOD PARK OF LAKEOVER

NO. 6579 OFFICE

NO. 6562 OFFICE

KINDERGATES NO. 6543

SOUTHERN FARM TECH. 6375

OFFICE COMPLEX NO. 6508

NO. 6531

4.0 ACRE LAKE

3.0 ACRE LAKE

HANGING MOSS BAPTIST CHURCH NO. 6215

LAKEOVER CHURCH OF GOD NO. 6205

BUS. OFF. 6424

OFFICE 1380

OFFICE 1350

BUS. OFF. 6400

OFFICE 1400

CREDIT UNION

NO. 1410 J.W. UNDERWOOD OFFICE BLDG.

OFFICE 1401

SOUTHERN FARM BUREAU

6000 UNDERWOOD DEV. CO.






45

20

55

56

57

58

59

60

10

11

28

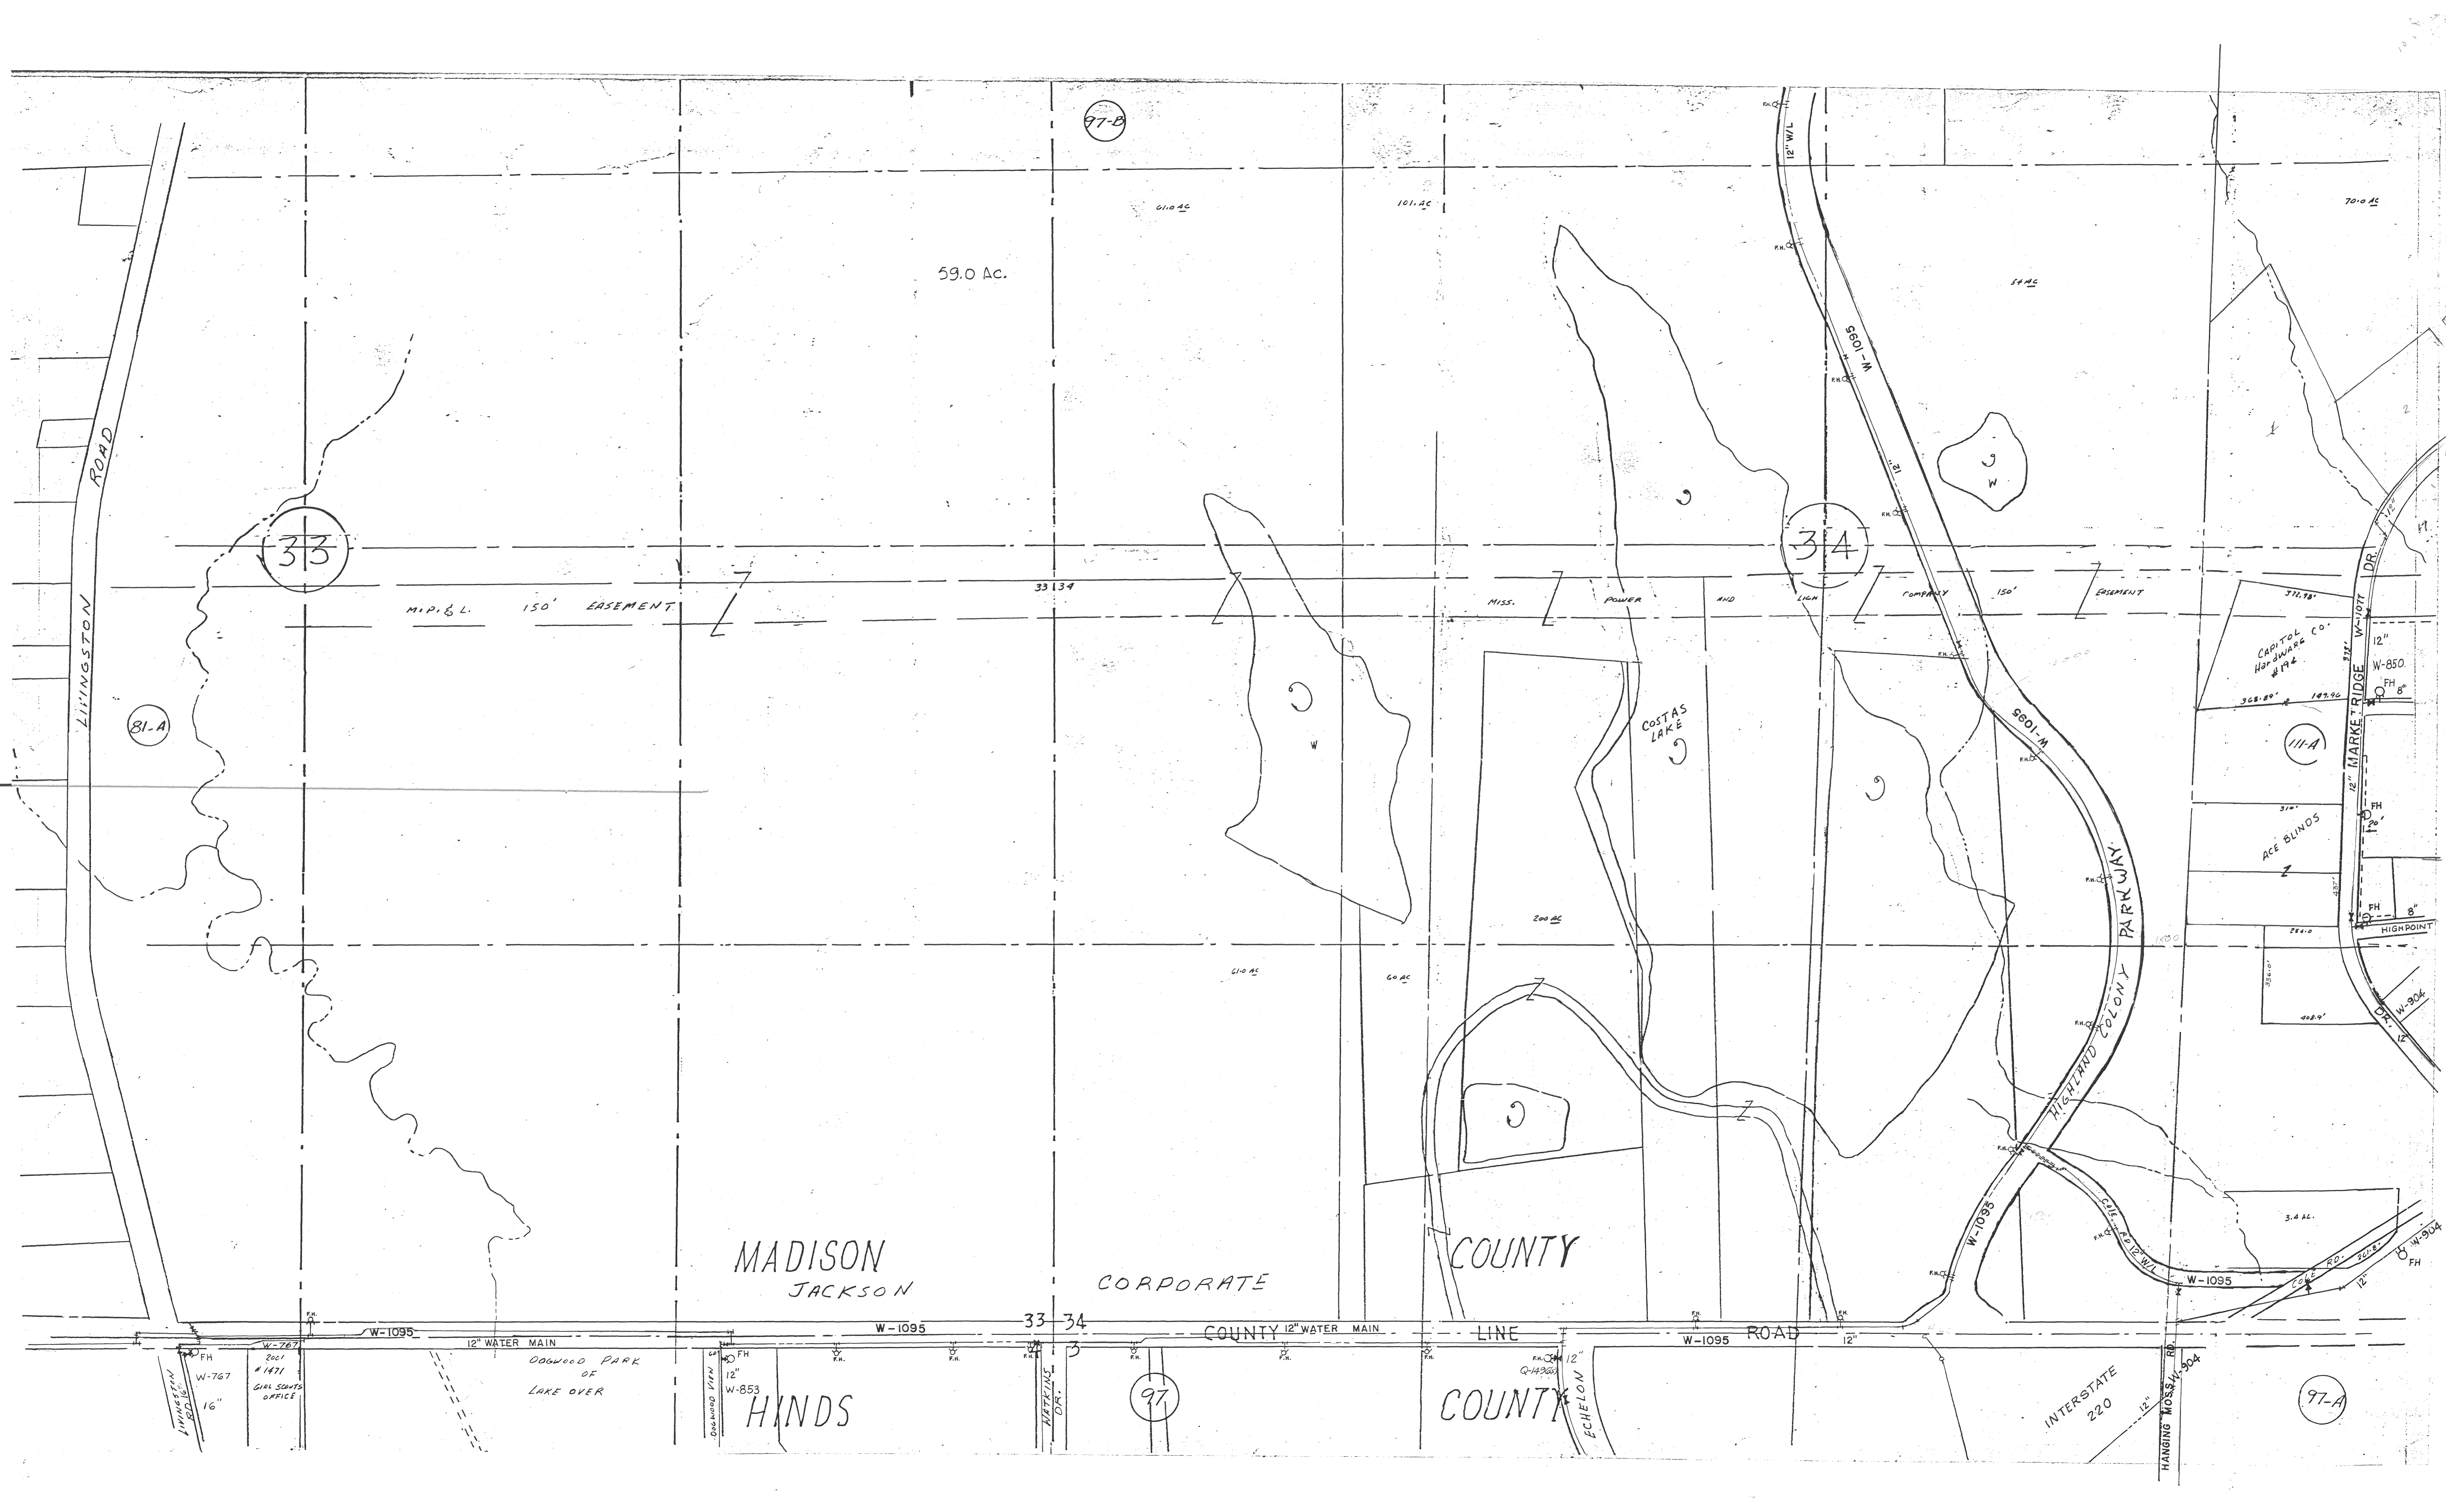

97-B

59.0 Ac.

33

34

M.P. & L. 150' EASEMENT

33 | 34

MISS. POWER AND LIGHT COMPANY 150' EASEMENT

81-A

111-A

ACE BLINDS

HIGHPOINT

MADISON JACKSON

CORPORATE

COUNTY

HINDS

97

COUNTY

97-A

W-1095

W-1095

33 | 34

COUNTY 12" WATER MAIN

LINE

W-1095

ROAD

INTERSTATE 220

LIVINGSTON ROAD

HIGHLAND COLONY PARKWAY

MARKET RIDGE DR.

CAPITOL HARDWARE CO. #192

DOGWOOD PARK OF LAKE OVER

W-767

W-767

2001 #1471 GIRL SCOUTS OFFICE

W-853

MATKINS DR.

ECHOLON

HANGING MOSS RD

W-904

W-904


W-904






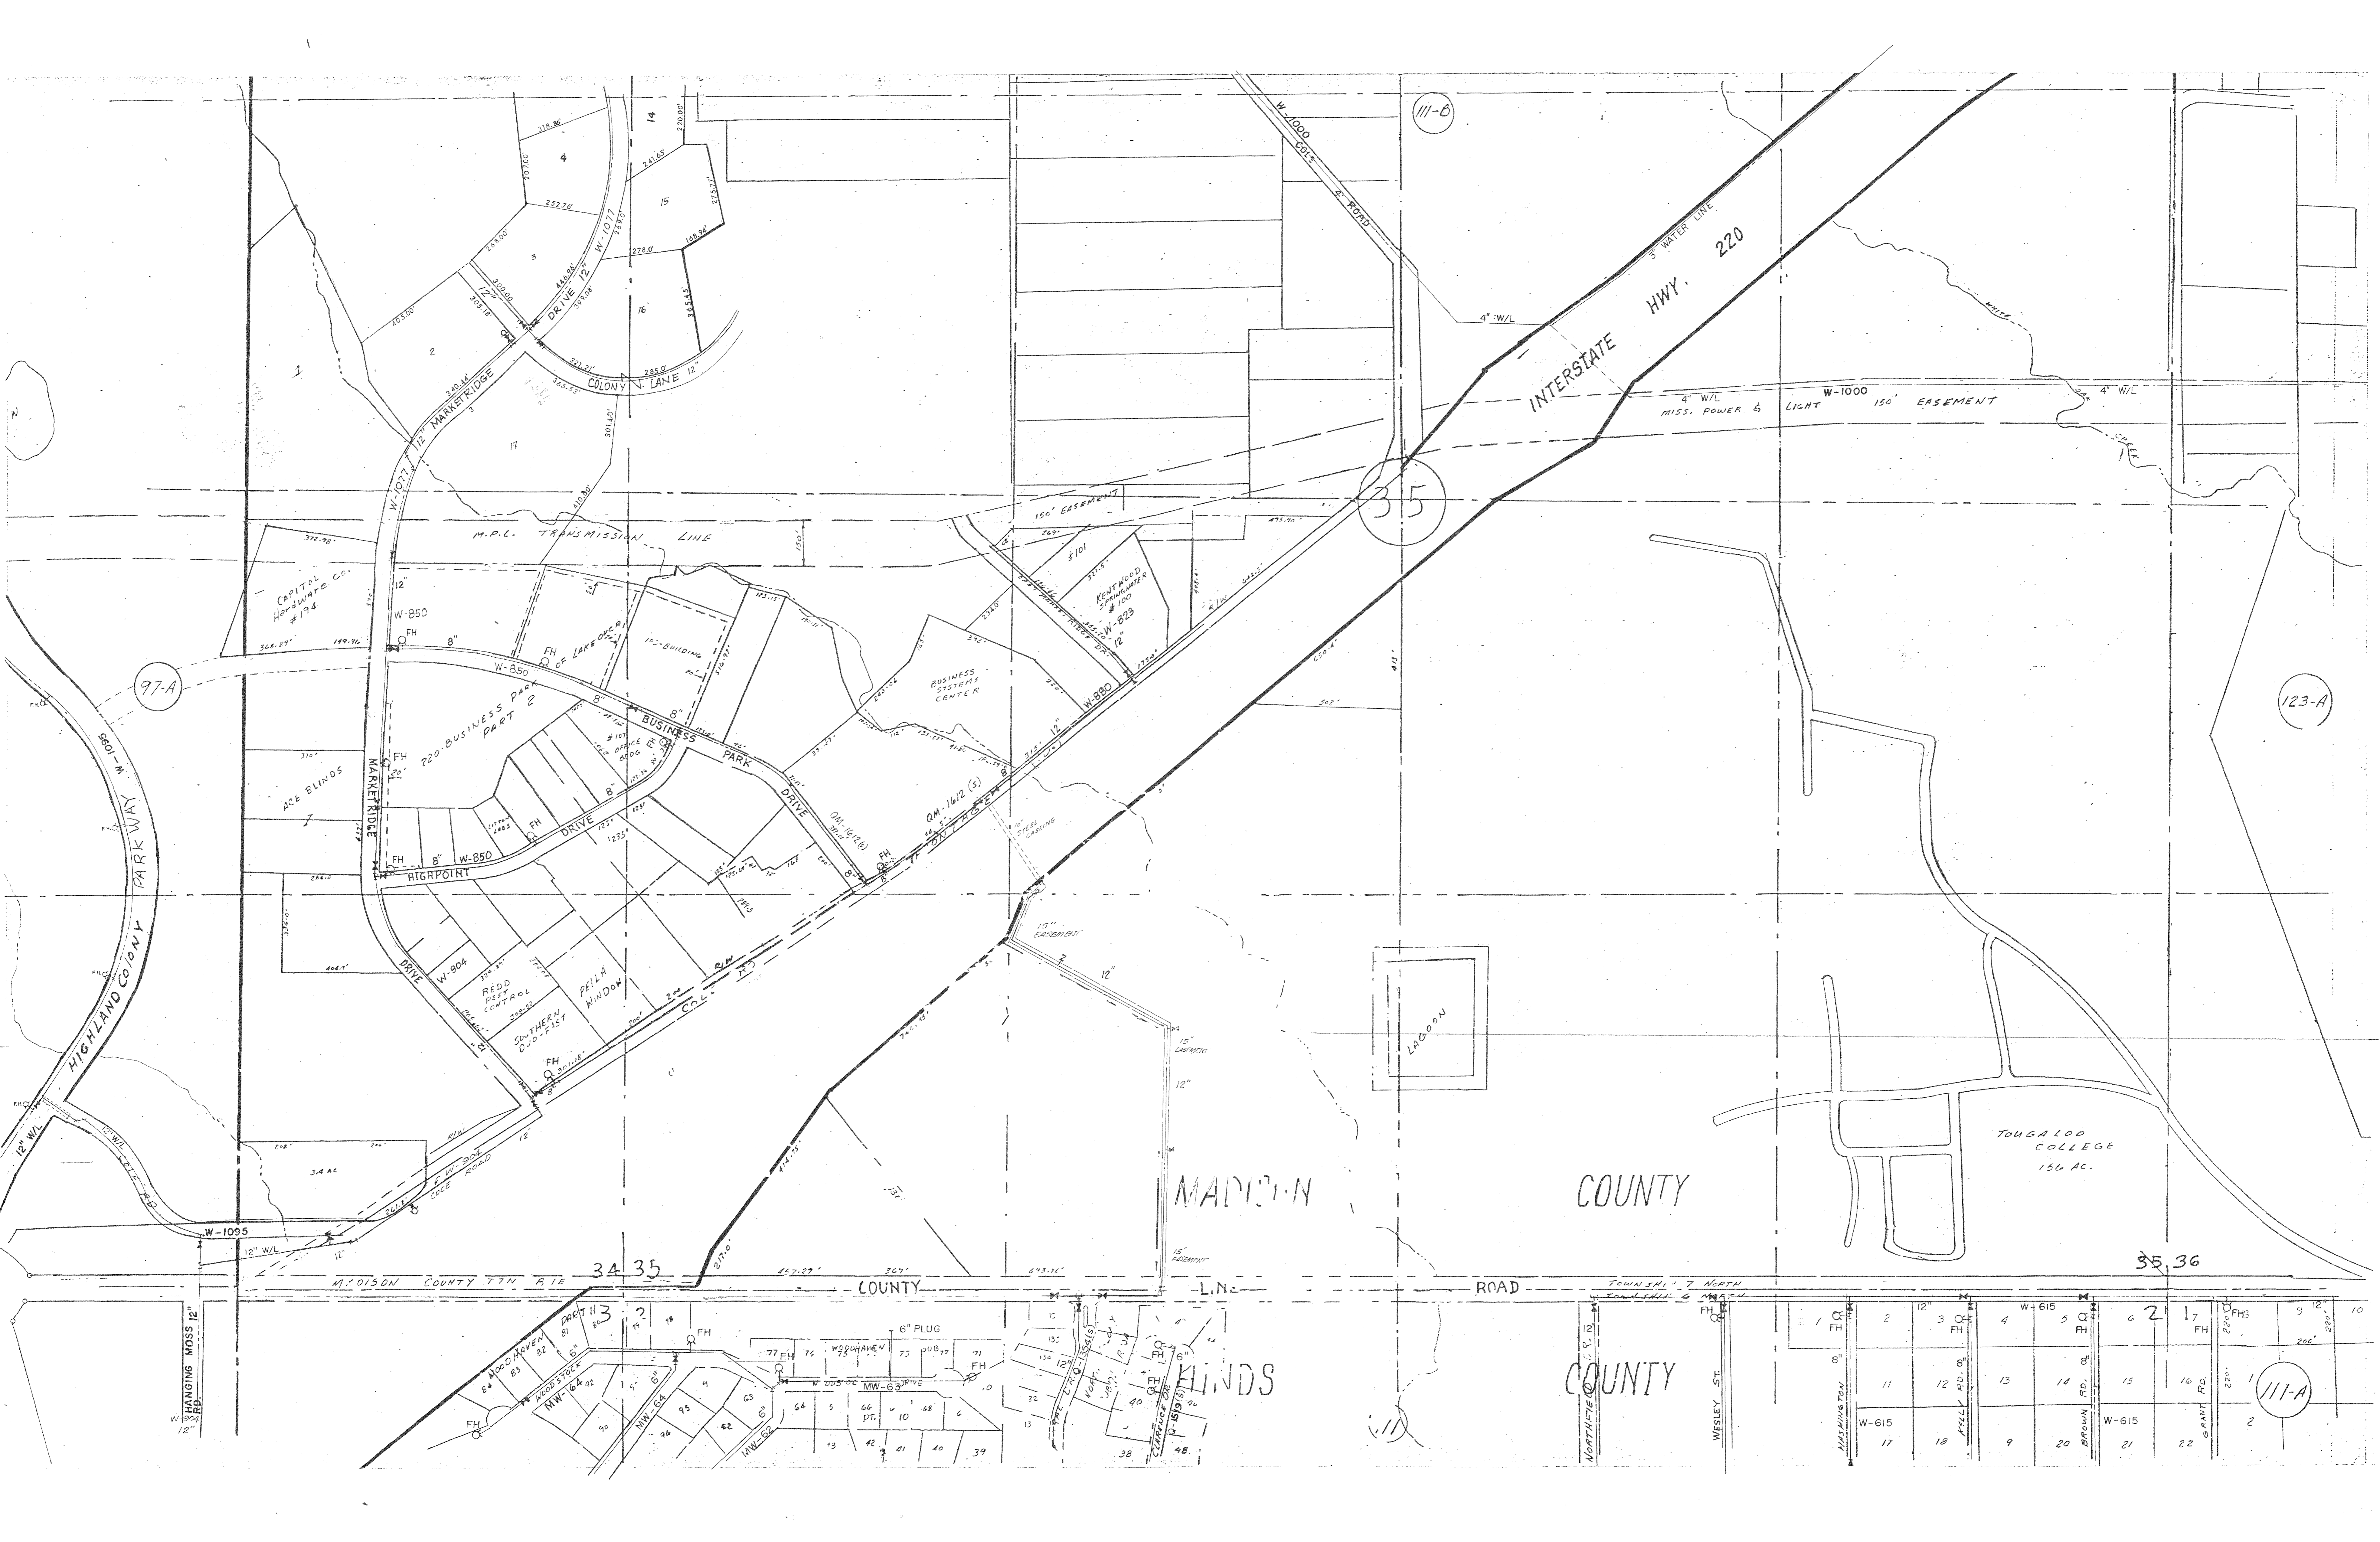

97-A

111-B

35

123-A

MADISON COUNTY

BLINDS

COUNTY

TOUGALOO COLLEGE  
150 AC.

35, 36



111-A

MAP LIMIT  
111-C

26

97-B

123-B

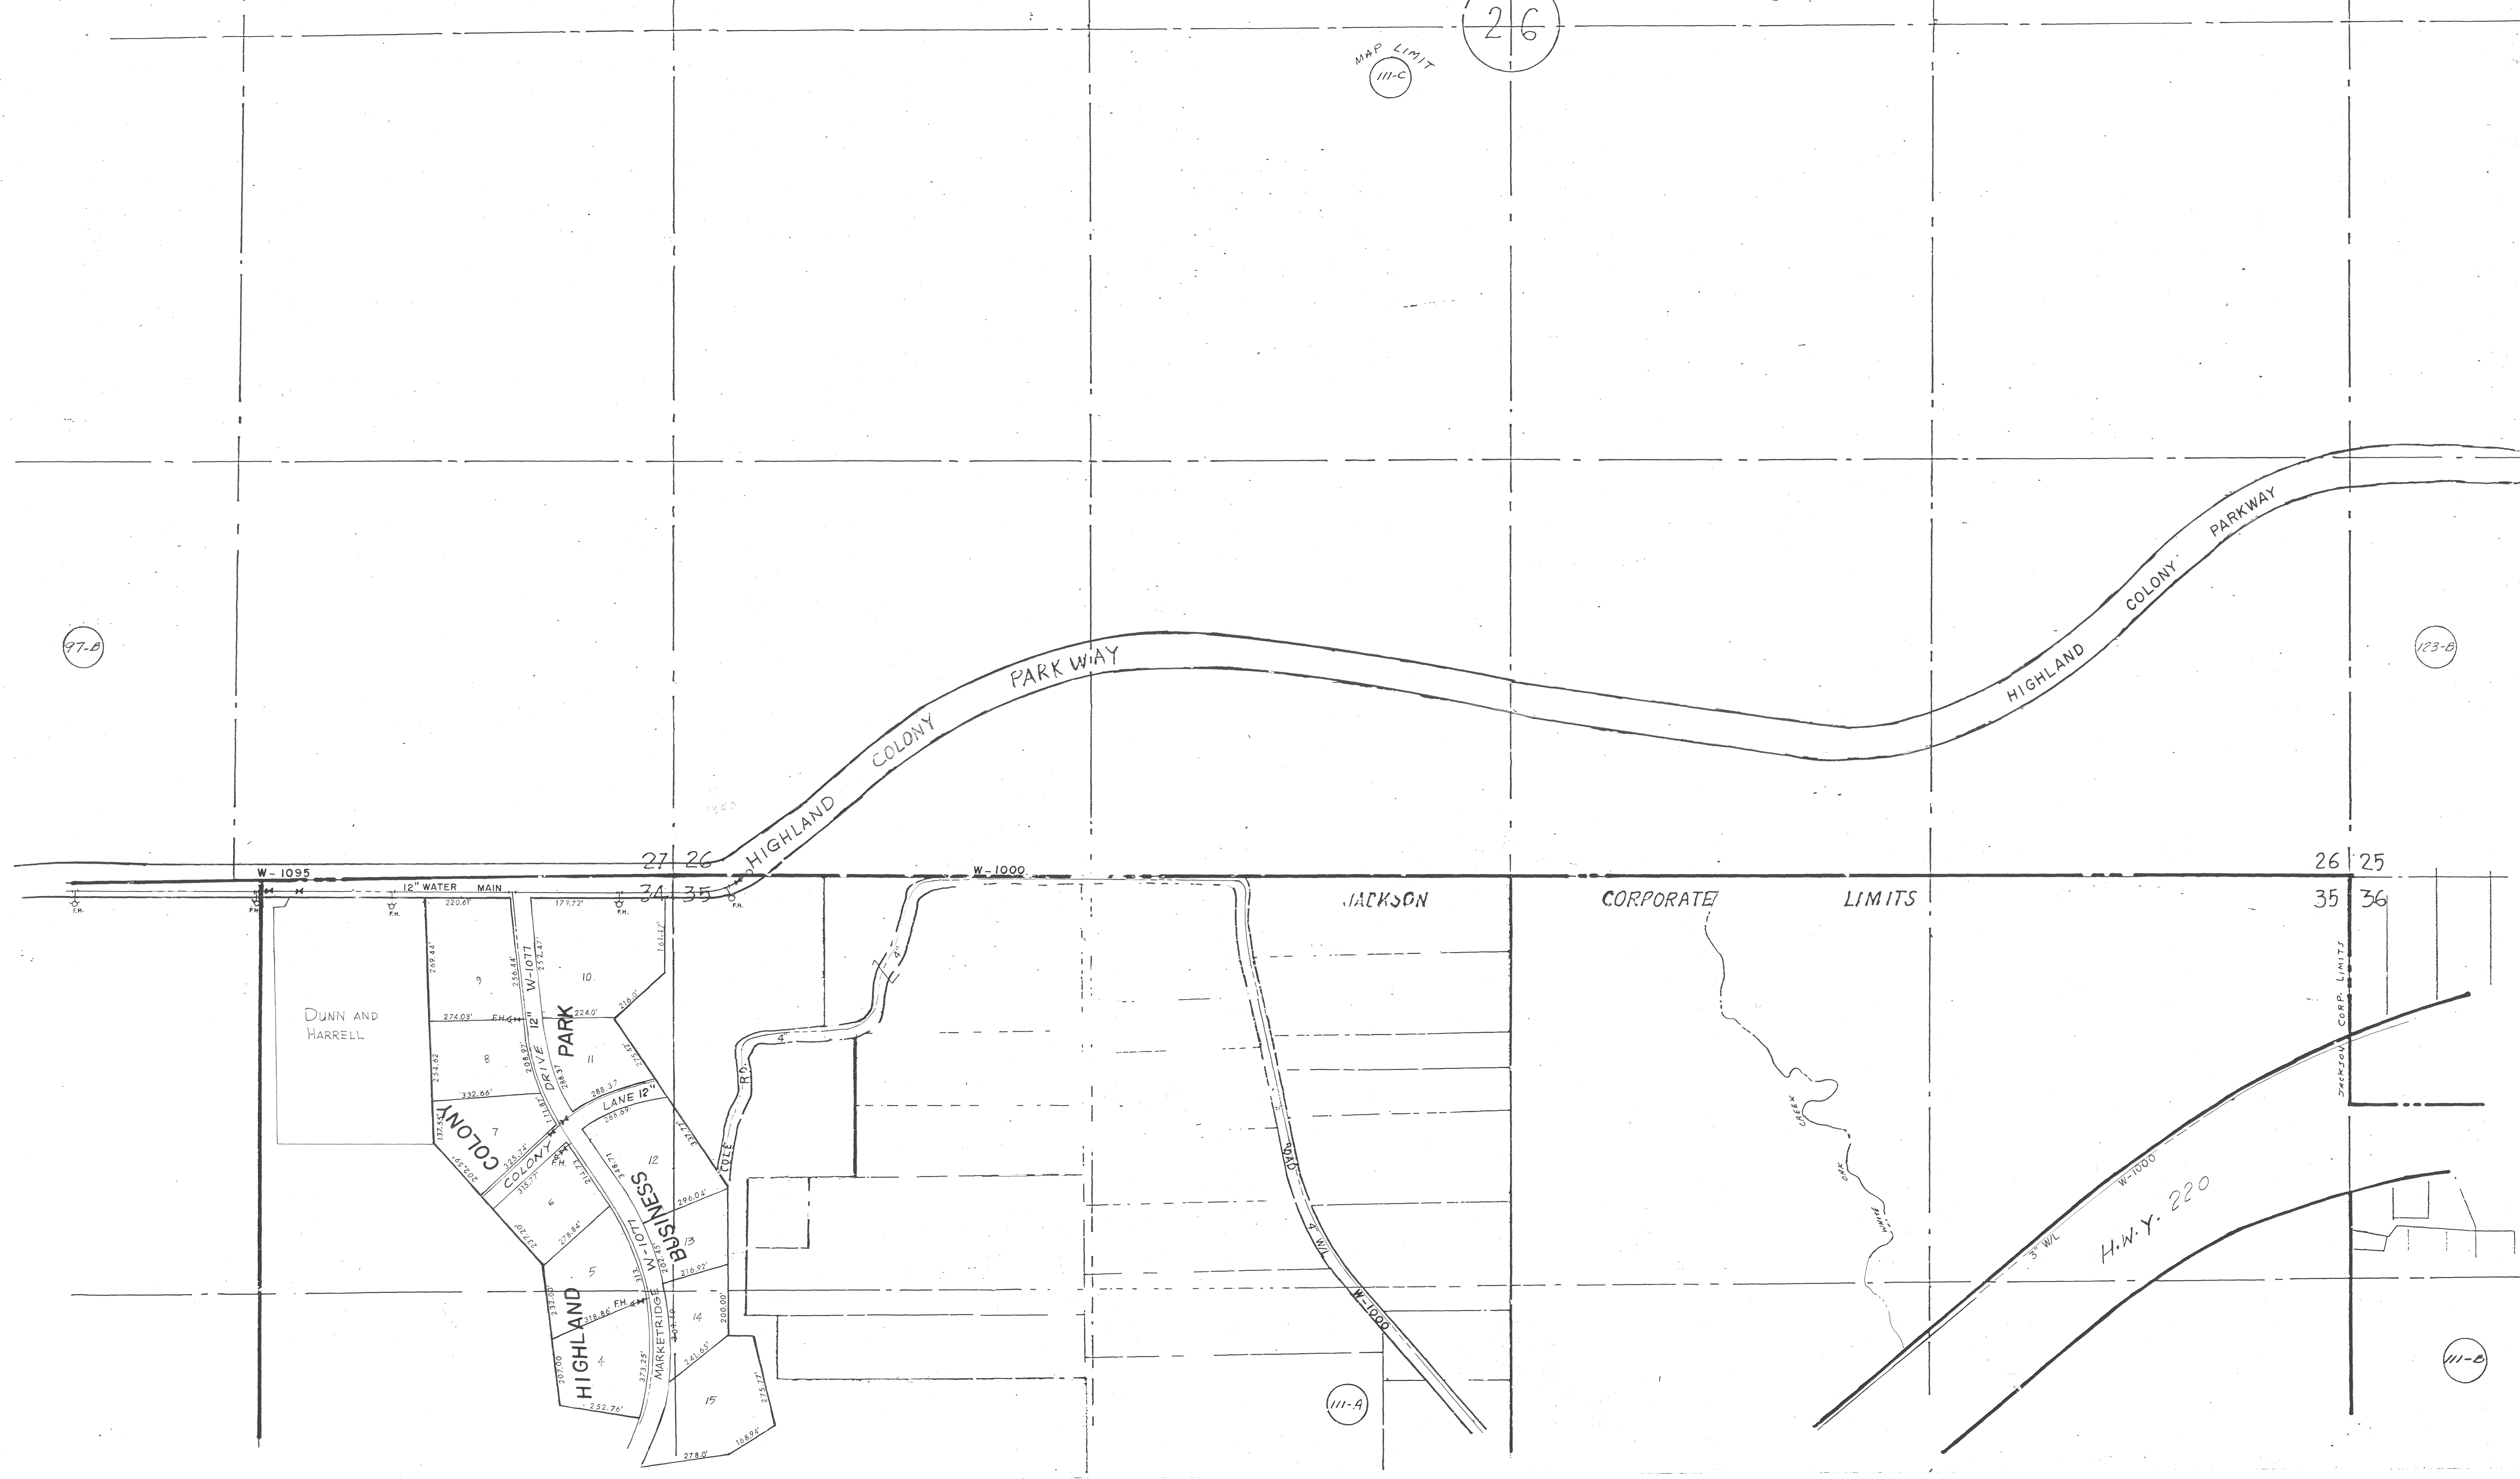

W-1095

12" WATER MAIN

27 26

W-1000

26 25

35 36

DUNN AND HARRELL

COLONY PARK DRIVE

LANE 12

BUSINESS

HIGHLAND

JACKSON

CORPORATE

LIMITS

JACKSON CORP. LIMITS


H.W.Y. 220

111-A

111-B





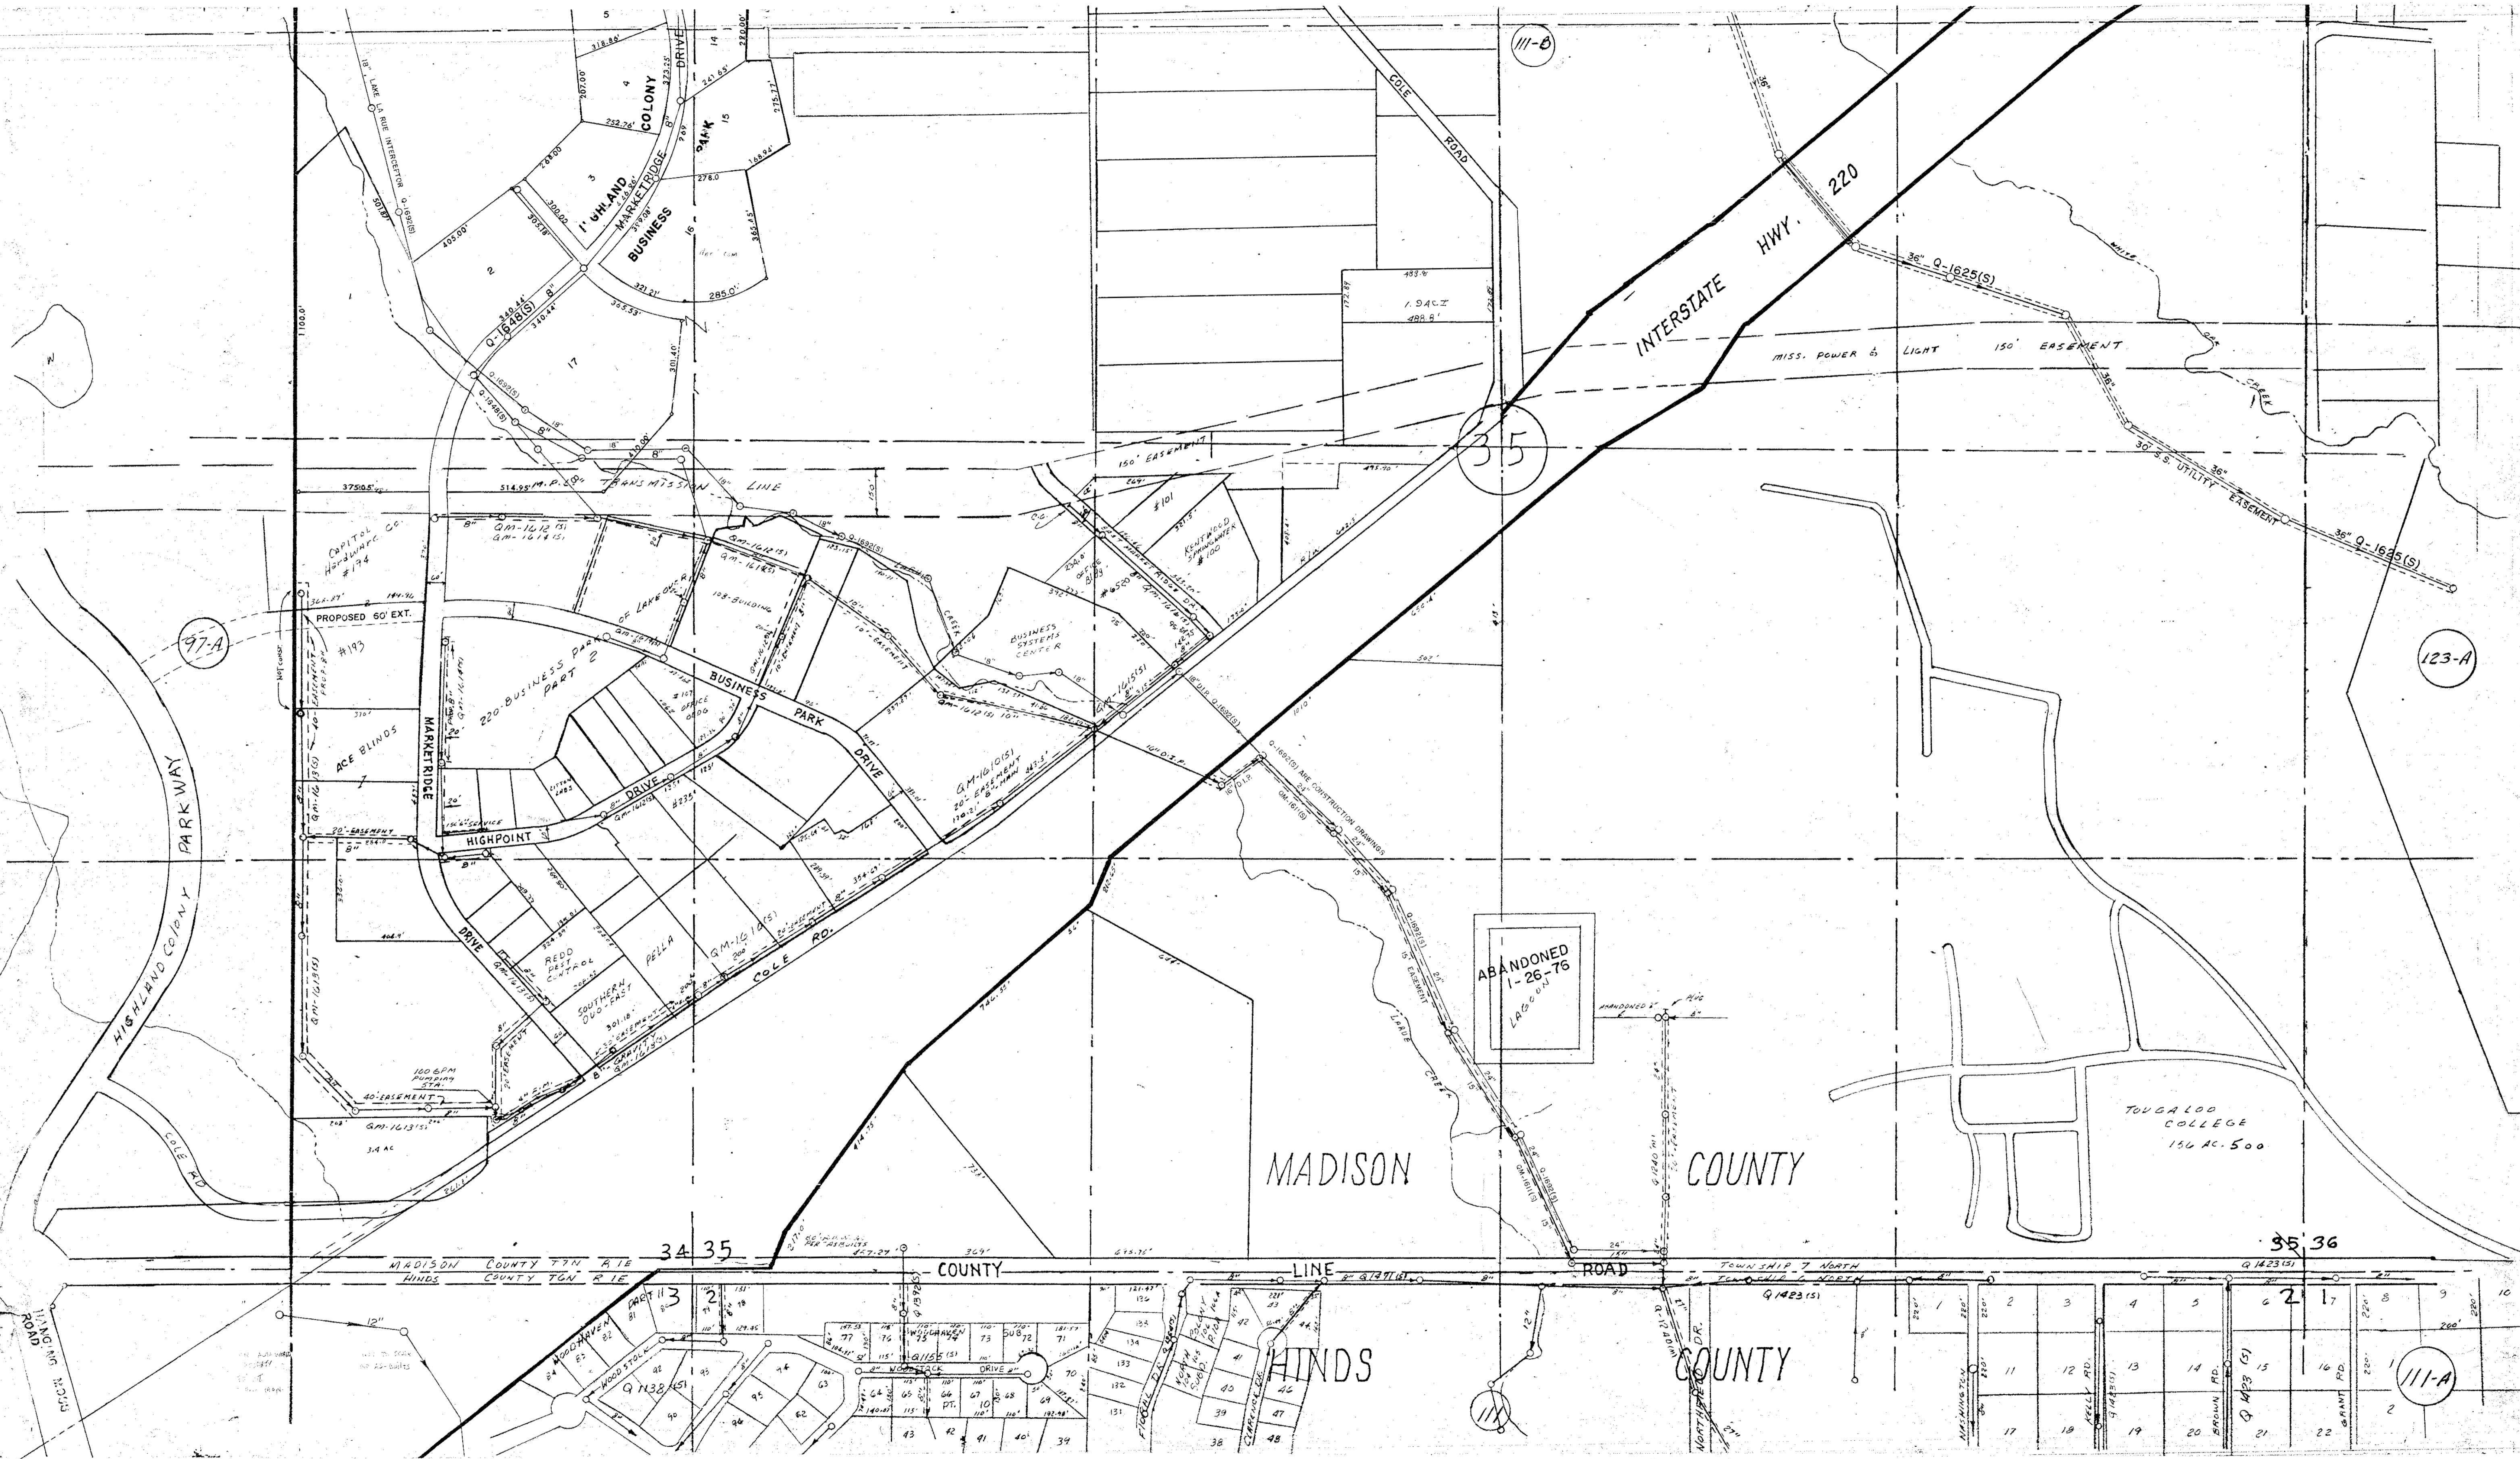

111-B

35

123-A

97-A

ABANDONED  
1-26-76  

MADISON

COUNTY

TOUGALOO COLLEGE  
156 AC. 500

34 35

35 36

MADISON COUNTY T7N R1E  
HINDS COUNTY T6N R1E

COUNTY

LINE

ROAD

TOWNSHIP 7 NORTH  

HINDS

COUNTY

111-A



26

MAP LIMIT  
III-C

97-B

123-B

PARKWAY




27 26

RIDGELAND  
JACKSON

CORPORATE  
CORPORATE  
LIMITS  
LIMITS

26 25  
35 36

HIGHLAND COLONY 34 35

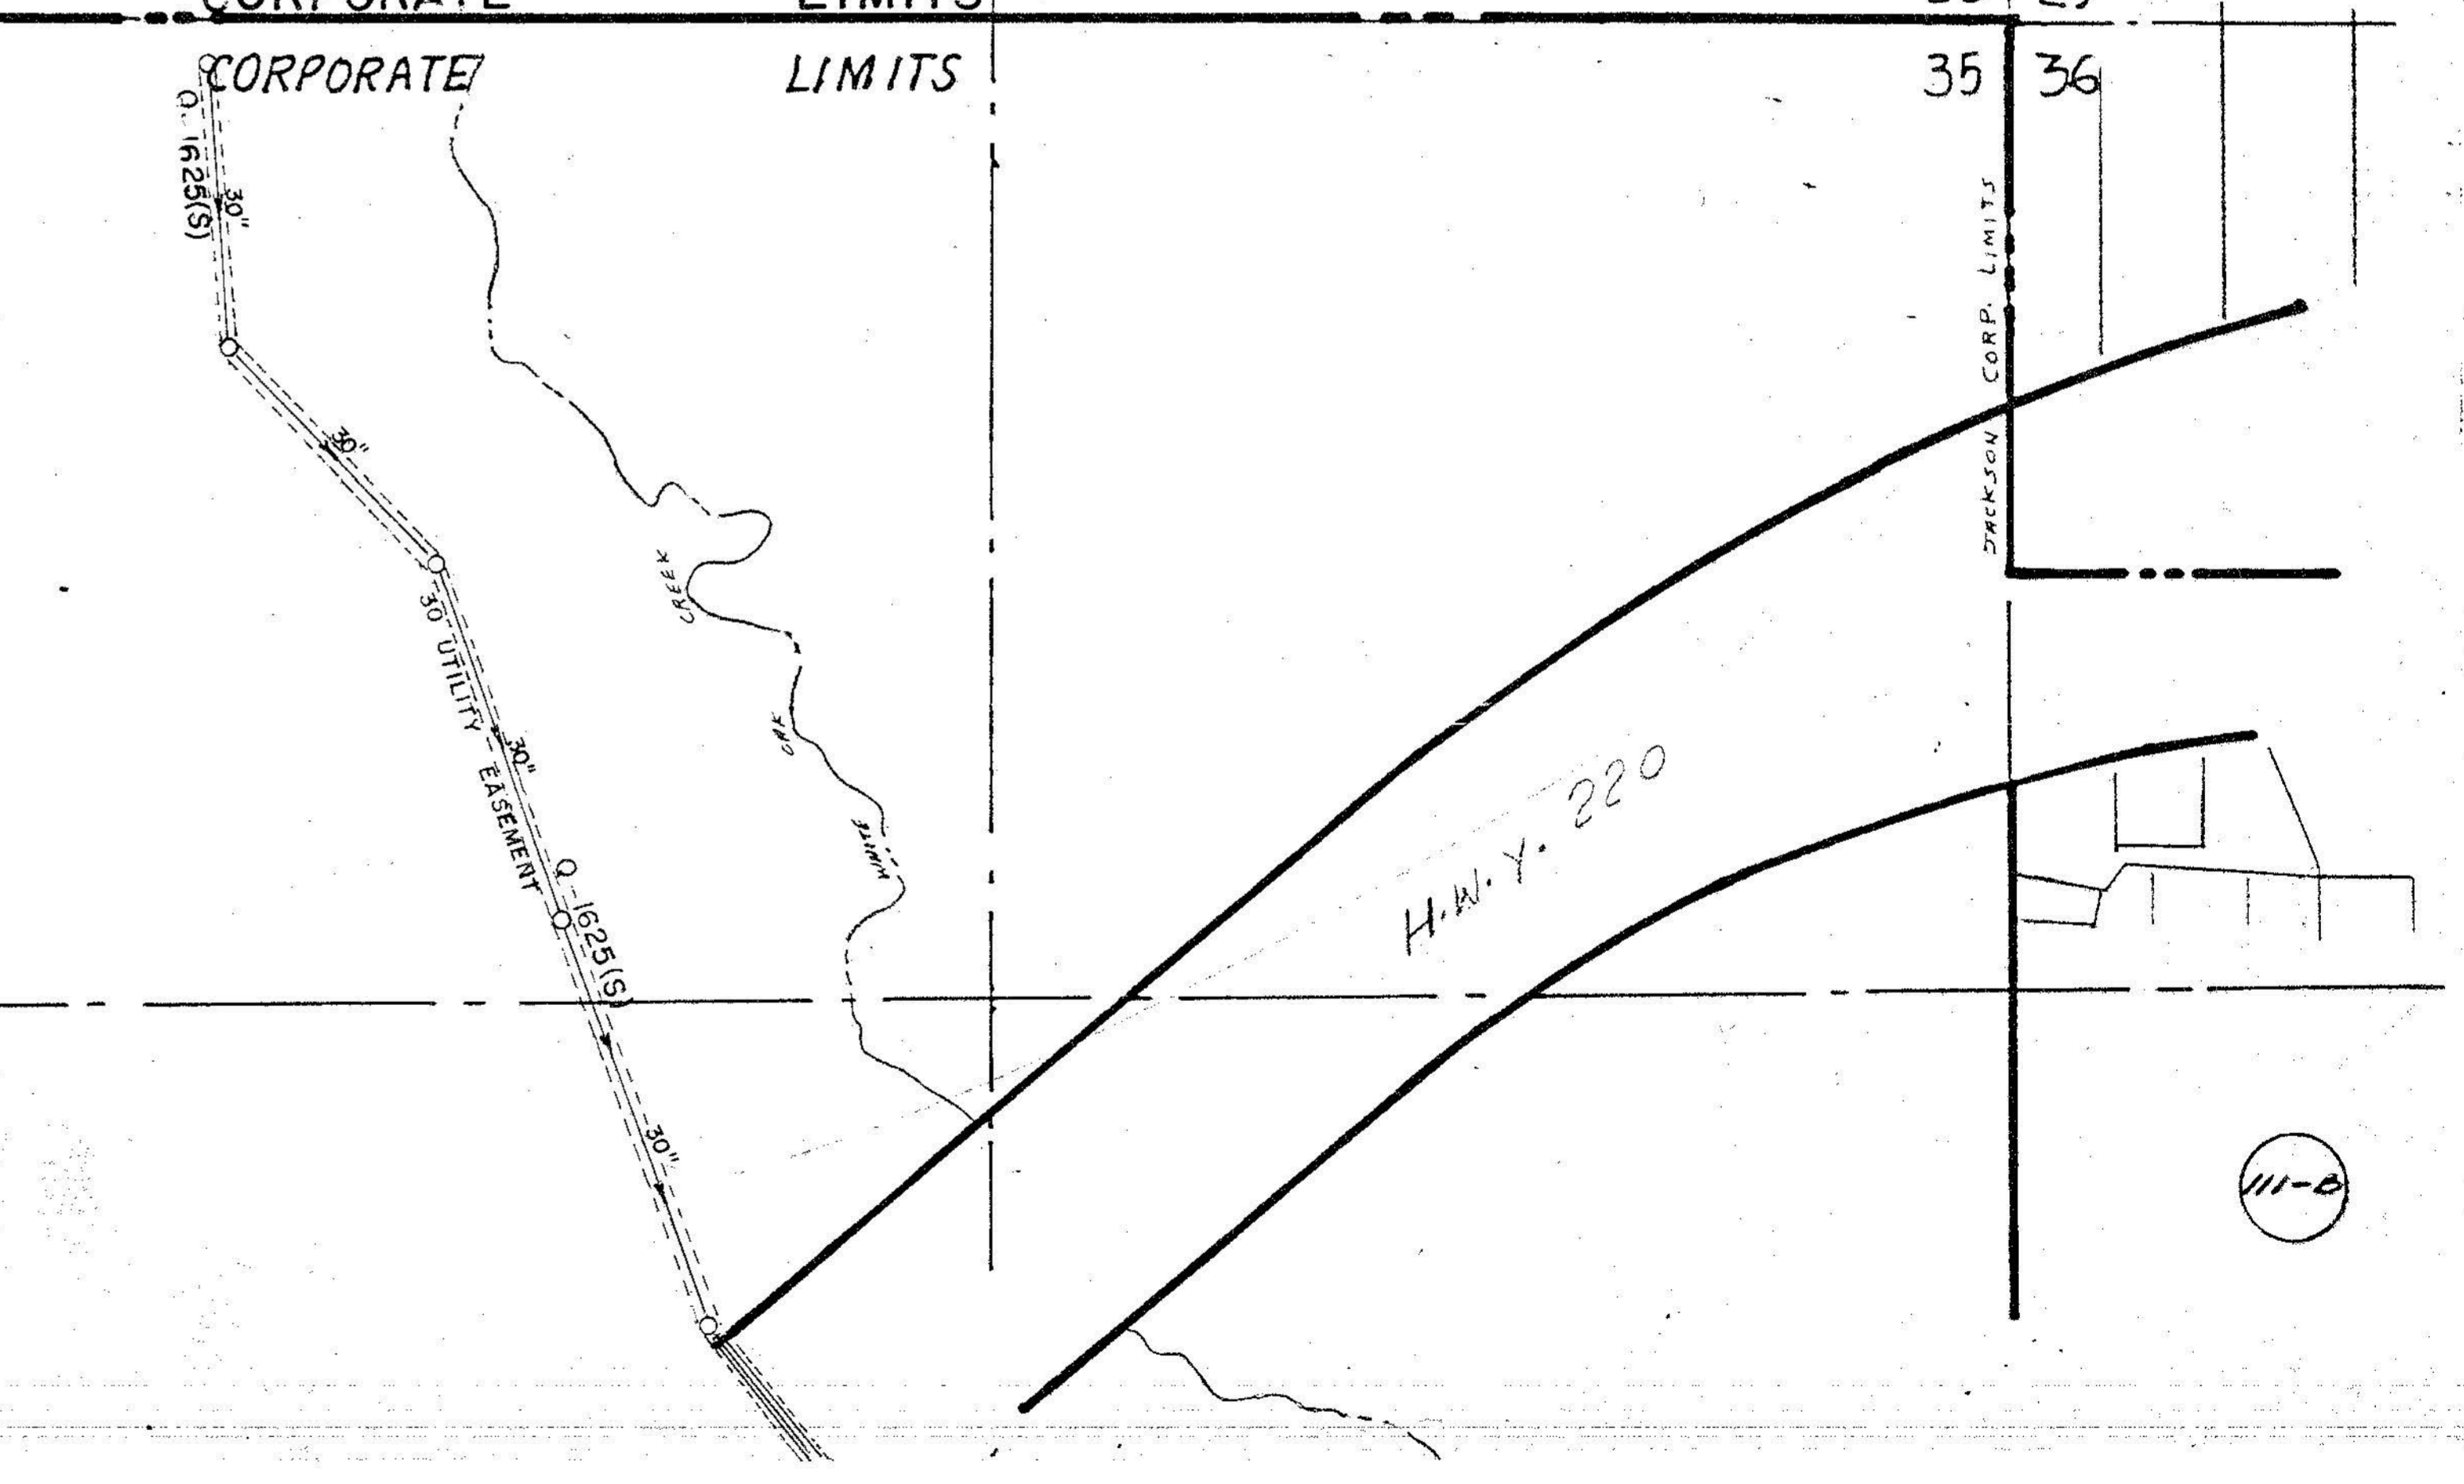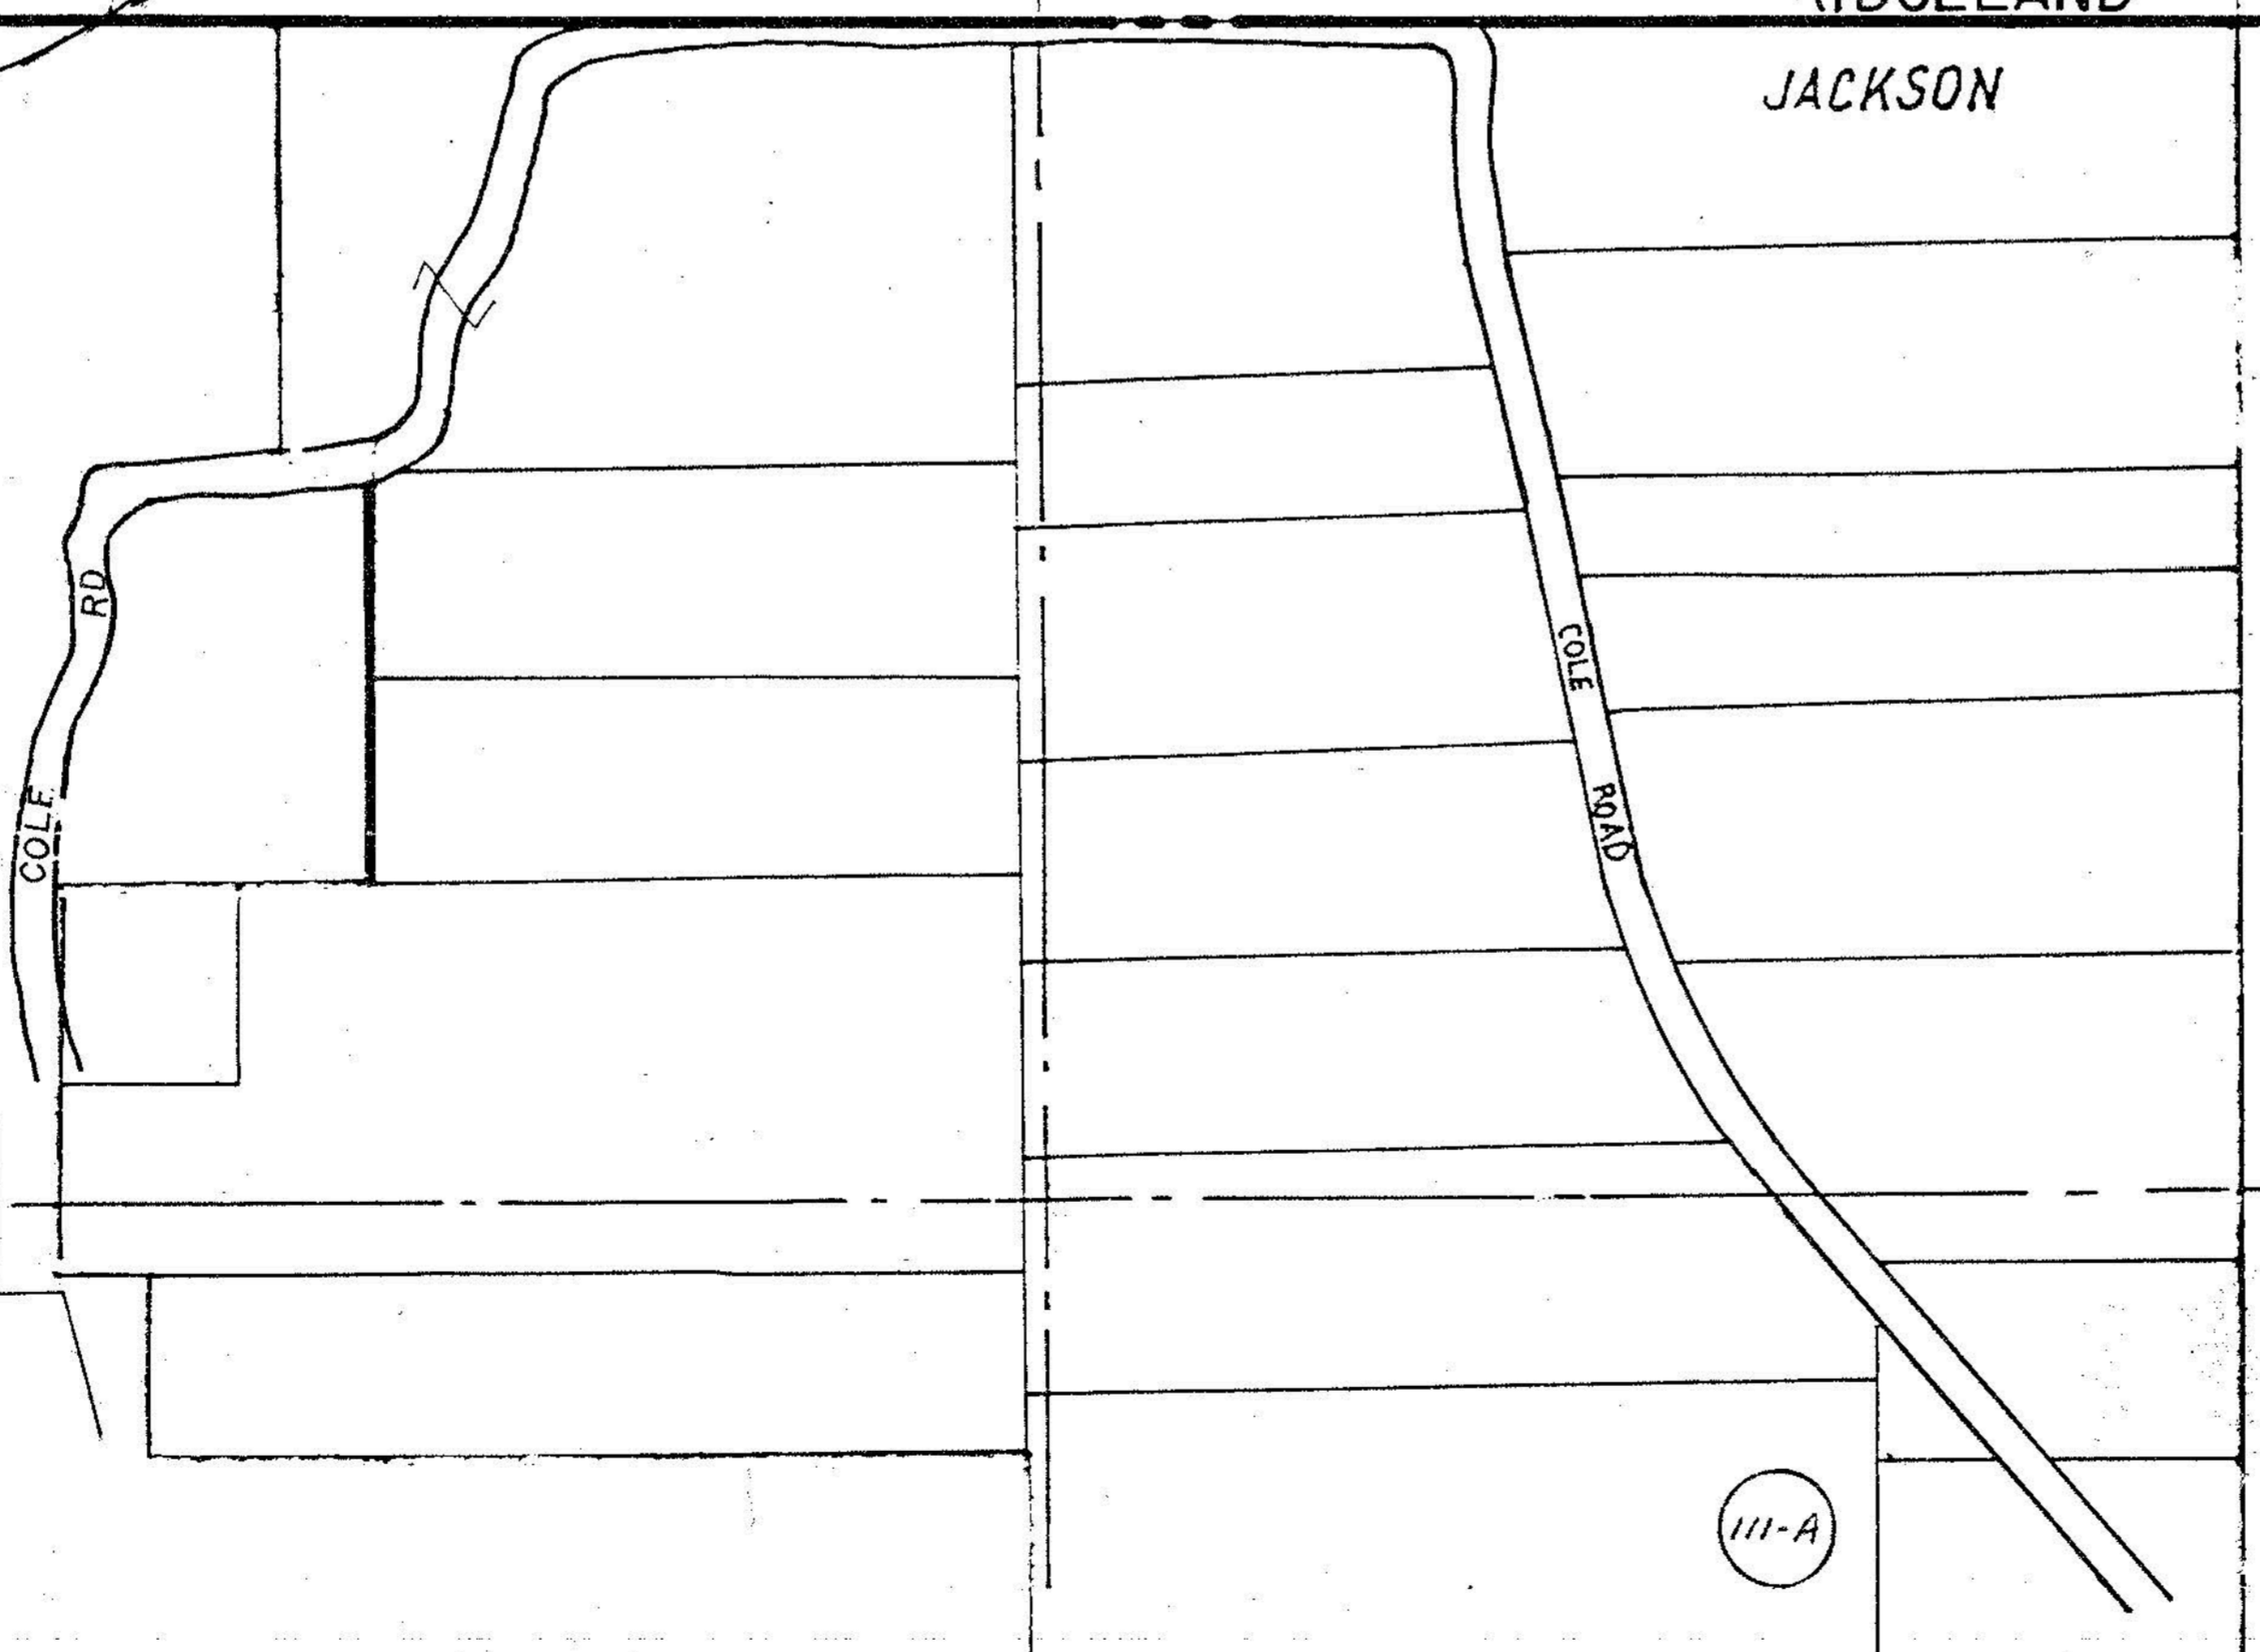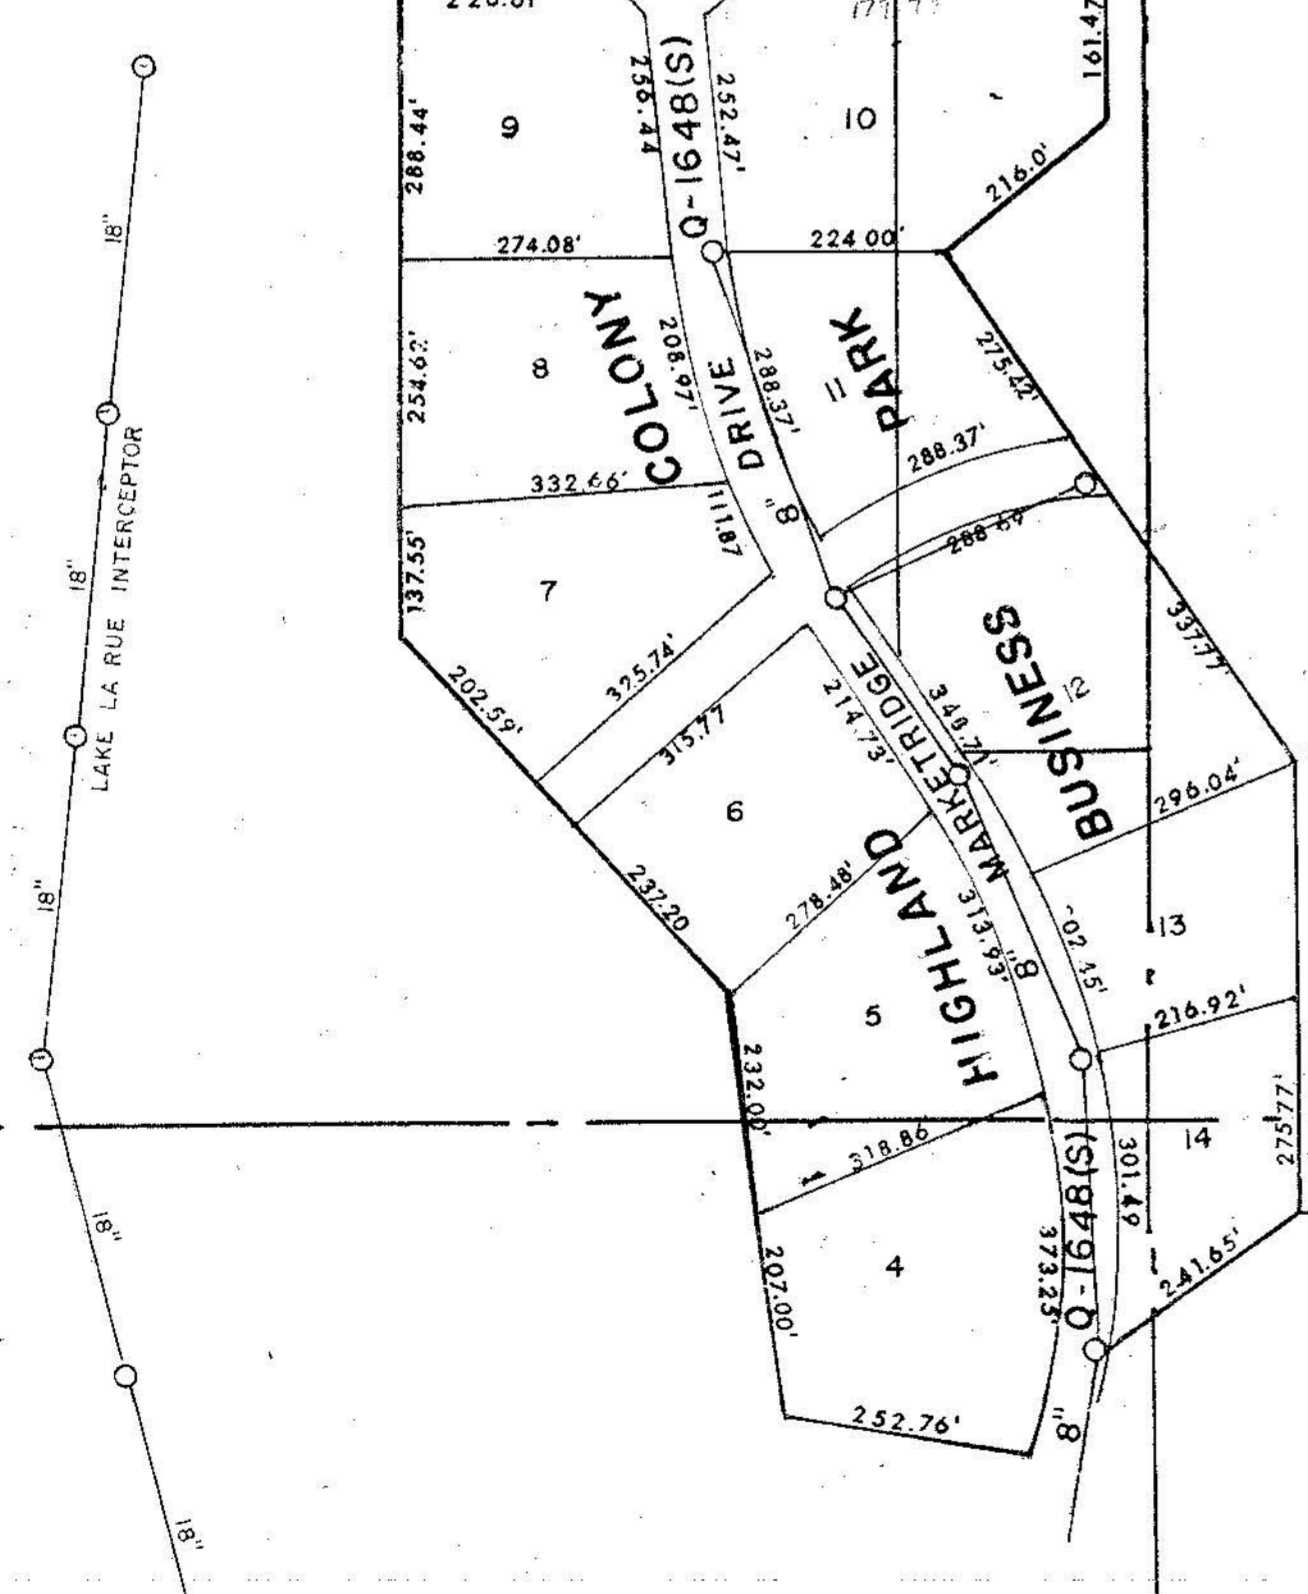

III-A

III-B