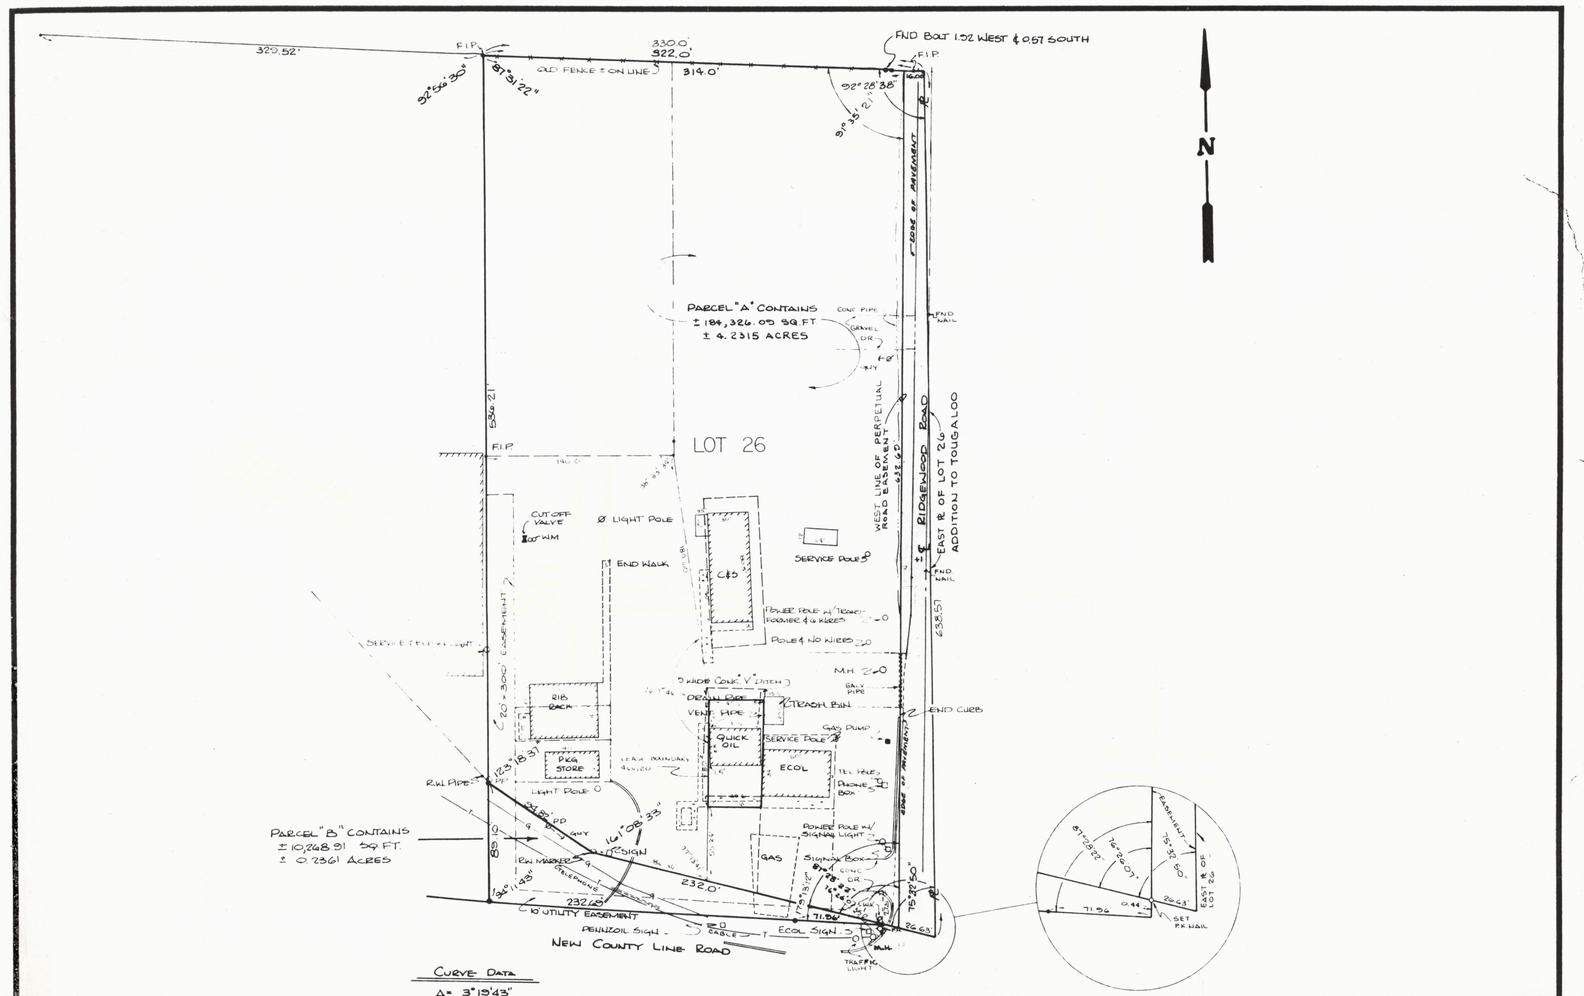

REVISIONS

DATE:	BY:

PLAT OF SURVEY FOR:
BOB DYESS

LOT 26, ADDITION TO TOUGALOO, CITY OF RIDGELAND, MADISON CO MISSISSIPPI

REYNOLDS ENGINEERING, INC. - JACKSON, MISSISSIPPI

DRAWN BY:	DATE:	SCALE:	BOOK & PAGE	JOB NO.
	1-11-84	1" = 50'		84-029