Tee & Values

Fire { Paul Pypas - 8x6
Lee Johnson 8x8 (check)
Alejeria 8x6

Harvey Hanner -

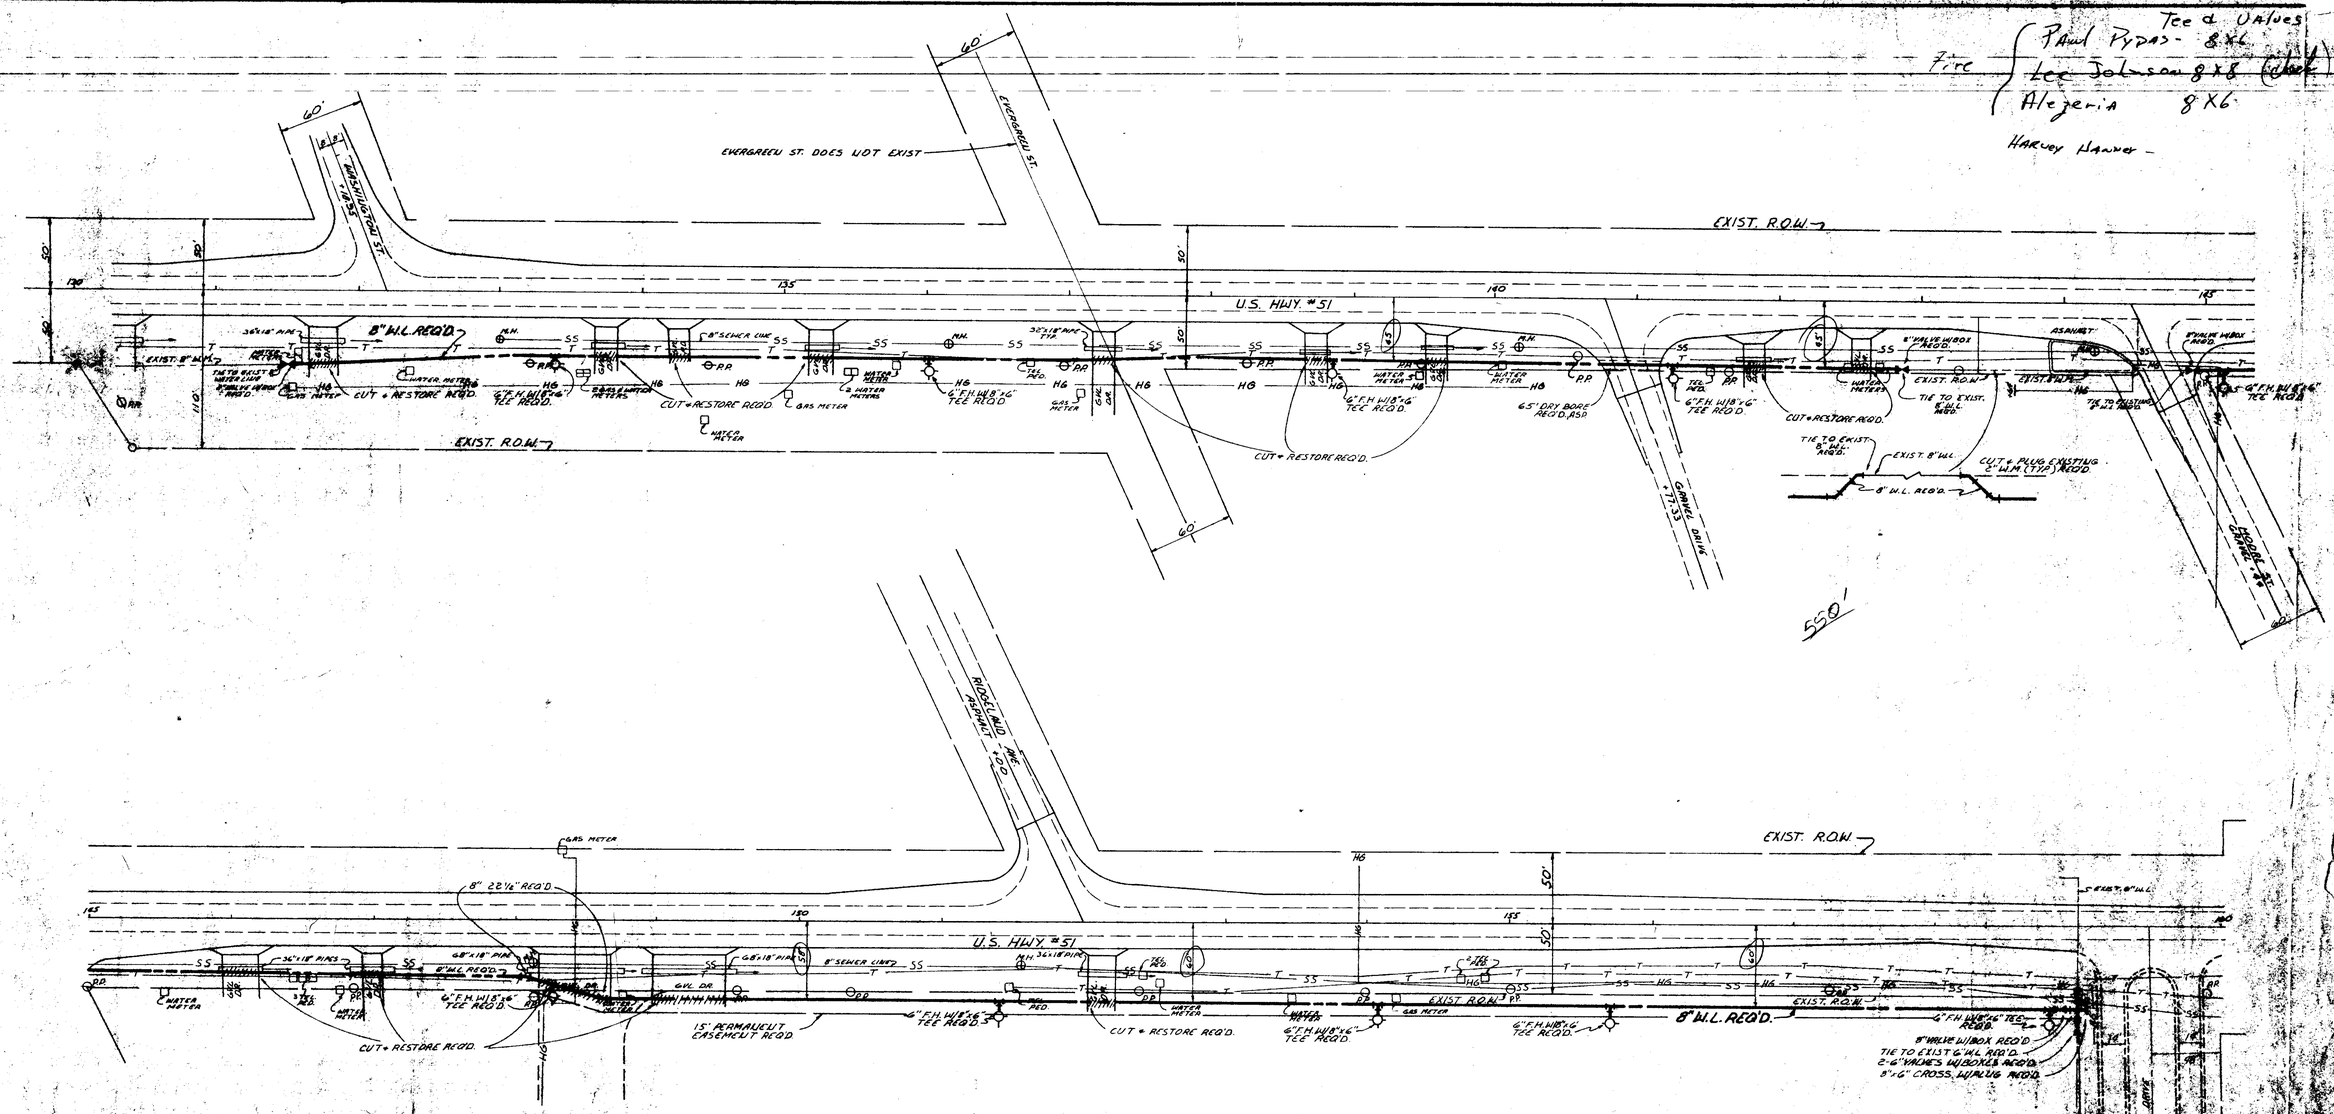

General notes:

1. The existing utility locations shown on these plans are approximate only. The Contractor shall determine the location of all underground utilities before beginning any excavation. Call ... (illegible) ... for assistance in locating all underground utilities.
2. All utility lines disrupted during construction, including water or gas service lines, shall be repaired by the Contractor at no cost to the City.
3. ... (illegible) ... shall be responsible for any damage to existing utilities caused by his operations during this construction.
4. The Contractor shall comply with all rules and regulations governing excavation, trenching, and shoring as set forth by the Occupational Safety and Health Act (OSHA). Any trench or excavation that is 5 feet or more in depth shall be shored or sloped in accordance with the requirements of OSHA. Failure to do so will result in the suspension of work by the Engineer.
5. Pavement breaking shall be performed with care to prevent damage beyond the limits of the pavement to be removed. Pavement damaged beyond the limits shown on the plans shall be repaired at the Contractor's expense.
6. The Contractor shall maintain adequate ... (illegible) ... during the progress of the project.
7. All pavement replacement shall have minimum 28" groove.
8. The Contractor shall be responsible for completing all grading and shaping of easements, and for disposing of spoil in accordance with ... (illegible) ... Spoil shall not be placed on private property without written permission from the property owner. Such permission shall be submitted to the Engineer. This permission shall be in addition to ... (illegible) ... by the Engineer.
9. The Contractor shall furnish to the Engineer copies of manufacturers specifications for all water and sewer piping, storm sewer pipe, concrete, valves, fittings, hydrants, and any and all other materials which shows that the subject material meets the requirements of these plans and specifications. Any material, pipe, valve, fitting, or part, the physical ... (illegible) ... of which does not meet the requirements of these plans and specifications shall be rejected by the Engineer and shall be removed from the work by the Contractor prior to inspection or the subject of any payment by the Owner.
10. All Tees to be installed with bends.
11. Contractor to switch all existing services to 8" water main after successful completion of pressure and bacteriological testing.
12. Contractor to repair and maintain driveways at no expense to owner.
13. Only those fittings shown on these plans will be measured and paid for unless otherwise approved in writing by the Engineer.
14. Proposed 8" water main will be constructed immediately adjacent to an existing 2" water main. Contractor is to protect 2" water main and services until satisfactory completion of testing and approval or abandonment by the Engineer.

CITY OF RIDGELAND
U.S. HIGHWAY 51
WATER MAIN EXTENSION
JOE A. WAGGONER
Civil Engineer - Surveyor - Planner
Jackson, Mississippi

Designed by: J.A.W.	Date: 7-1-80	Scale: 1" = 40'	Sheet No. 2 of 3
Checked by: J.A.W.	Drawn by: J.A.W.		

PWP-00808