

CONTRACT XI
WATER SYSTEM EXTENSION
AND RELATED FACILITIES
TO SERVE PEAR ORCHARD SQUARE
SUPPLEMENTAL AGREEMENT ONE
PARTS A & B

TOWN OF RIDGELAND
RIDGELAND SERVICE AREA SOUTH
MADISON COUNTY, MISSISSIPPI



VICINITY MAP
SCALE 1"=2000'

MAYOR AND BOARD OF ALDERMEN

D. F. (JACK) McGERMACK, MAYOR

HAROLD E. ADCOCK, ALDERMAN

EUGENE HAWKINS, ALDERMAN

BARBARA J. JOHNSON, ALDERMAN

THERMAN L. HOWARD, ALDERMAN

DONALD E. LINDSLY, ALDERMAN

MARCELLA CANNON, TOWN CLERK

CASE & MONTGOMERY, ATTORNEYS

HARVEY CARR

MAINTENANCE SUPERINTENDENT




LESTER ENGINEERING CO.
JACKSON, MISS.

2407



NOTES
 FOR WATER DISTRIBUTION SYSTEM CONSTRUCTION
 DETAILS, SEE SHEET NO. 3

PLAN: 12" WATER MAIN
 SCALE: 1"=100' HORIZ.
 1"=10' VERT.

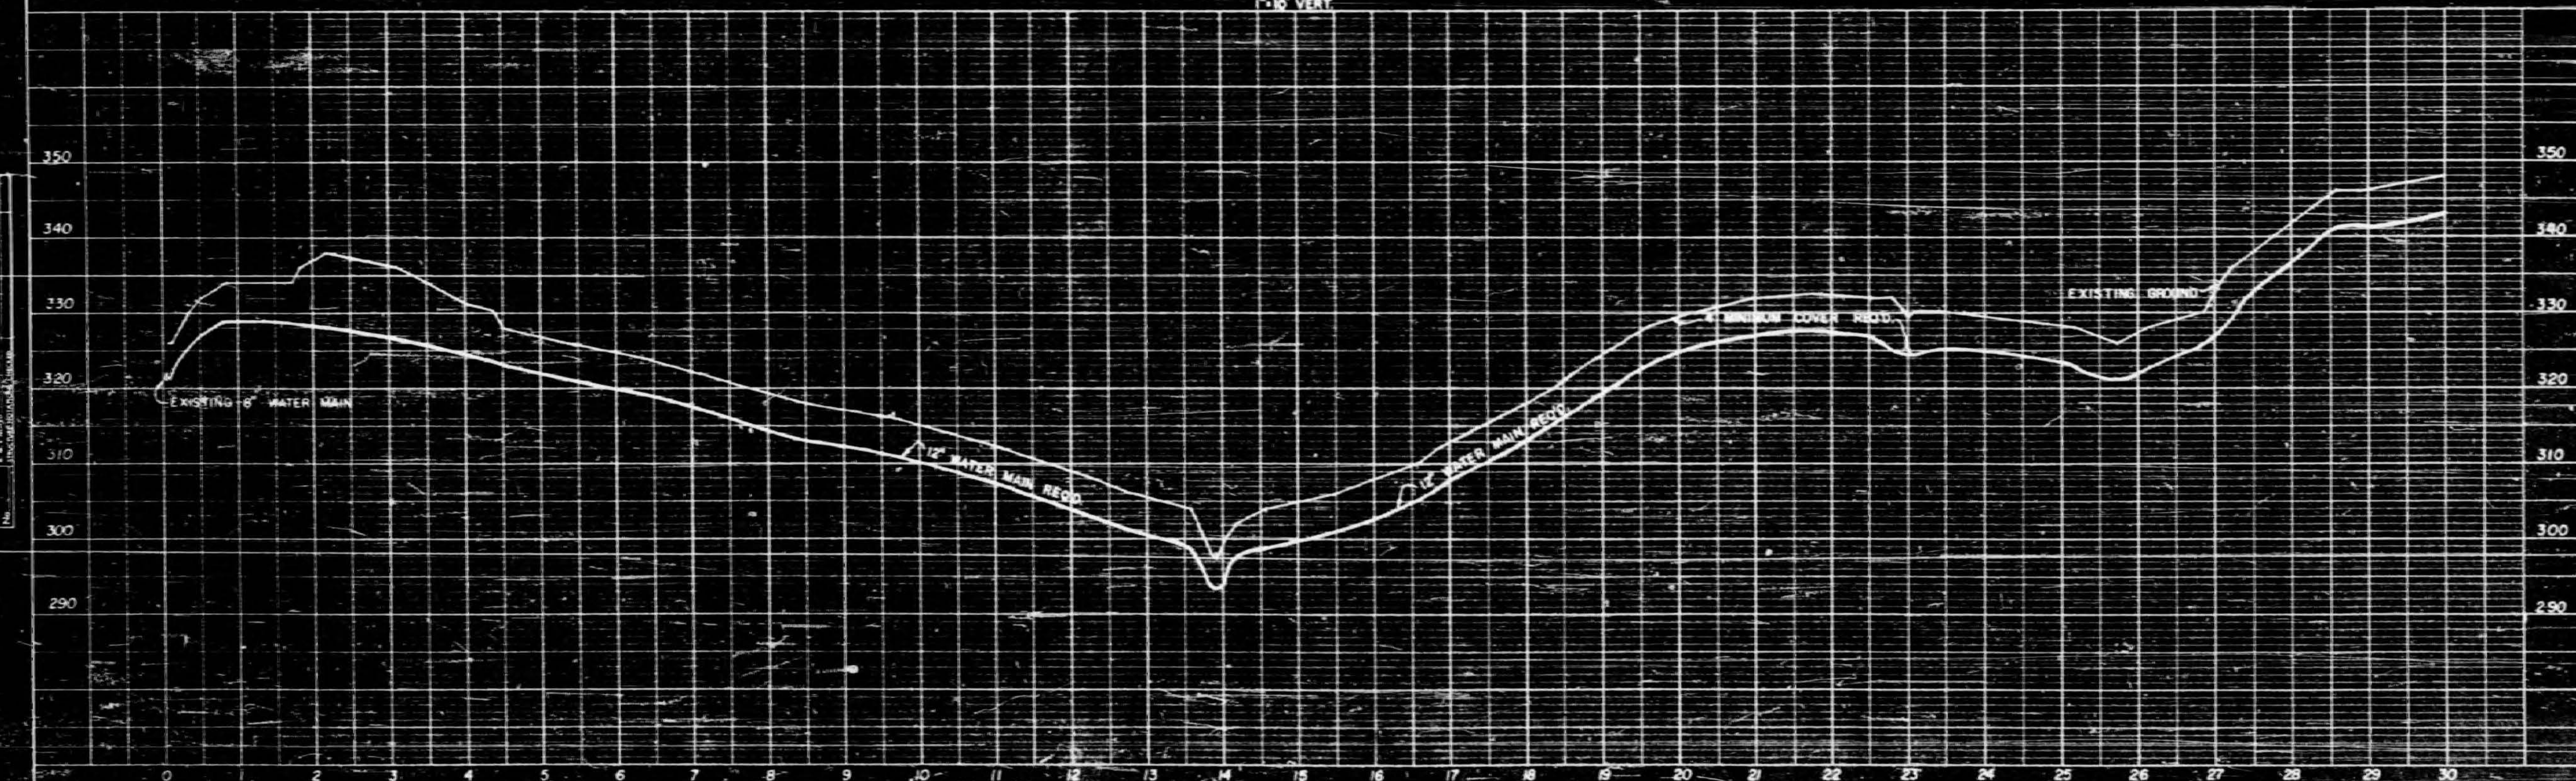


PROFILES: PLAN/PROFILE
 SCALE: 1"=100' HORIZ.
 1"=10' VERT.






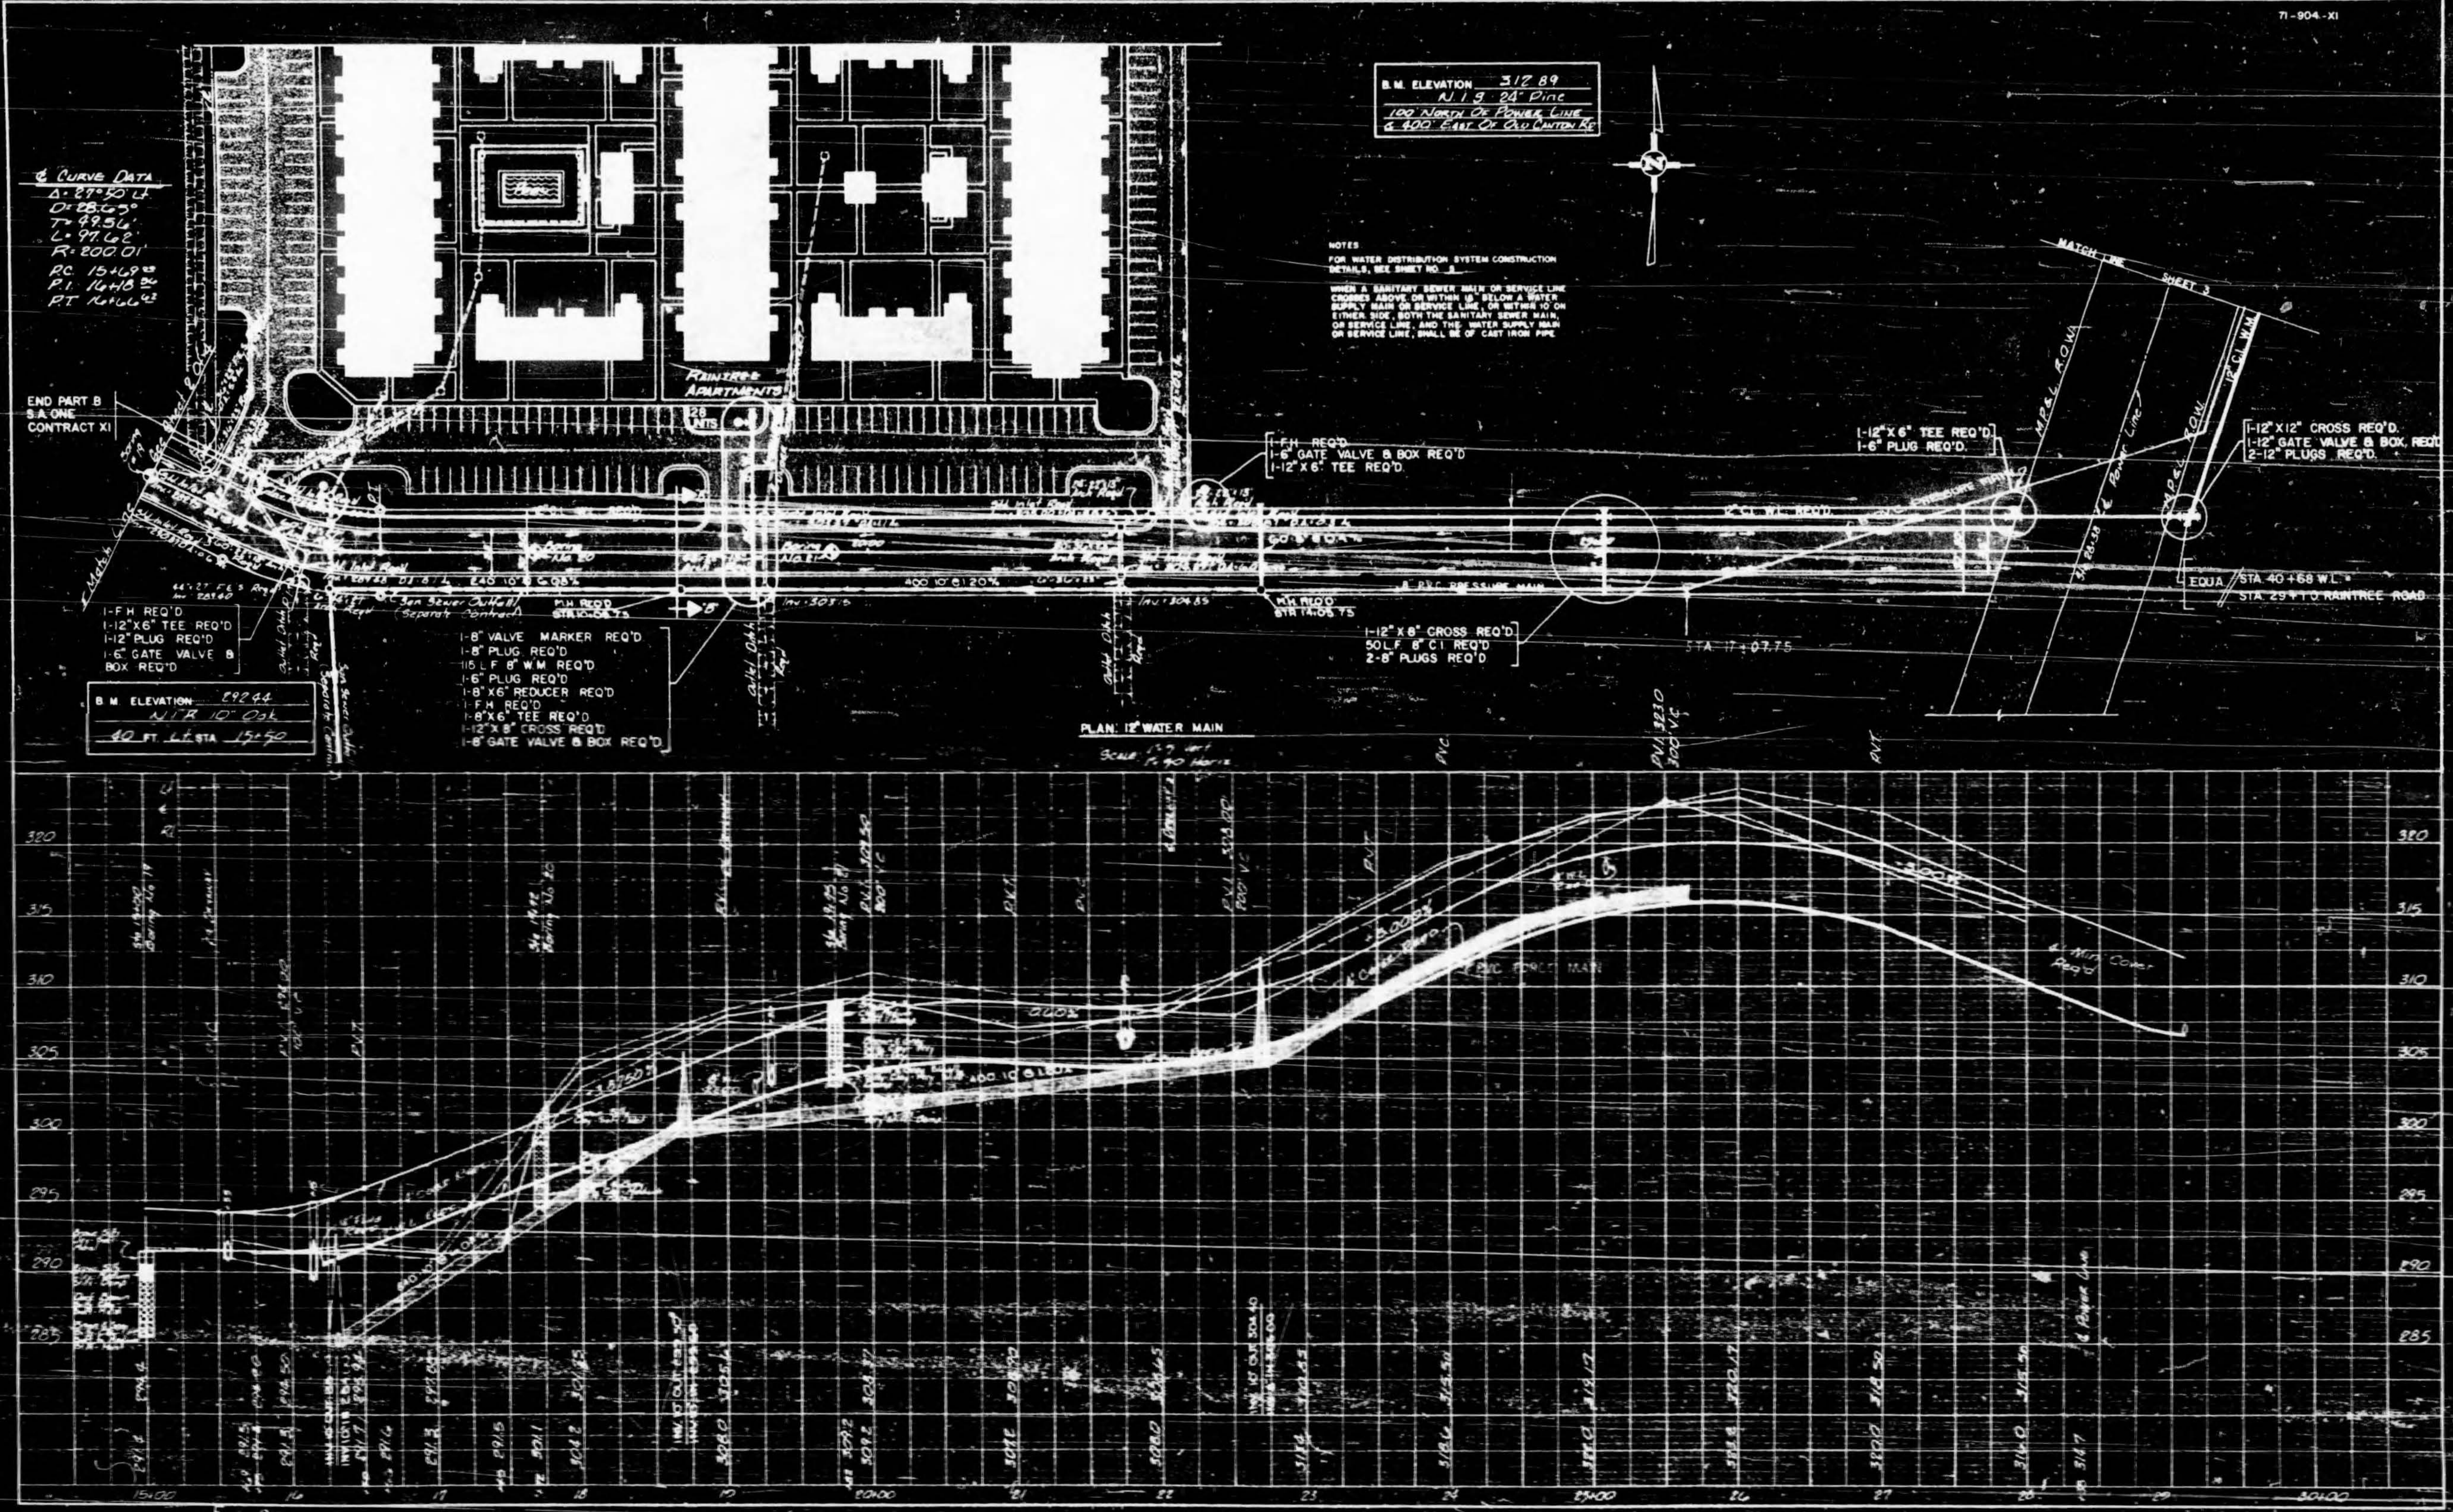

CURVE DATA

NO.	DATE	REVISION
1		ISSUED
2		REVISED
3		REVISED
B.M. ELEVATION 292.44

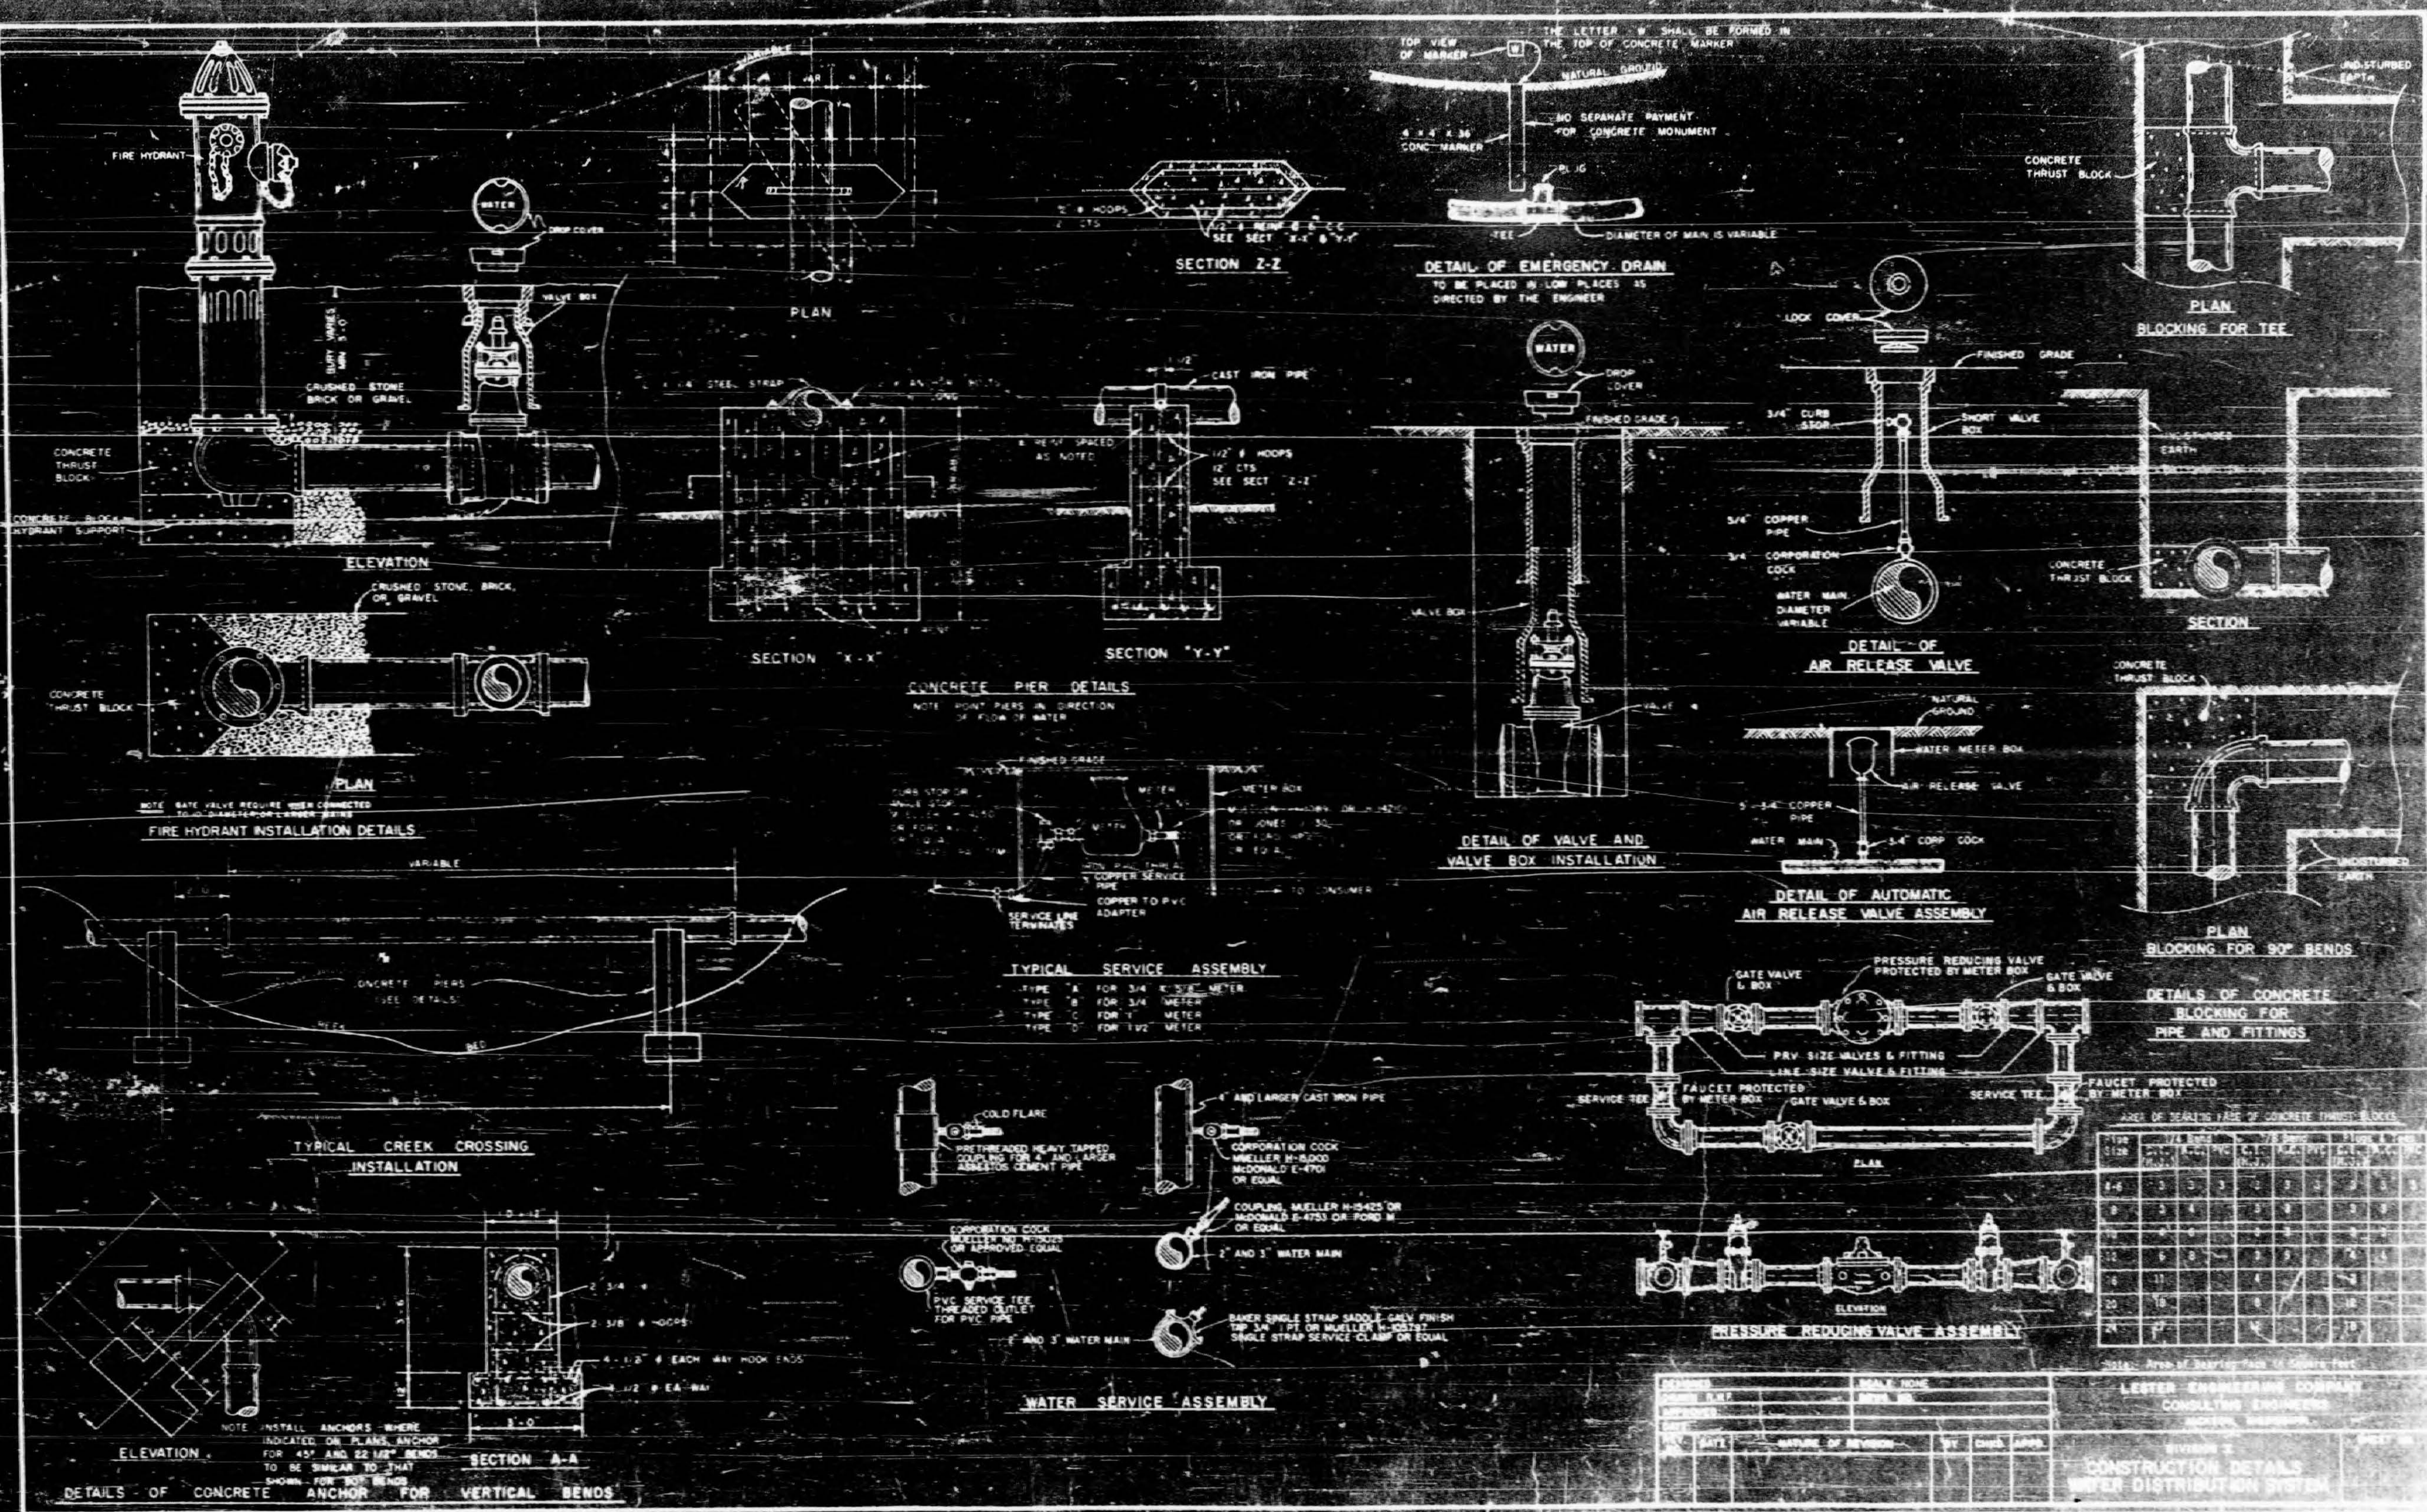


CONCRETE PIER DETAILS
NOTE: POINT PRESS IN DIRECTION OF FLOW OF WATER

TYPICAL SERVICE ASSEMBLY
TYPE "A" FOR 3/4" & 1" METER
TYPE "B" FOR 3/4" METER
TYPE "C" FOR 1" METER
TYPE "D" FOR 1 1/2" METER

DETAILS OF CONCRETE ANCHOR FOR VERTICAL BENDS


NO.	DATE	NATURE OF REVISION	BY	CHKD.	APP'D.

LESSER ENGINEERING COMPANY
CONSULTING ENGINEERS

CONSTRUCTION DETAILS
WATER DISTRIBUTION SYSTEM