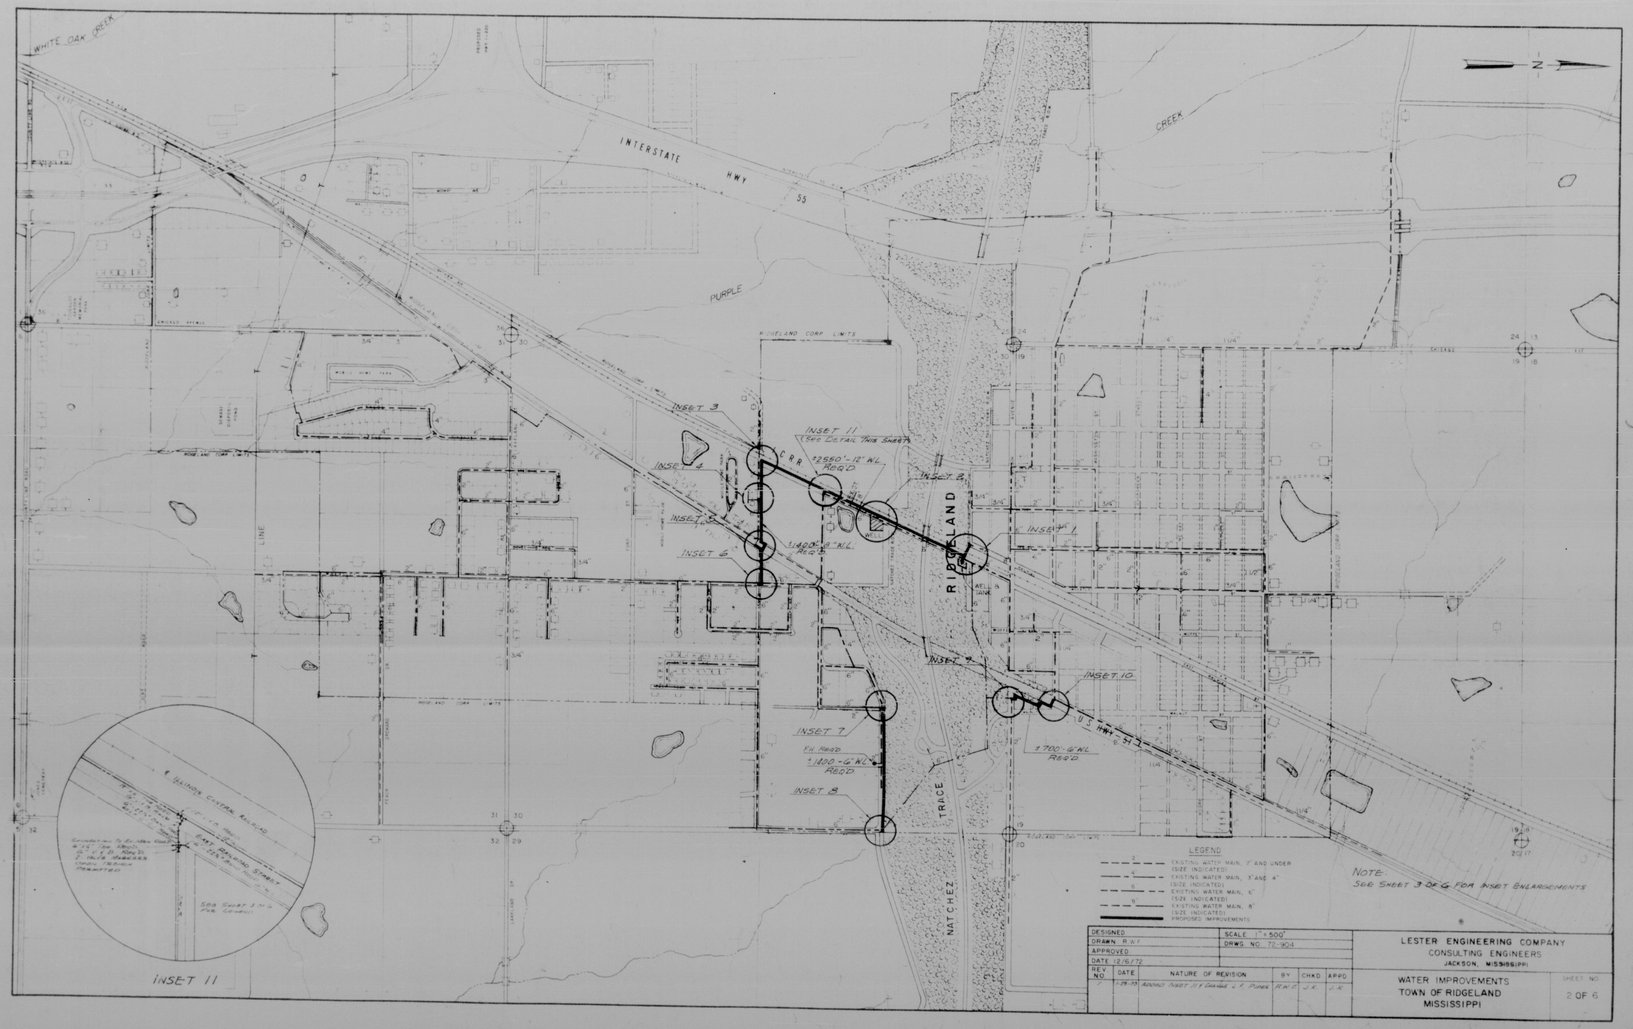
WHITE OAK CREEK
INTERSTATE HWY 55
PURPLE
CREEK
RIDGELAND CORP. LIMITS
INSET 1
INSET 2
INSET 3
INSET 4
INSET 5
INSET 6
INSET 7
INSET 8
INSET 9
INSET 10
INSET 11
(See Detail This Sheet)
12560'-12" W.L. Road
1400'-8" W.L. Road
1400'-6" W.L. Road
3700'-6" W.L. Road
RIDGELAND
NATCHEZ TRACE
ILLINOIS CENTRAL RAILROAD
EAST JEFFERSON STREET
SEE SHEET 3 OF 6 FOR DETAIL
N
LEGEND
EXISTING WATER MAIN, 3" AND UNDER (SIZE INDICATED)
EXISTING WATER MAIN, 5" AND 4" (SIZE INDICATED)
EXISTING WATER MAIN, 6" (SIZE INDICATED)
EXISTING WATER MAIN, 8" (SIZE INDICATED)
PROPOSED IMPROVEMENTS
NOTE
See Sheet 3 of 6 for Inset Enlargements
DESIGNED
DRAWN R.W.F.
APPROVED
DATE 12/6/72
SCALE 1" = 500'
DWG. NO. 72-903
REV. NO.
DATE
NATURE OF REVISION
BY
CHKD
APPD
1-9-73 Added Inset 11 & Corrected L.P. Points R.W.F. J.C.
LESTER ENGINEERING COMPANY
CONSULTING ENGINEERS
JACKSON, MISSISSIPPI
WATER IMPROVEMENTS
TOWN OF RIDGELAND
MISSISSIPPI
SHEET NO.
2 OF 6

E 10

E